


State Highway Route No. 40096

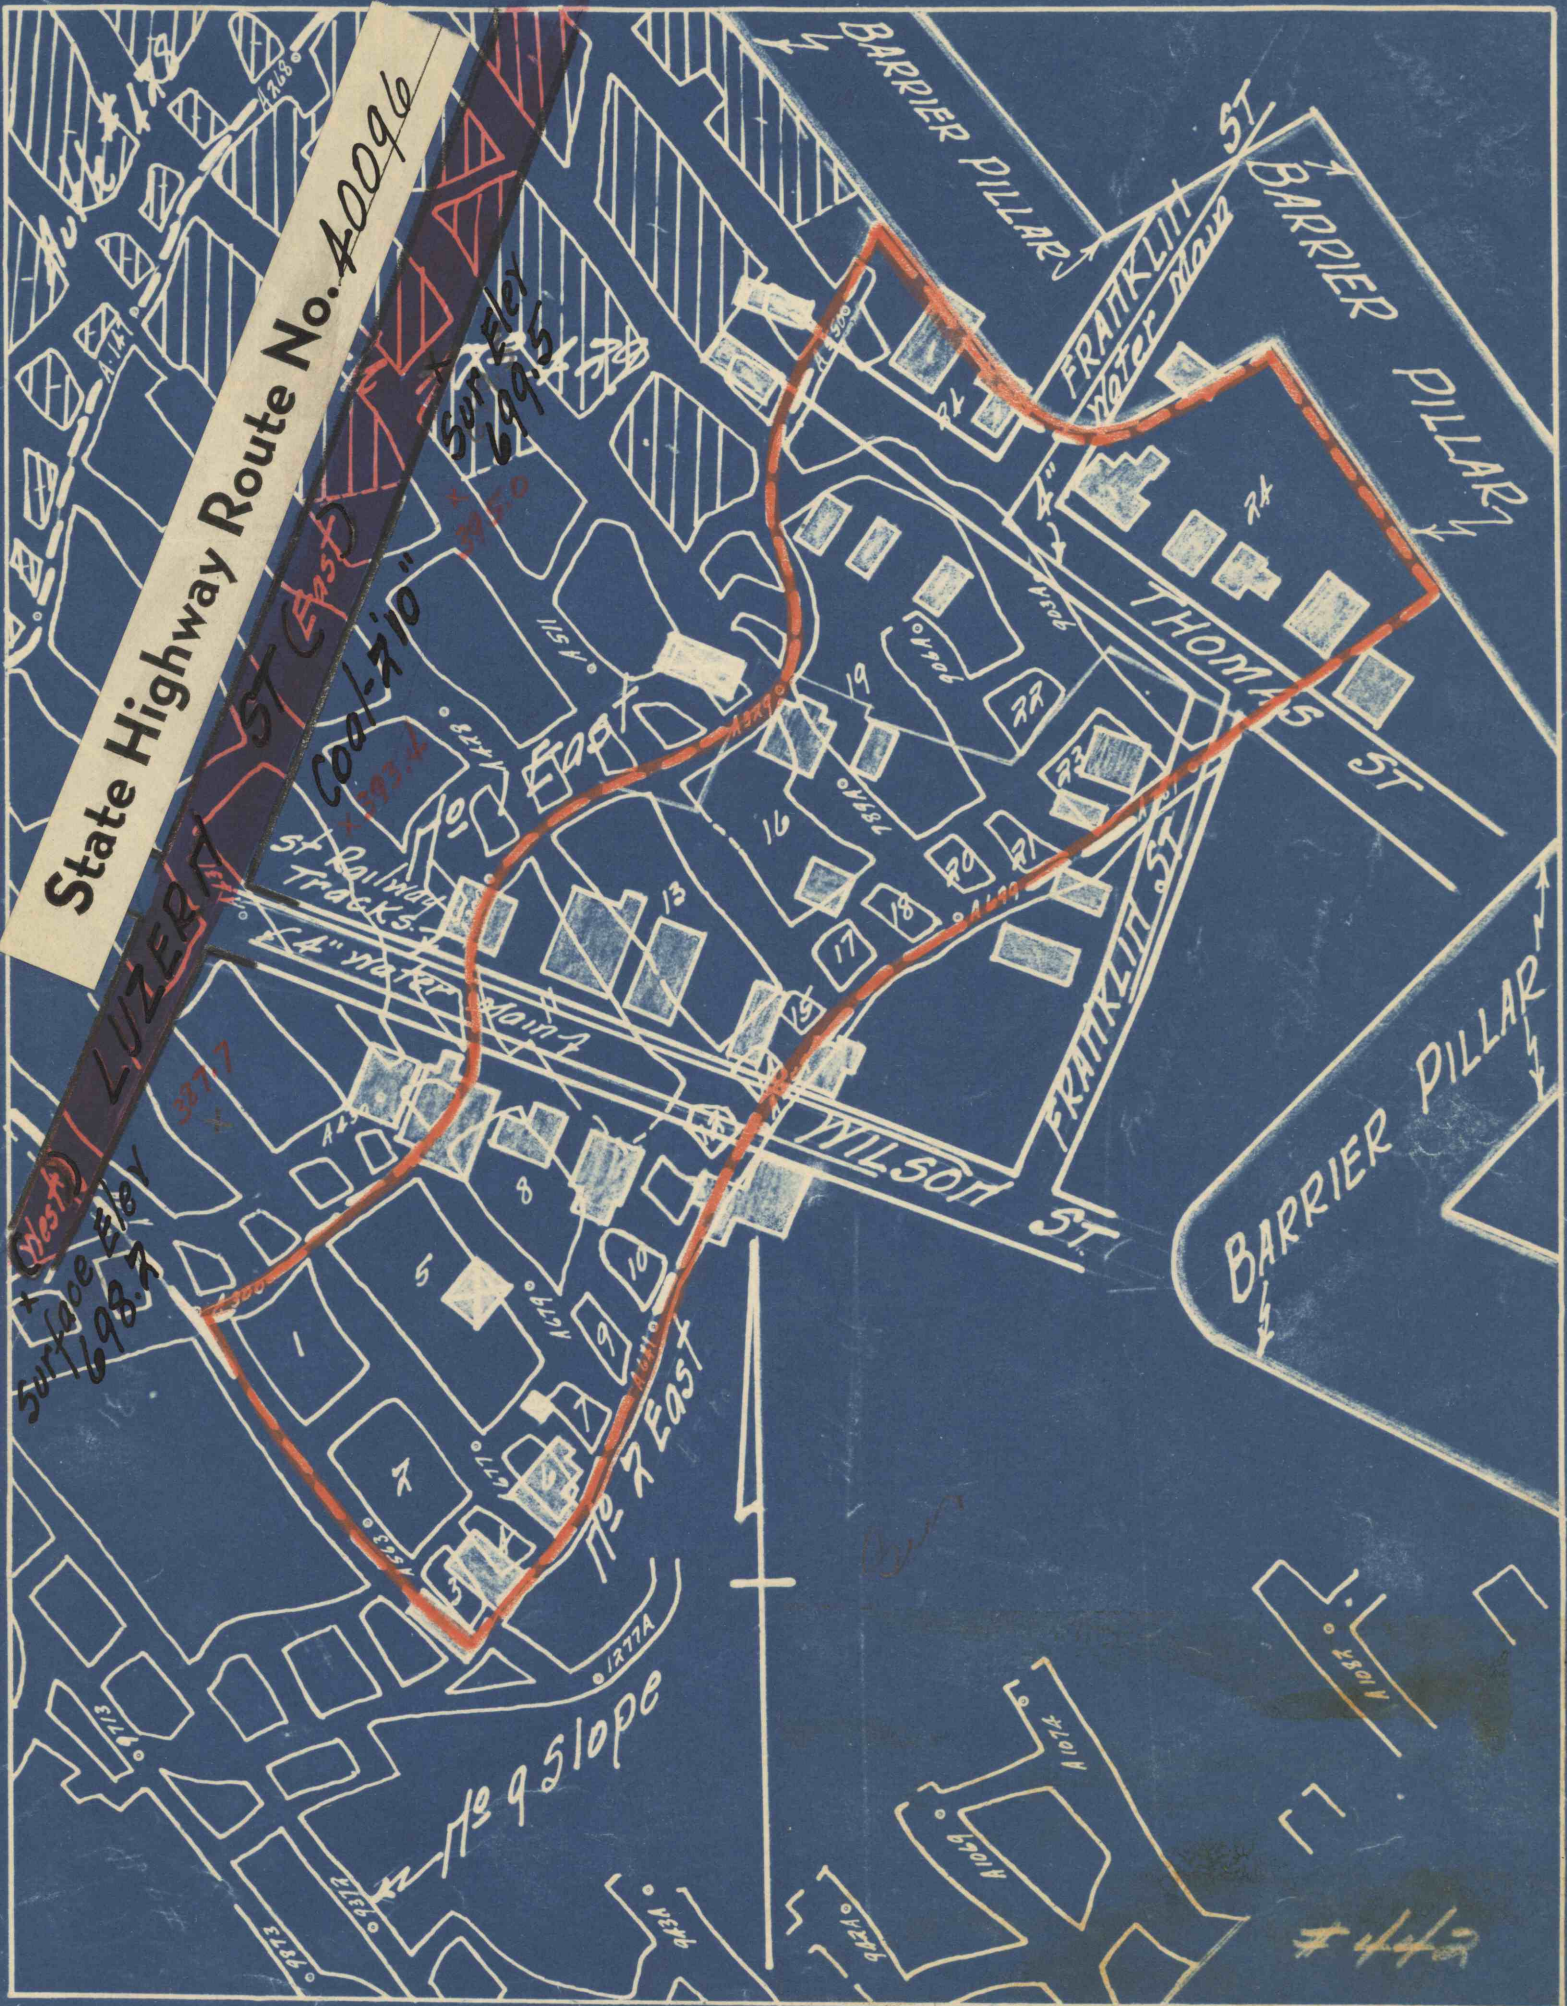

#442