


State Highway Route No. 40096

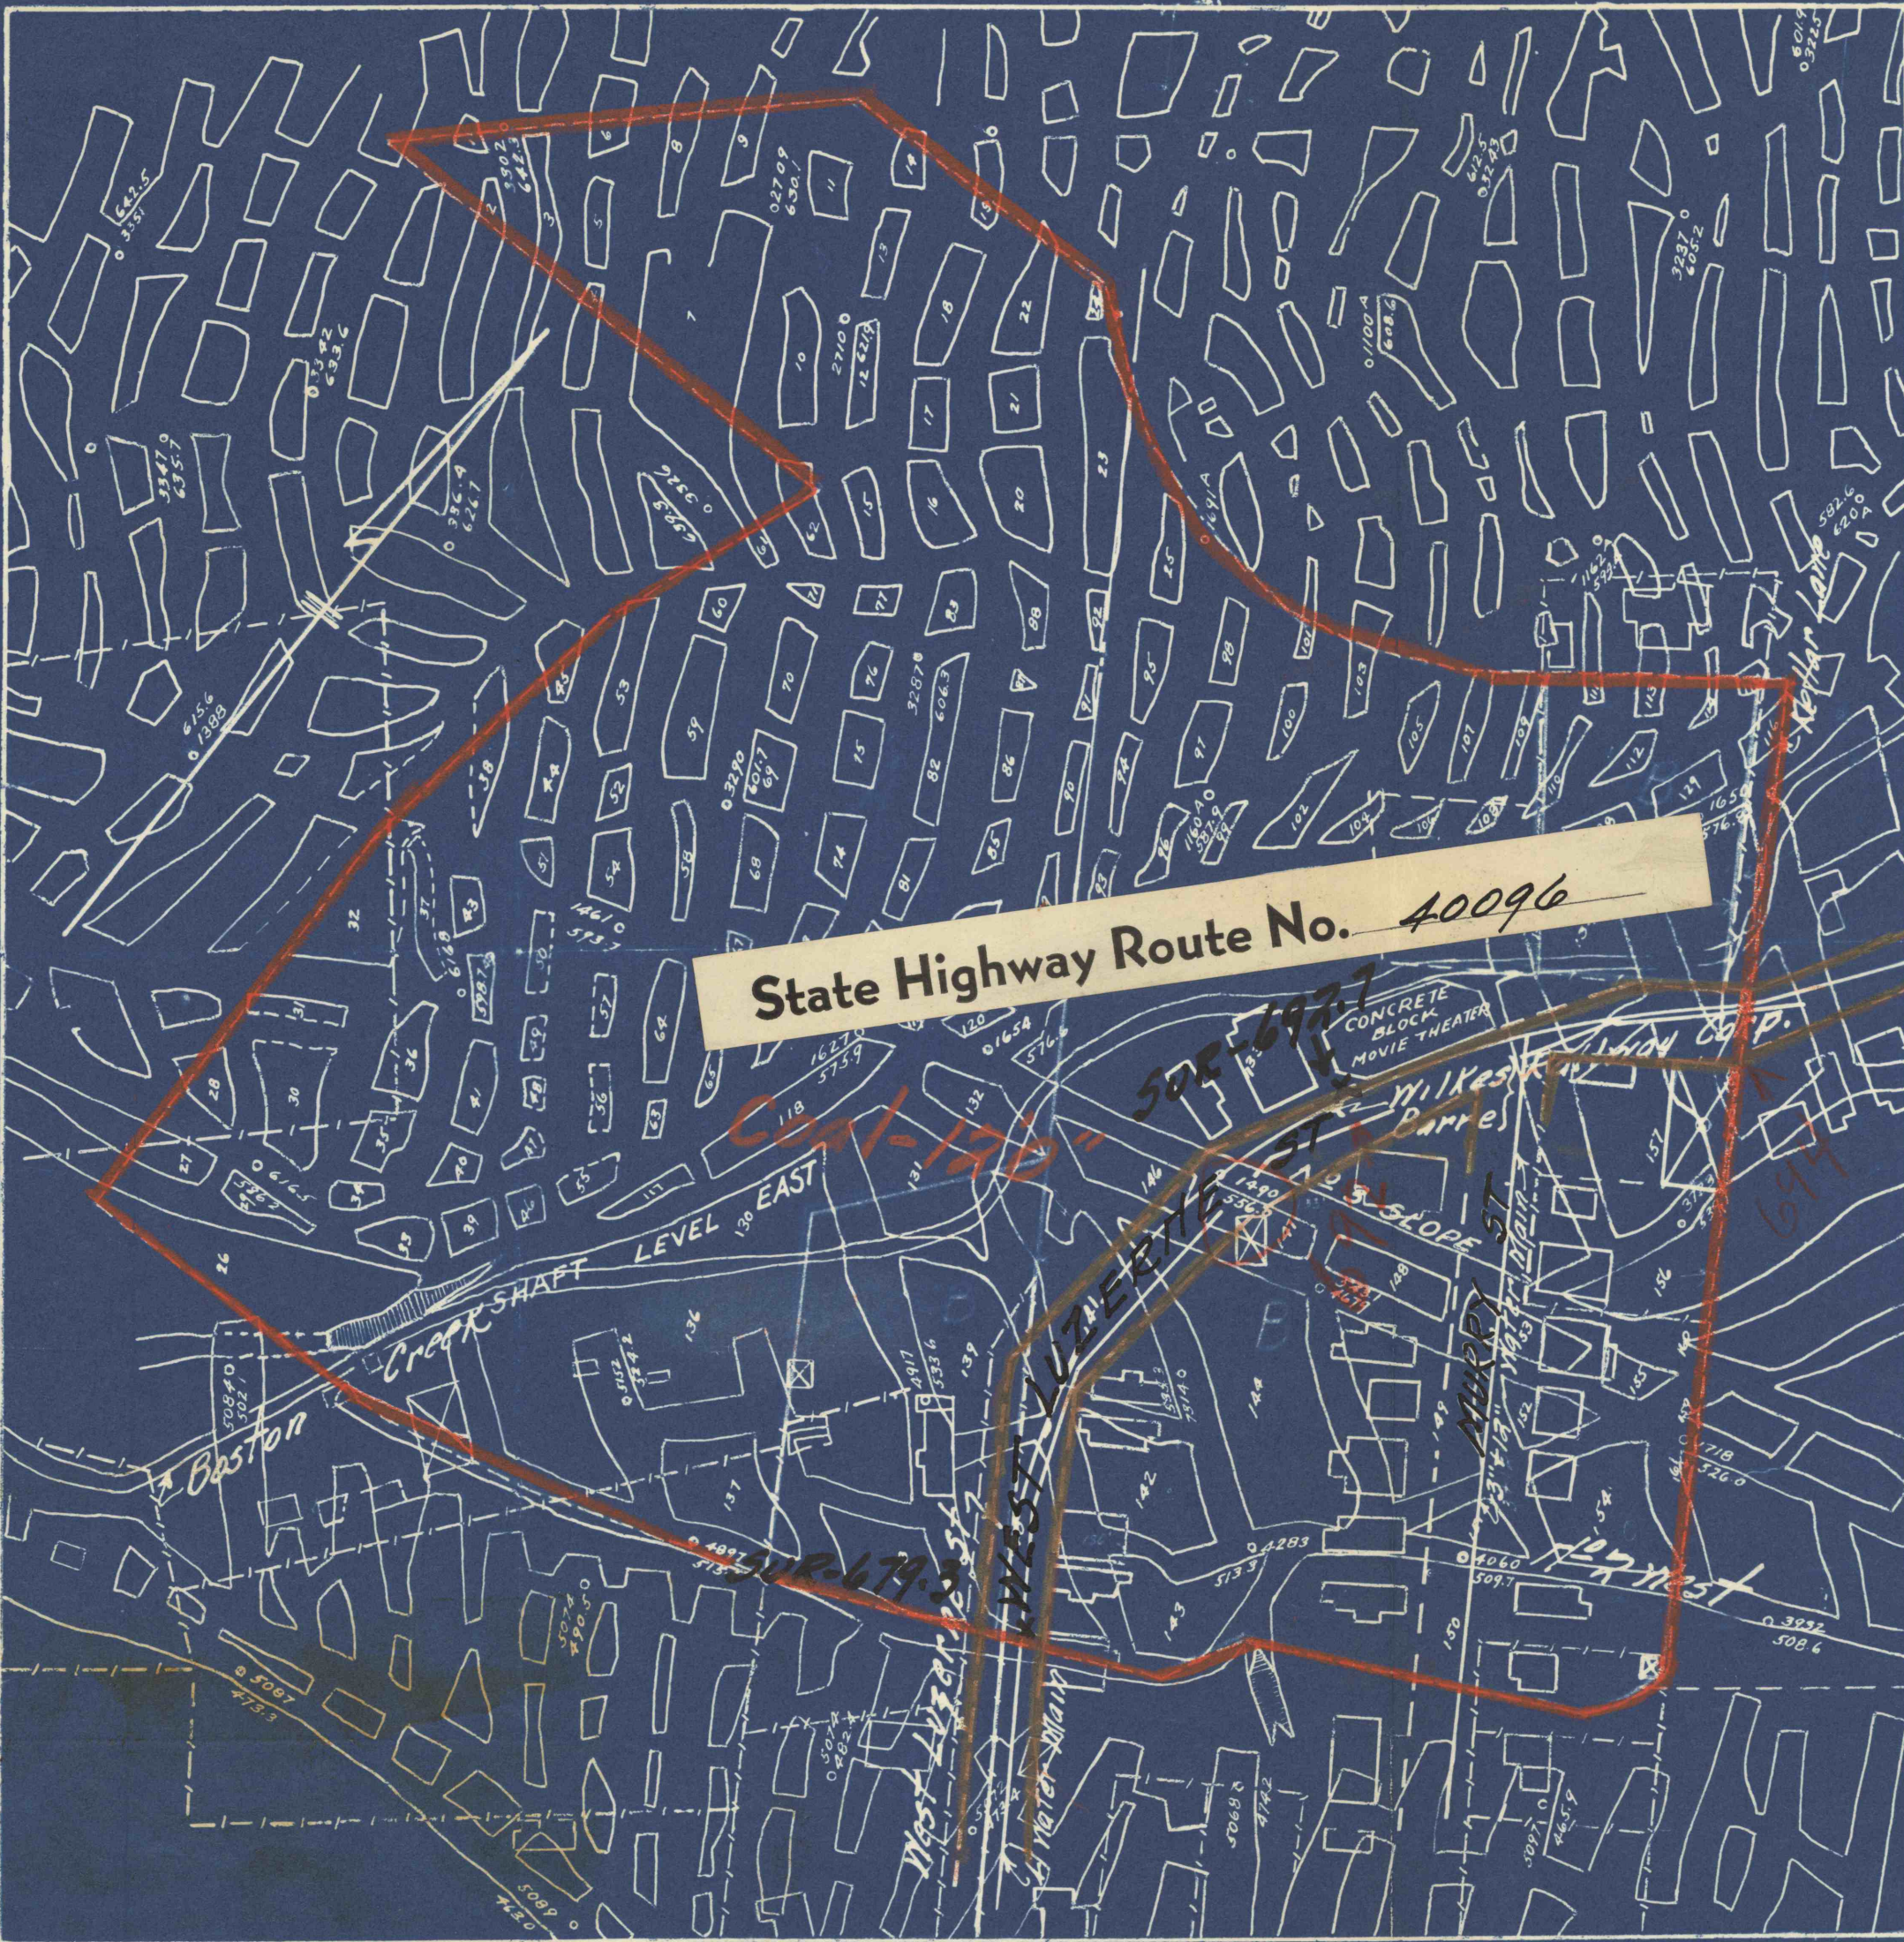


*SUR-697-7*

*BOSTON*

*Creek Shaft*

*LEVEL 130 EAST*

*CONCRETE BLOCK MOVIE THEATER*

*WILKESBARR*

*DARRE*

*SLOPE ST*

*MURPHY*


*WATER MAIN*

