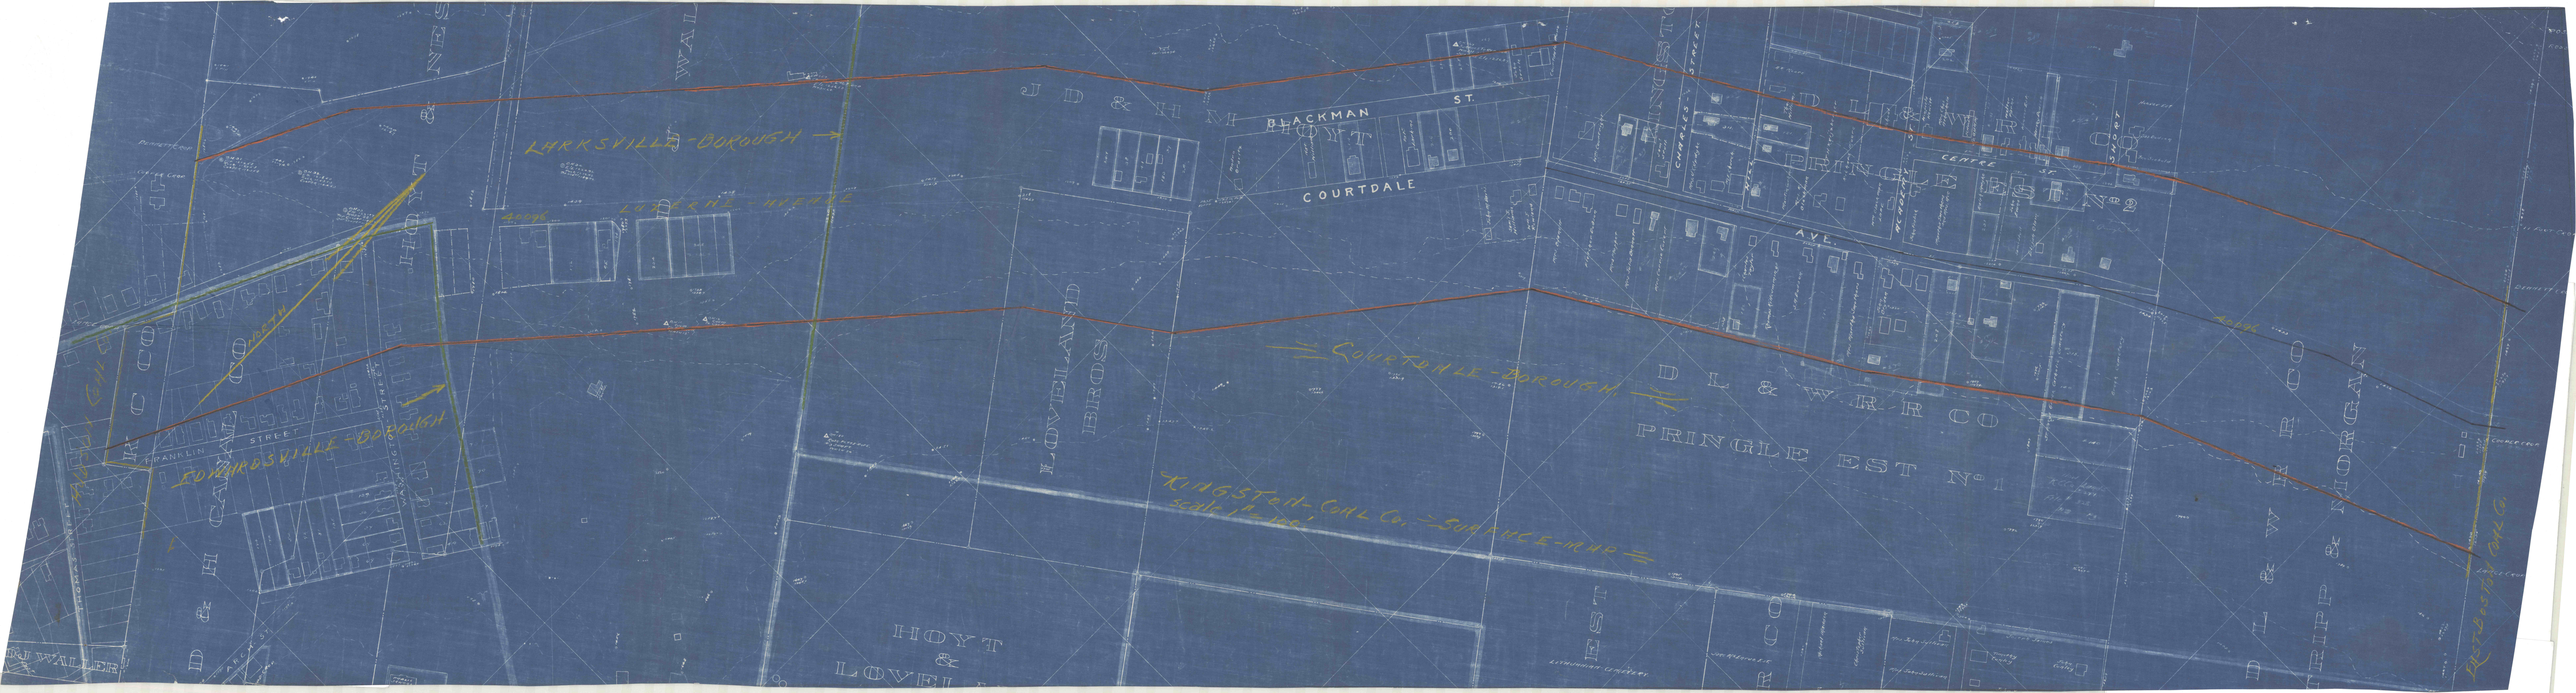
LARKSVILLE - BOROUGH
LUZERNE - AVENUE
BLACKMAN ST.
COURTDALE
COURTDALE - BOROUGH
FRANKLIN STREET
LOVELAND BROS.
HOYT & LOVELAND
KINGSTON COAL CO. - SURFACE MAP
Scale 1" = 200'
D L & W R R CO
PRINGLE EST N° 1
CENTRE ST.
AVE.
CHARLES STREET
HOYT
WALLER
CAMPBELL
MORGAN
EAST BOSTON COAL CO.