


KINGSTON - COAL CO
BENNETT - VEIN
Scale 1" = 100'

10' VEIN

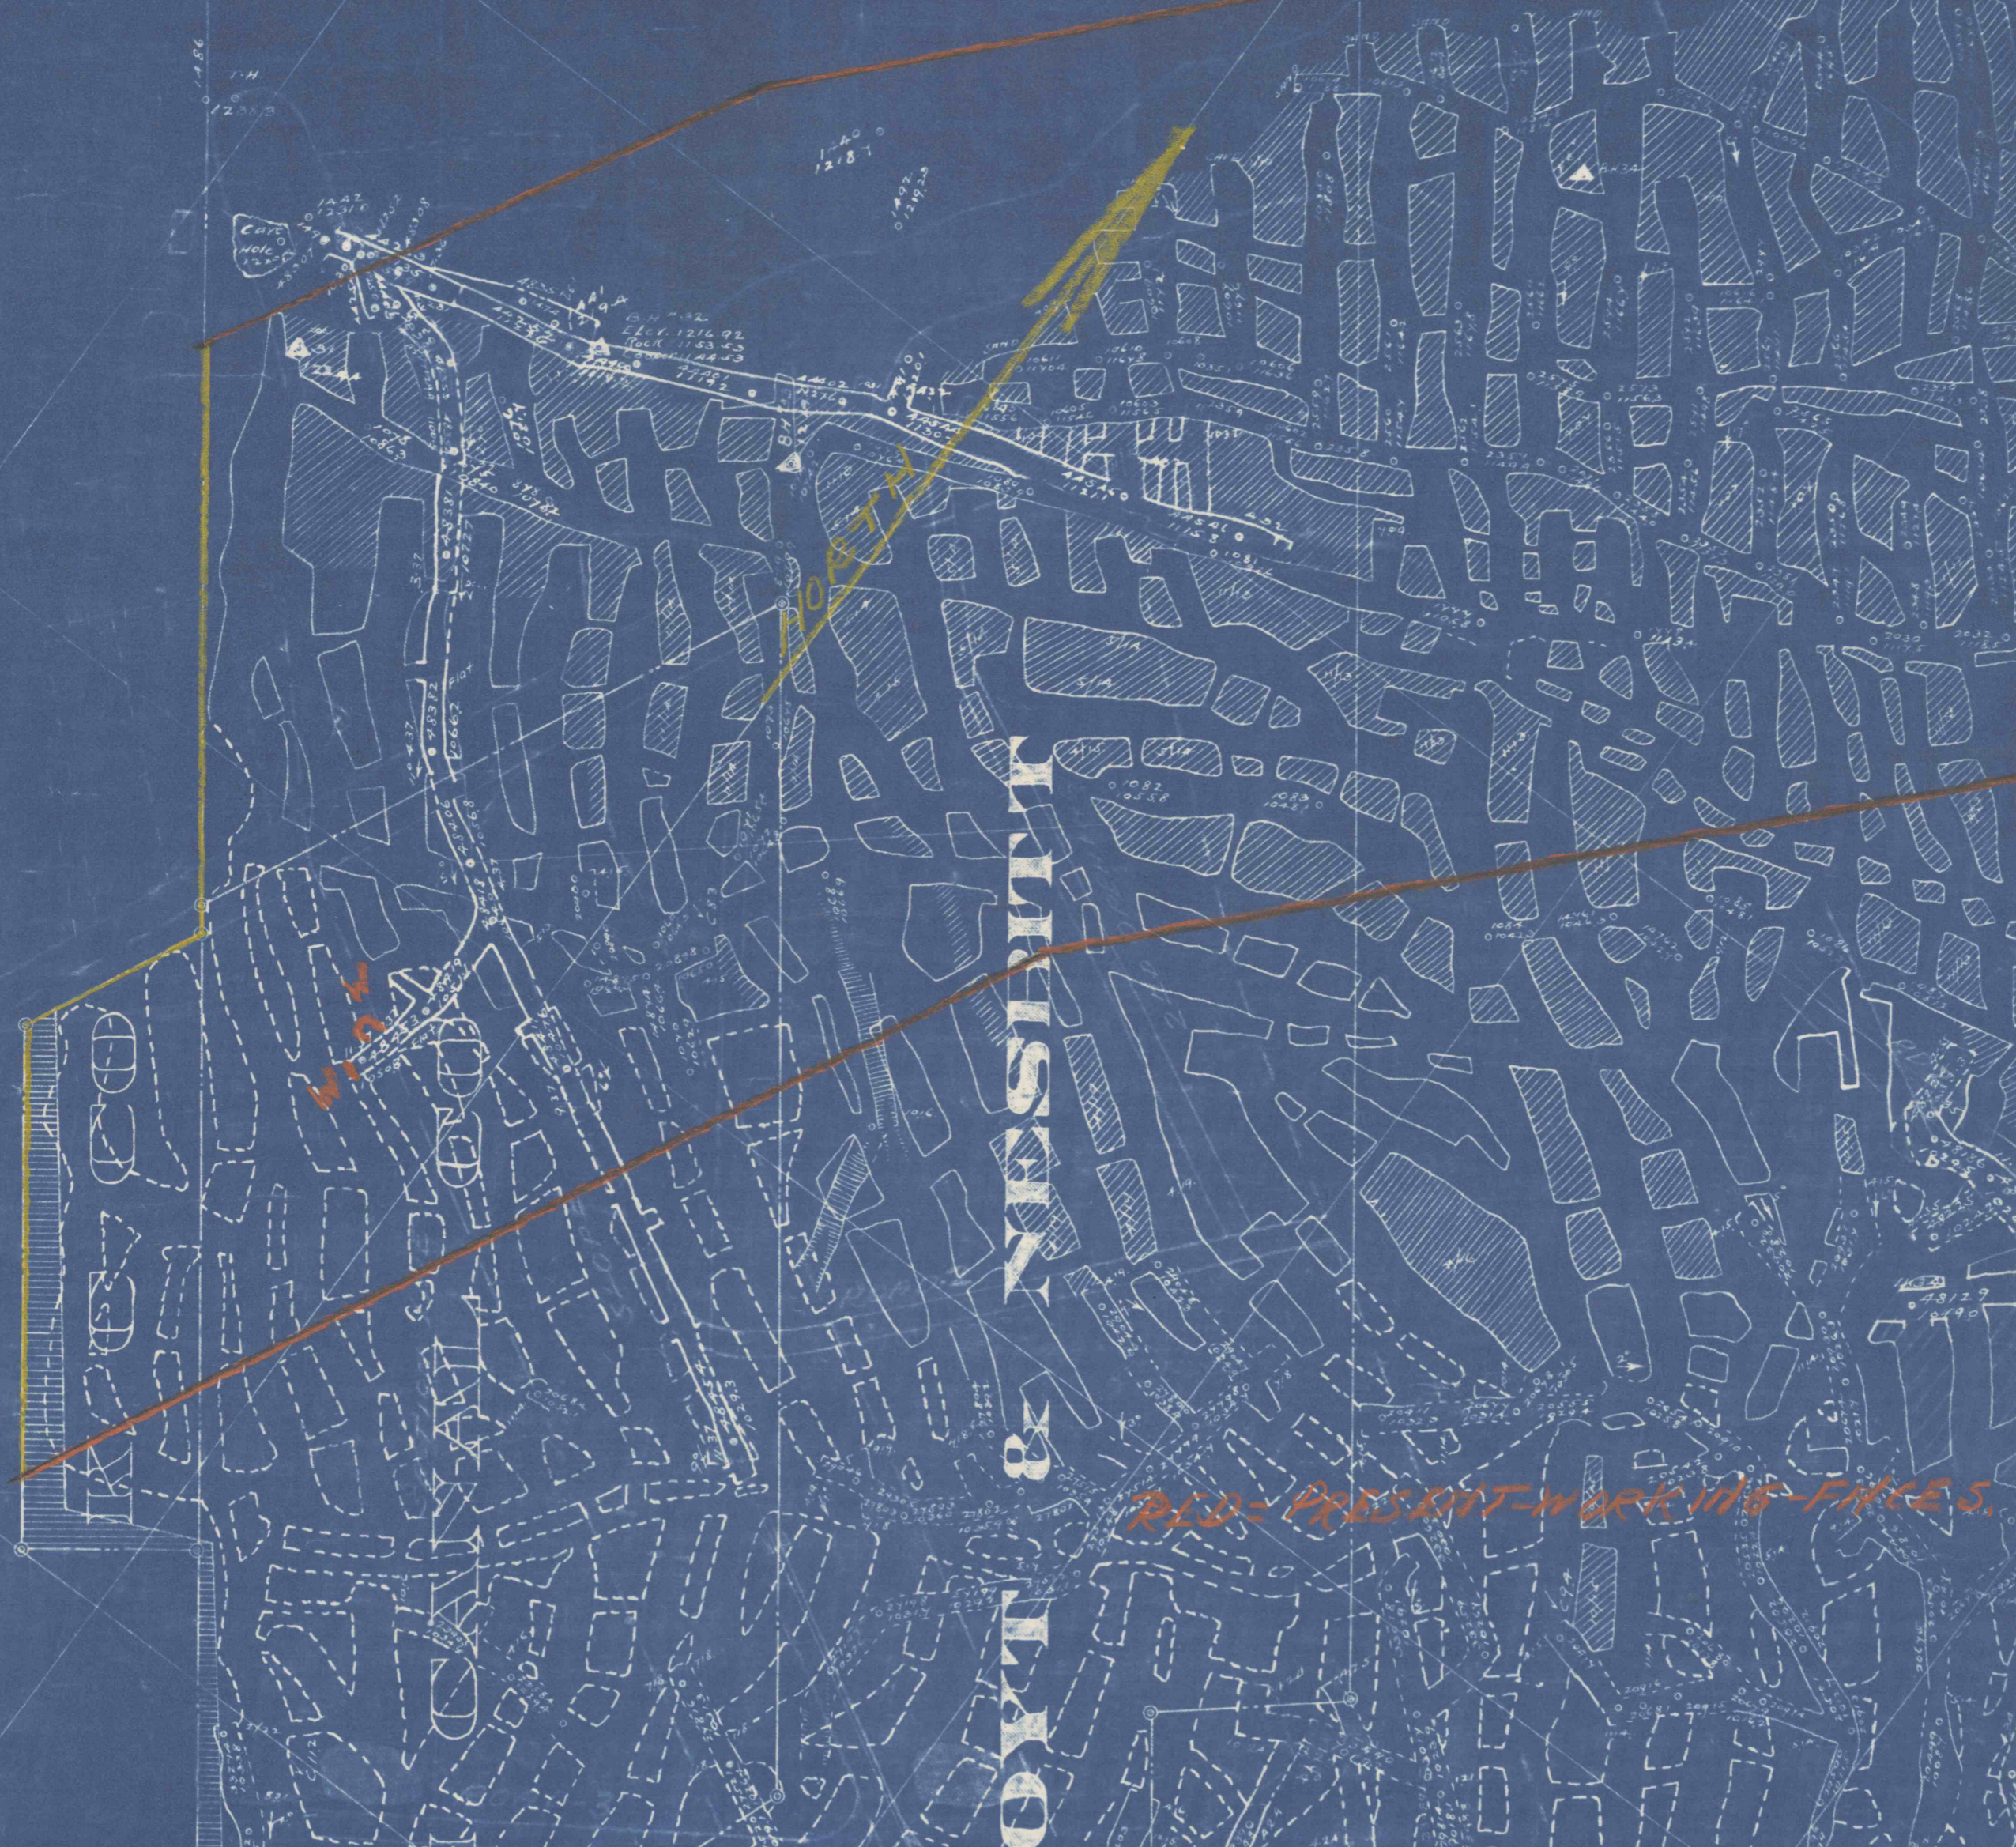

WILSON

WILSON

RED - PRESENT WORKING FACES.