


40 30 20 10 0 10 20 30 40 30 2

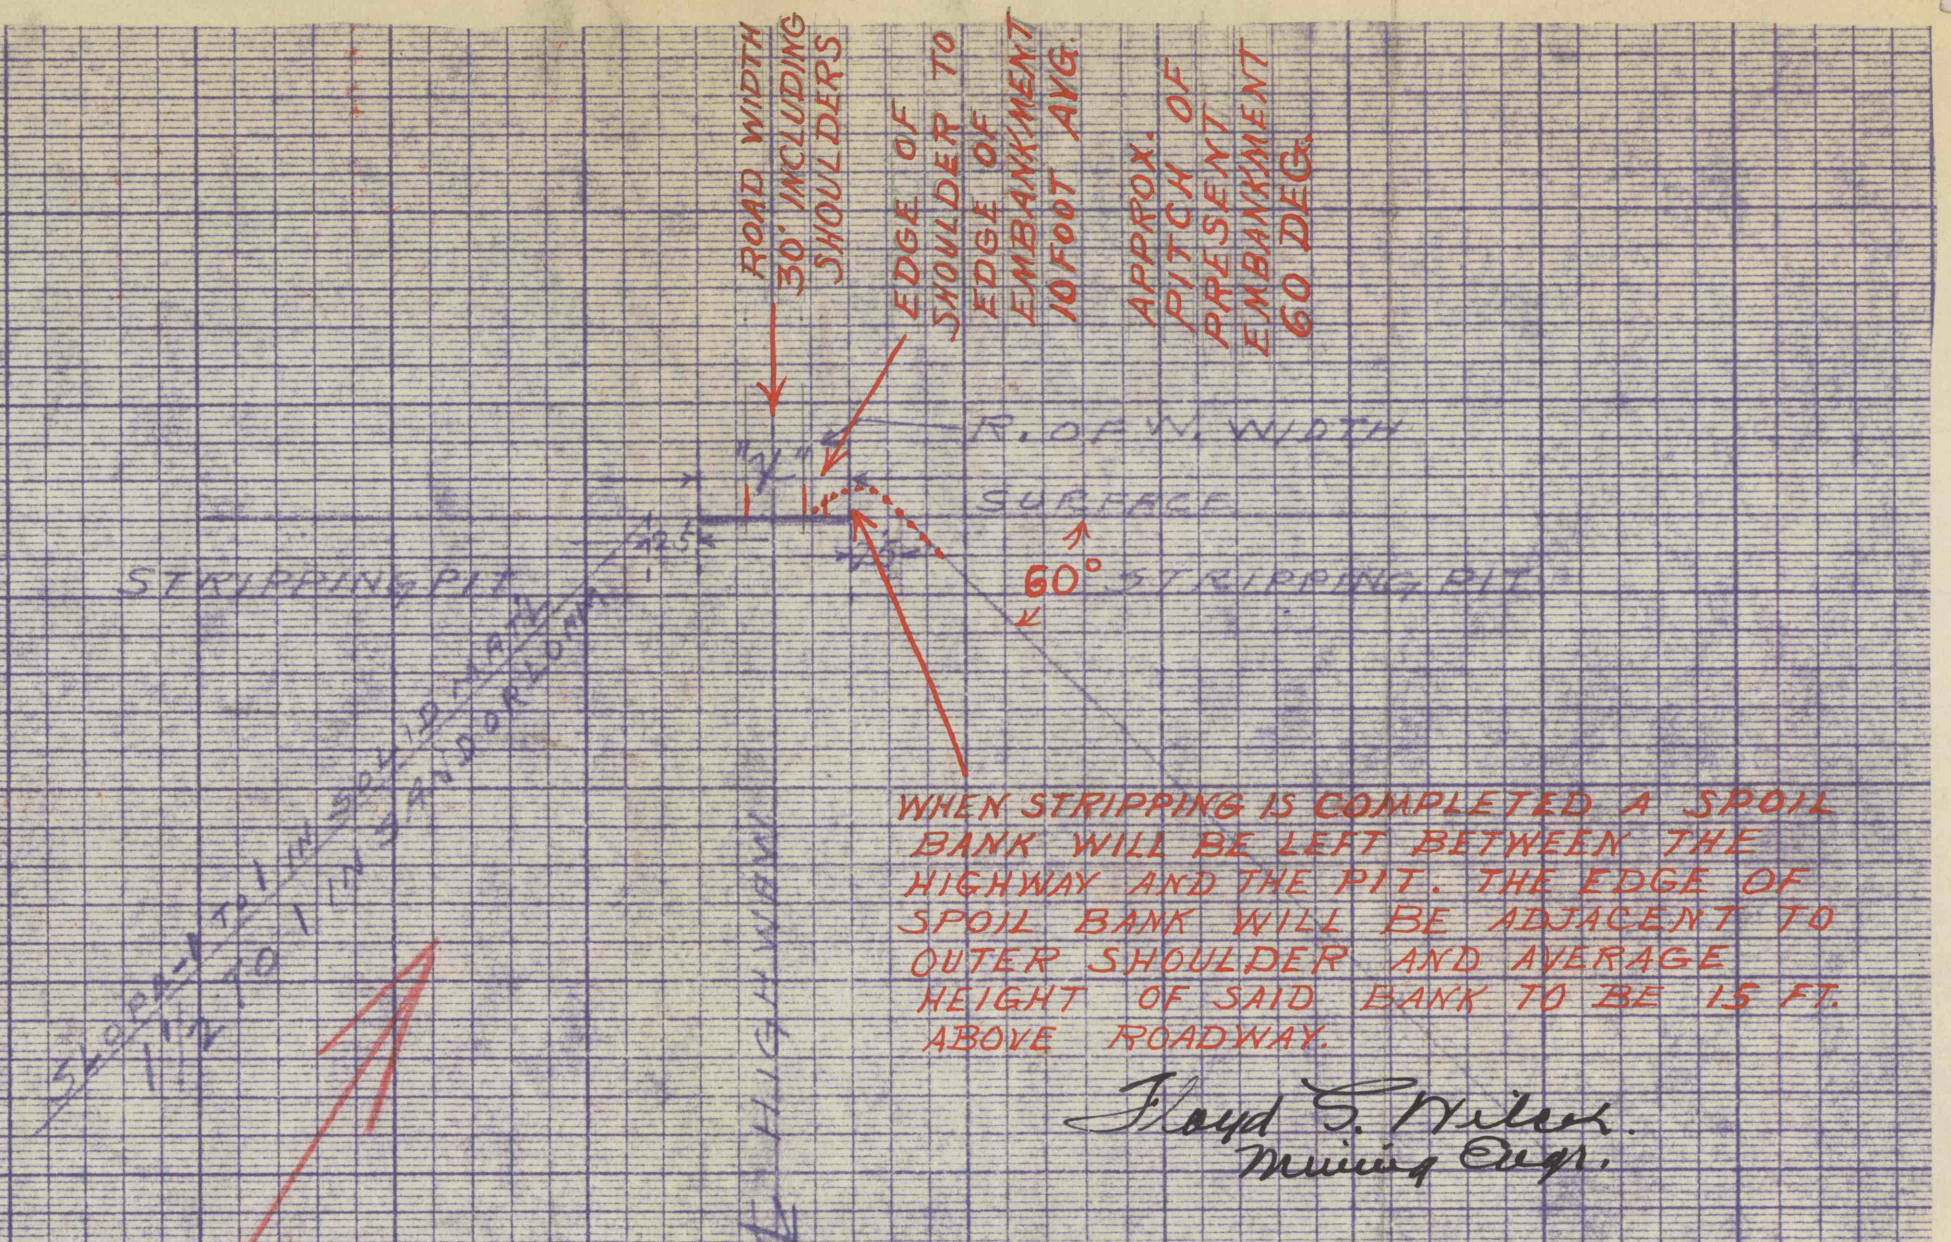

SURFACE RESERVATION FOR PROTECTION OF HIGHWAYS ADJACENT TO STRIPPING PITS
 SCALE - 1" = 100'
 PENNA. DEPT. OF HIGHWAYS
 DATE - 2-1-1943

*F. E. Miller - 1109 Cooper Co.
 Please note in stripping Run 40103 A.E. Yetter*

SCALE: 1 INCH = 5 FEET