

LUZERNE COUNTY
LACKAWANNA COUNTY

DRAKE ST.

BRODHEAD

STA. 14+27

STA. 16+82

STA. 18+52

STA. 19+22

SUBSIDENCE
240'

SKETCH
OF SUBSIDENCE
ROUTE 40103

7-31-46

⌘

HILL ST. STA 0+00

STA. 8+63

BRIDGE

OLD


ST.

FORGE

ST.

MILLARD

BORO.

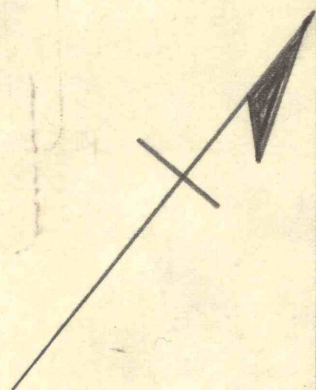

ST.

ROUTE 40103