


LUZERNE BORO.  
40105 I.B  
Luzerne Anth. Coal Co.  
From Chas. Miles -

Sta. 58+00

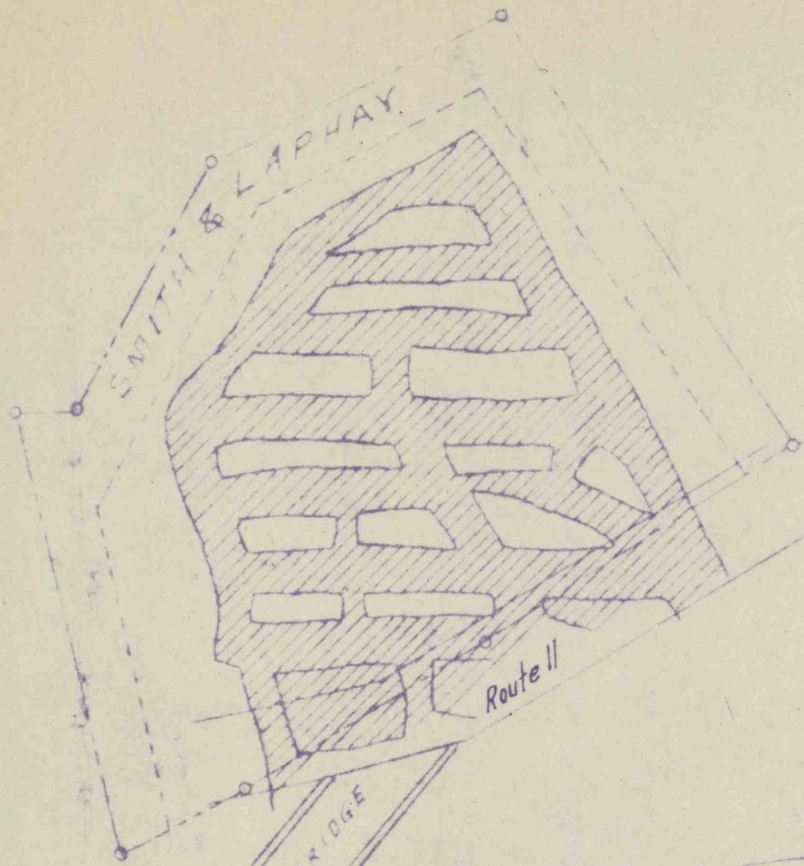

CONCRETE BY-PASS

BOTTOM ROSS VEIN  
COAL 8-8 FT.

GATE IN ROOF

226

Sta. 53+40

226

UNION

60'

ROBBED & FLUSHED WITH  
CULM & ROCK

ST.

A

B

ATHERHOLT

Sta. 47+20

226

226

226