


AREA IN BLUE
REPRESENTS
COOPER & BENNETT
VEINS ROBBED & FLUSHED

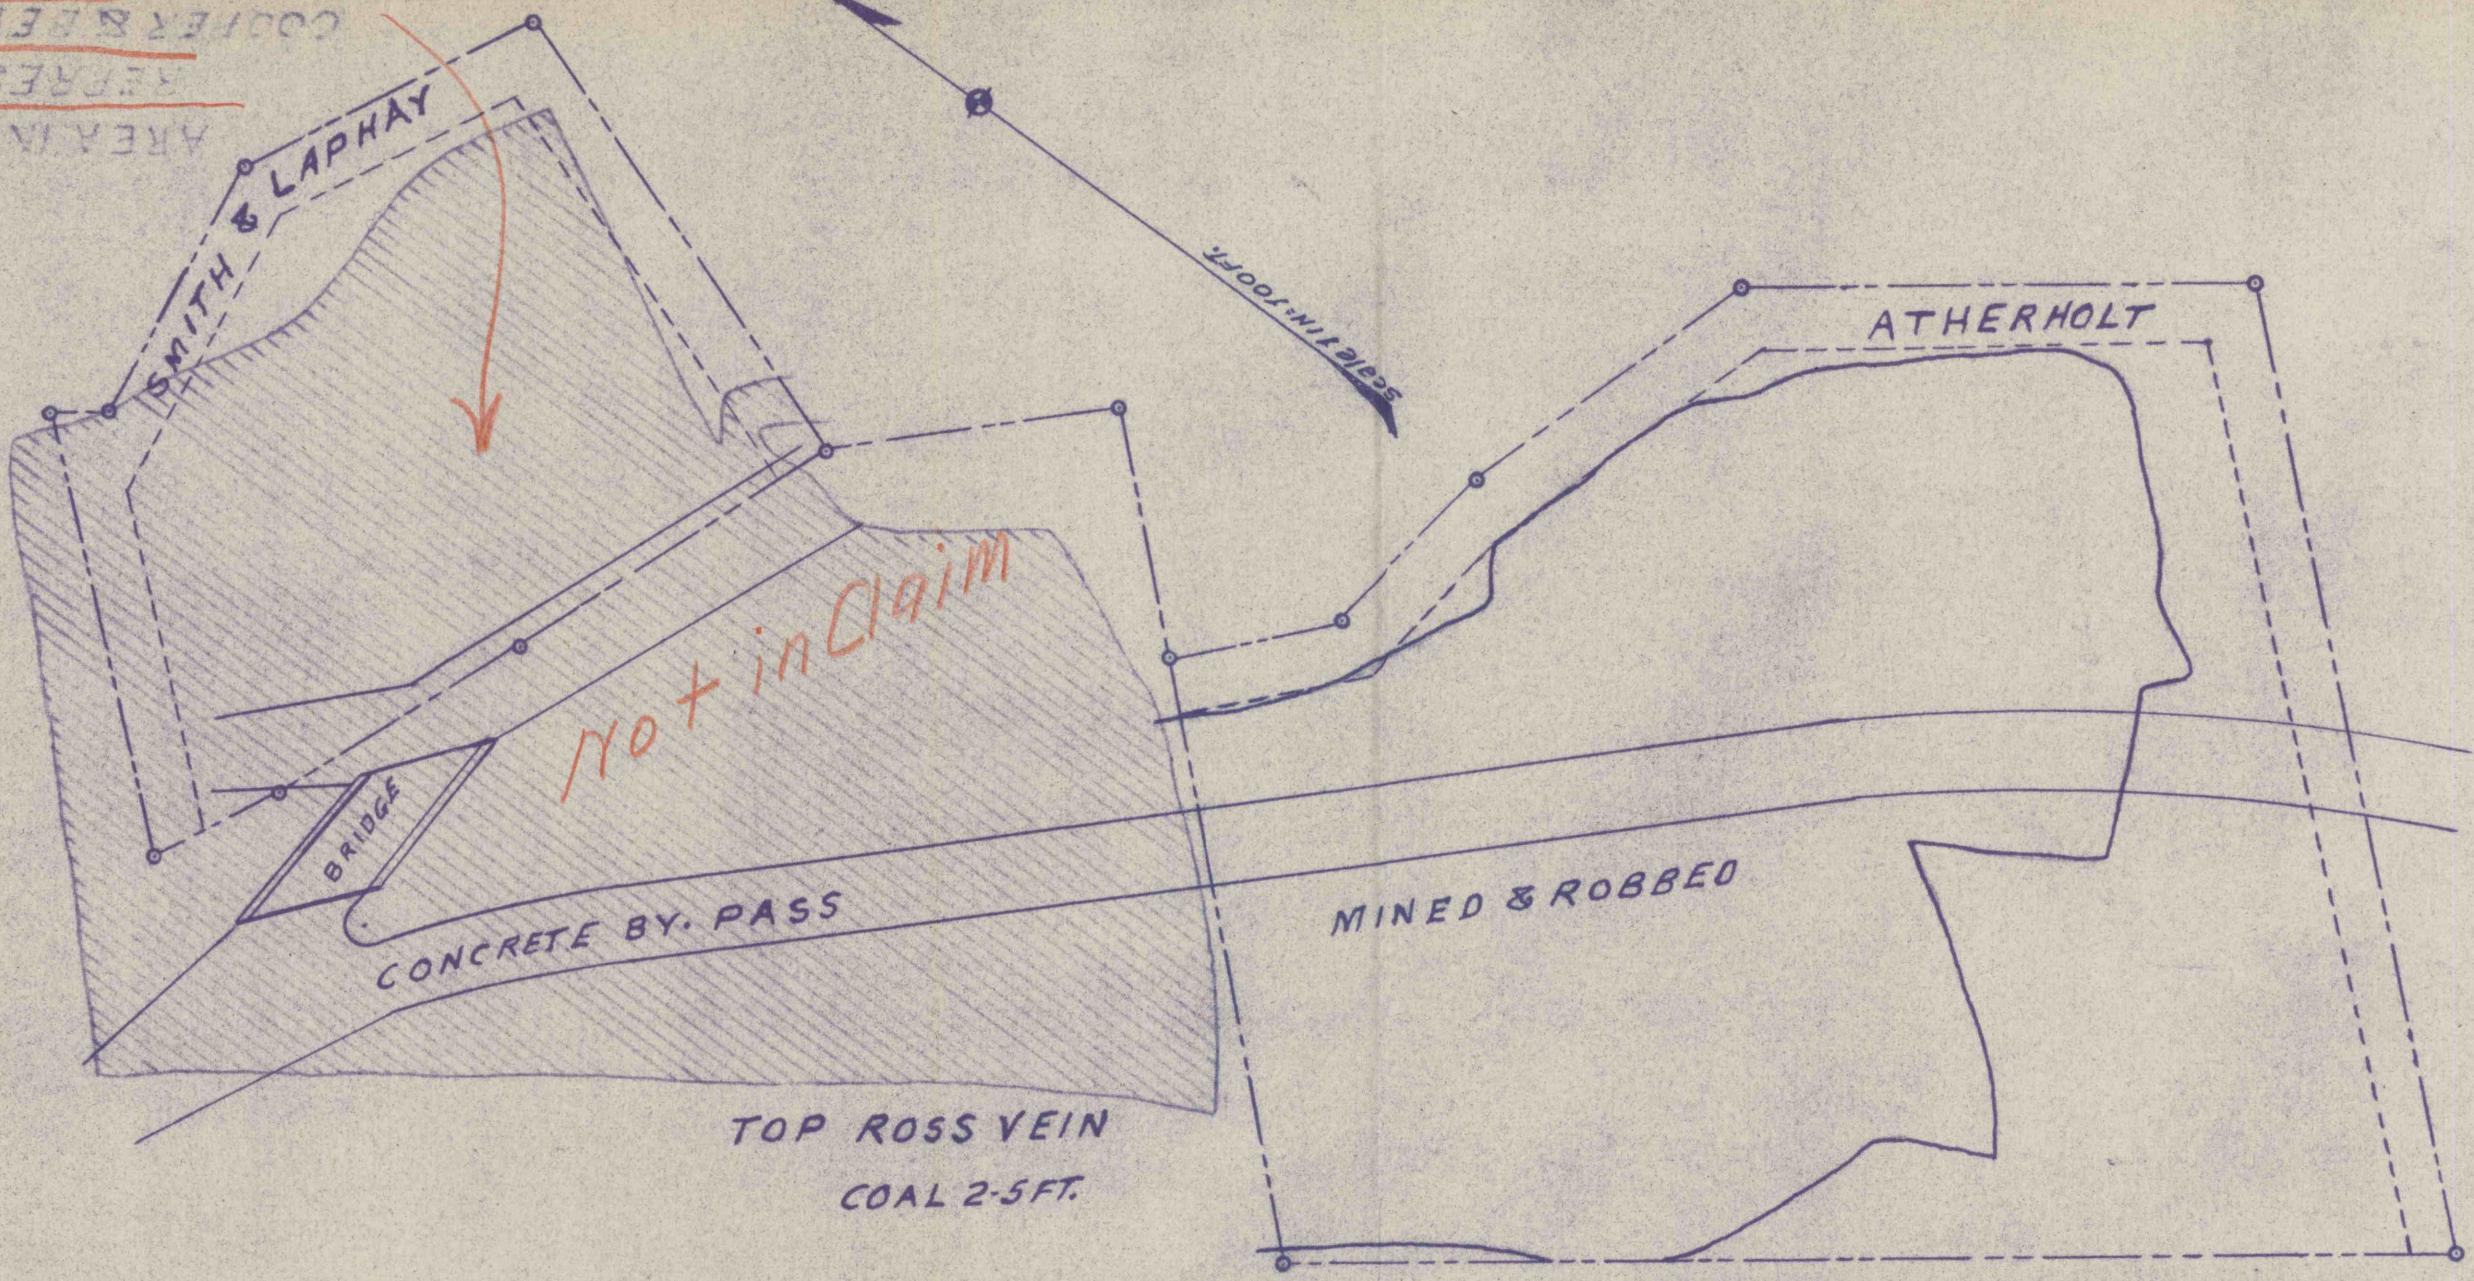

NOT IN CLAIM

SCALE 1 IN. = 100 FT.

ATHERHOLT

MINED & ROBBED

CONCRETE BY-PASS

BRIDGE

TOP ROSS VEIN
COAL 2-5 FT.