


226'

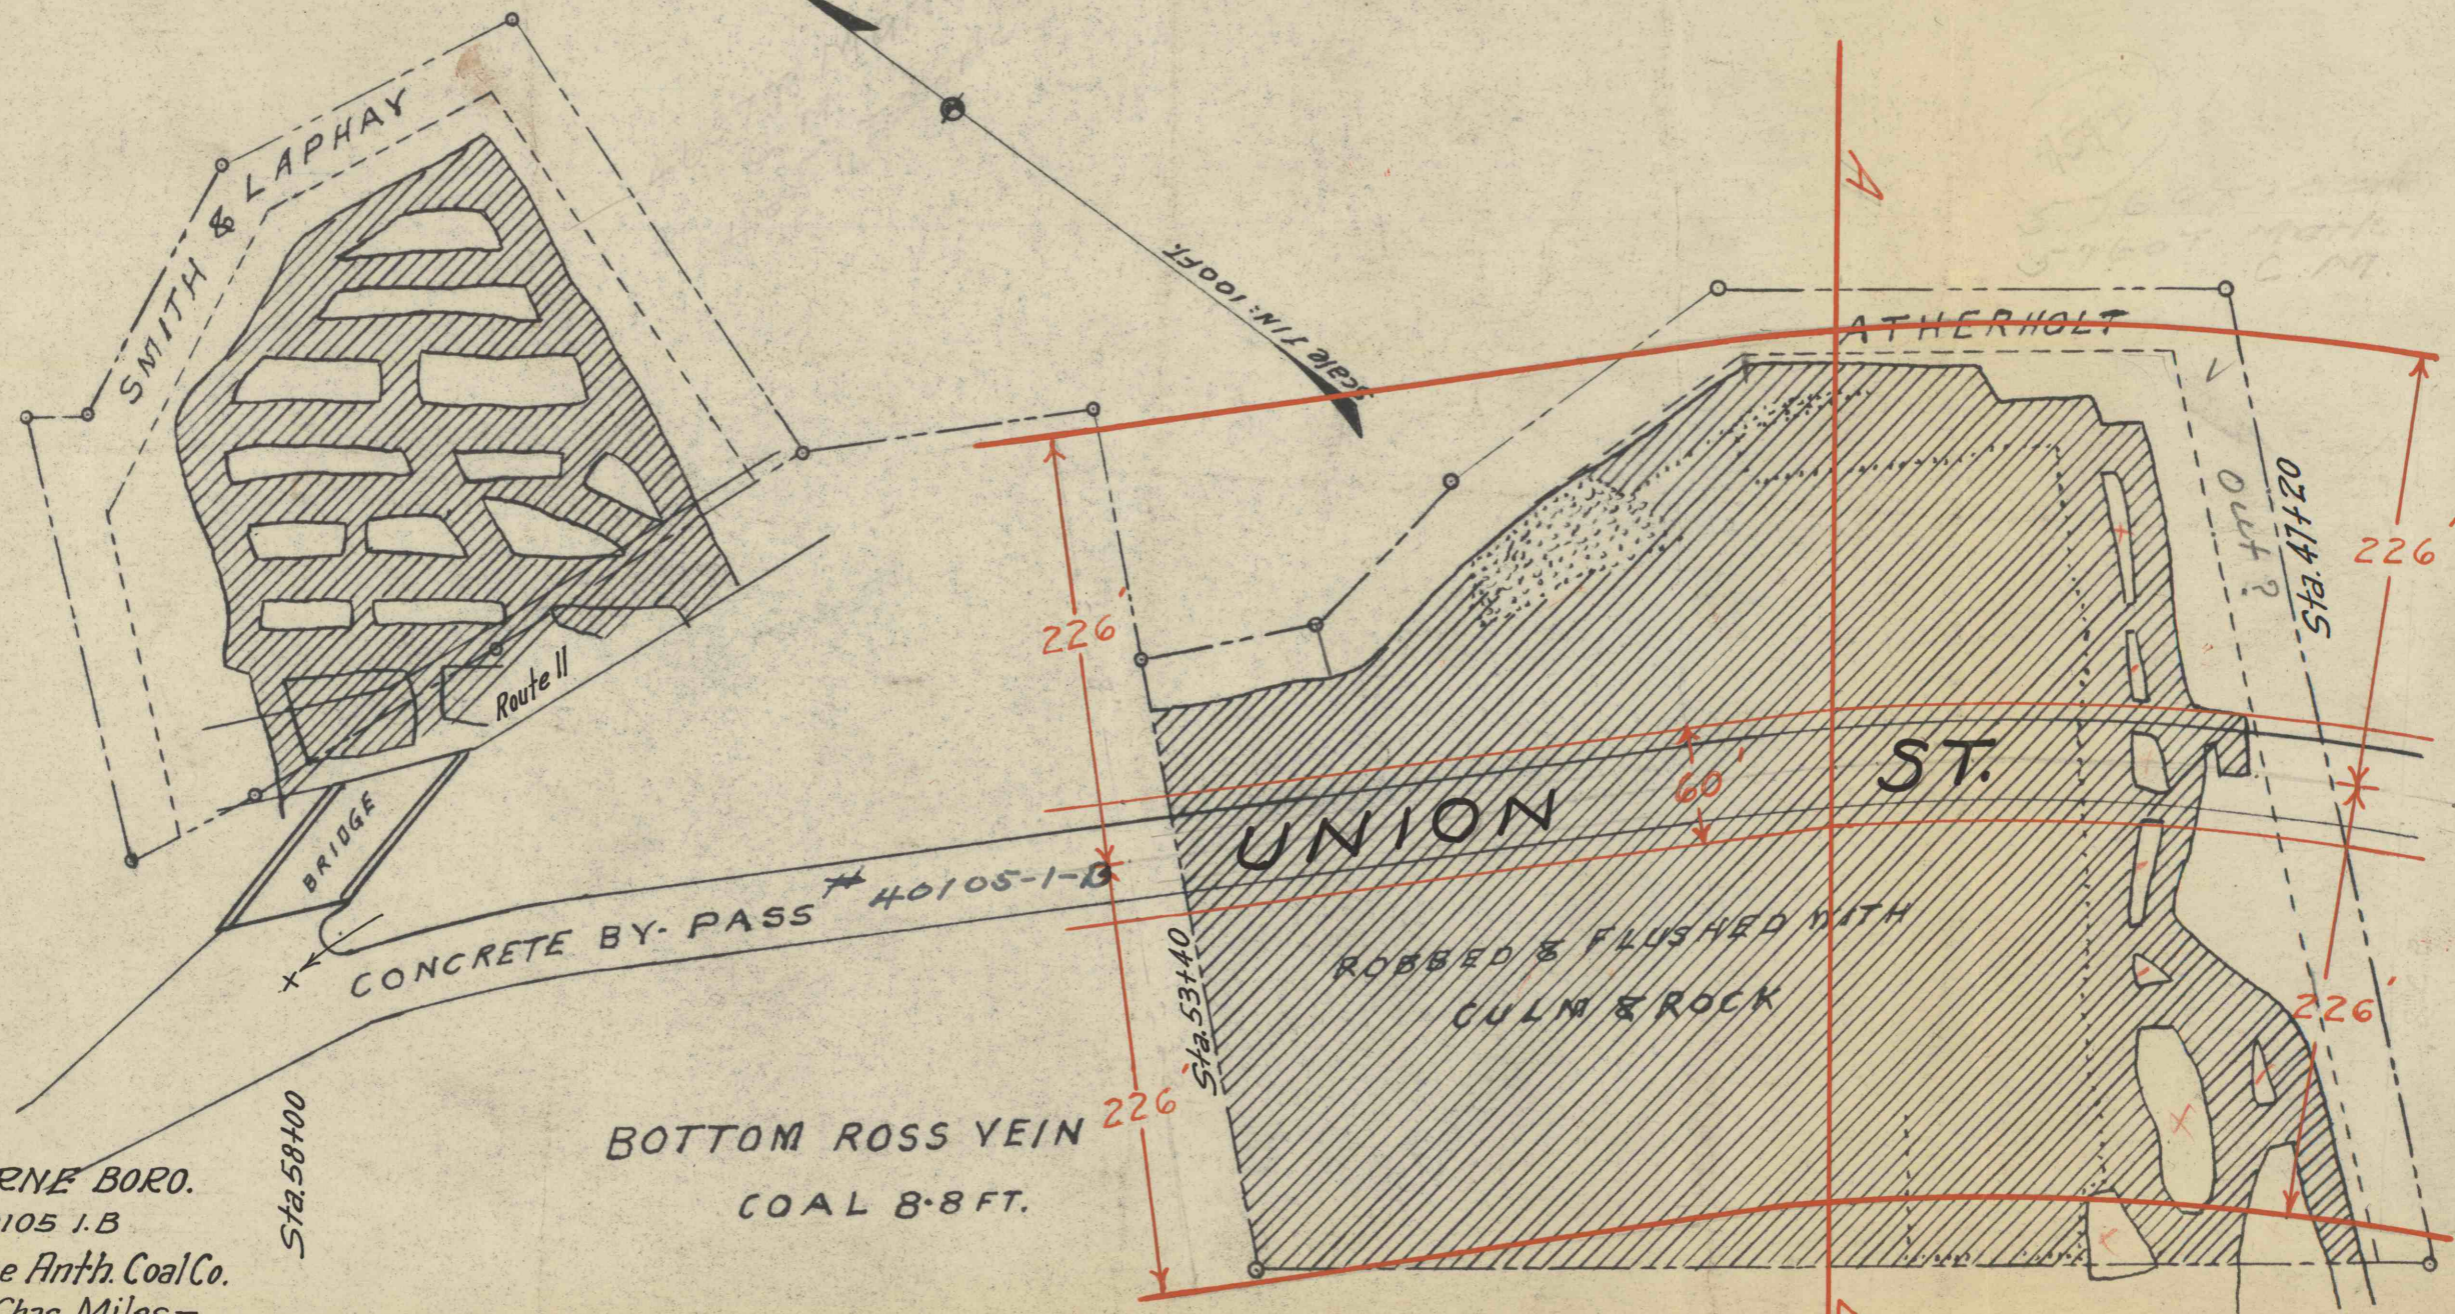

LUZERNE BORO.
 40105 I.B
 Luzerne Anth. Coal Co.
 From Chas. Miles -


BOTTOM ROSS VEIN
 COAL 8.8 FT.

Sta. 53+40

Sta. 47+20

Reid 11-13-42