


SCALE 1 IN. = 100 FT.

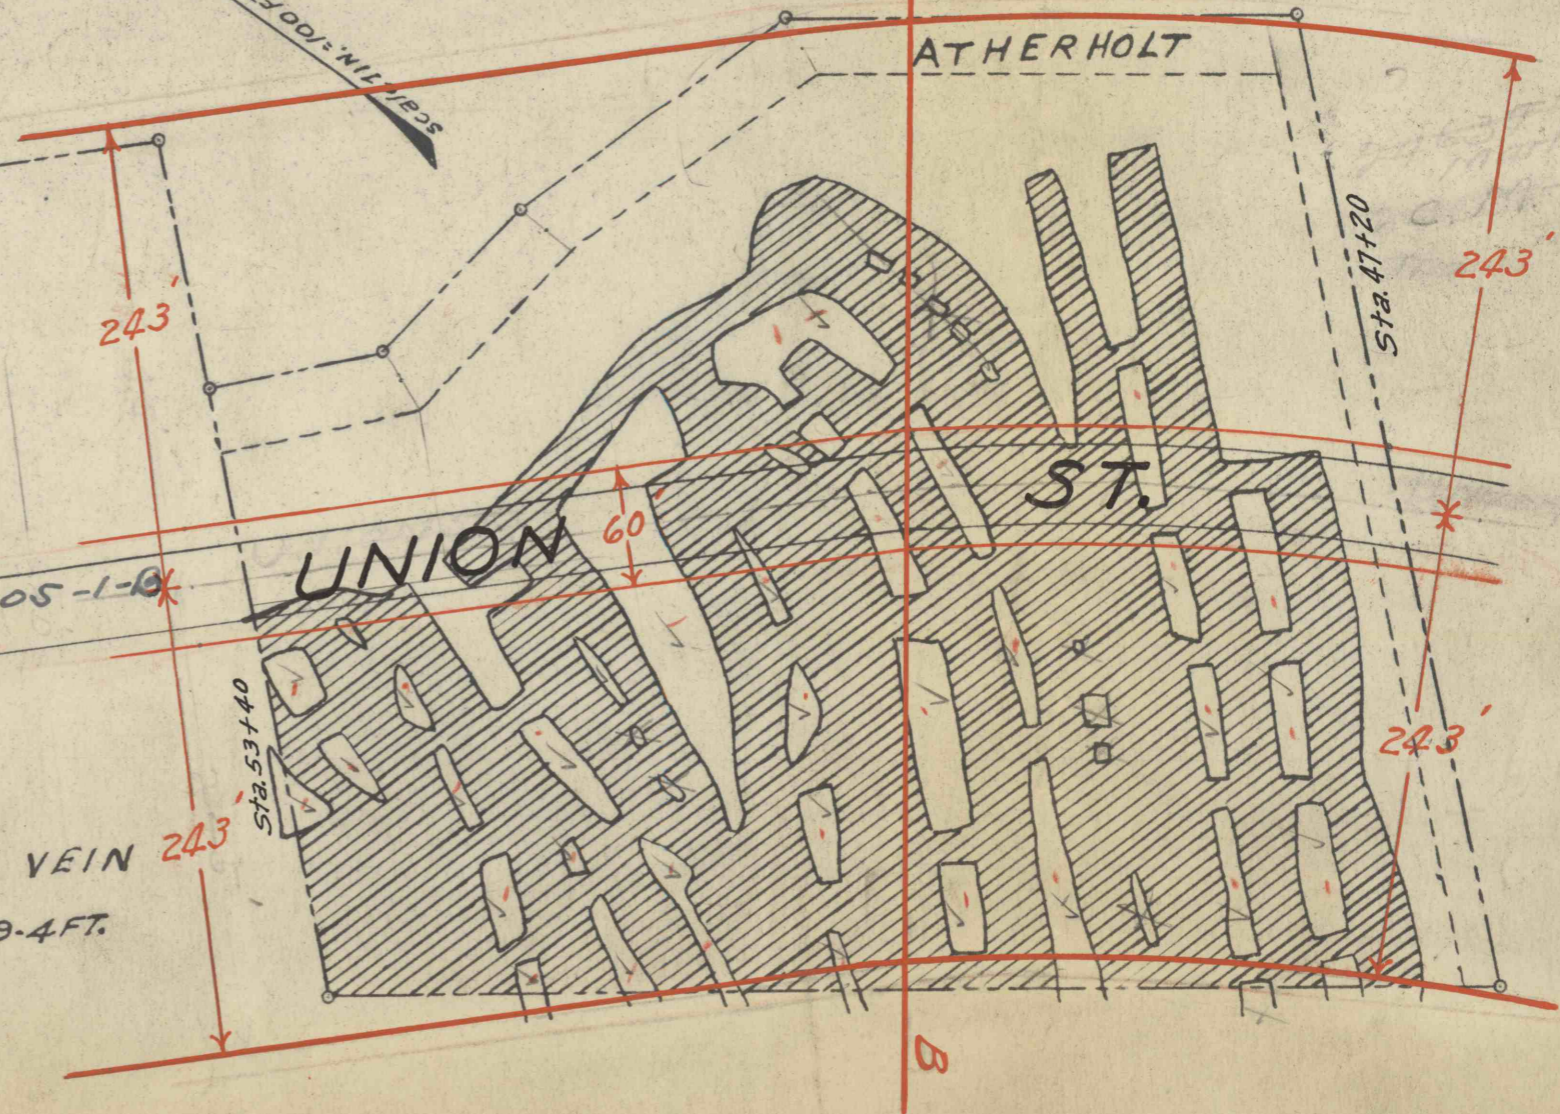

RED ASH VEIN
COAL 9-4 FT.

LUZERNE BORO.
40105 I.B.

Sta. 58+00

CONCRETE BY. PASS

40105-1-0

Luzerne Anth. Coal Co.

From Chas. Miles -

Recd H-13-42