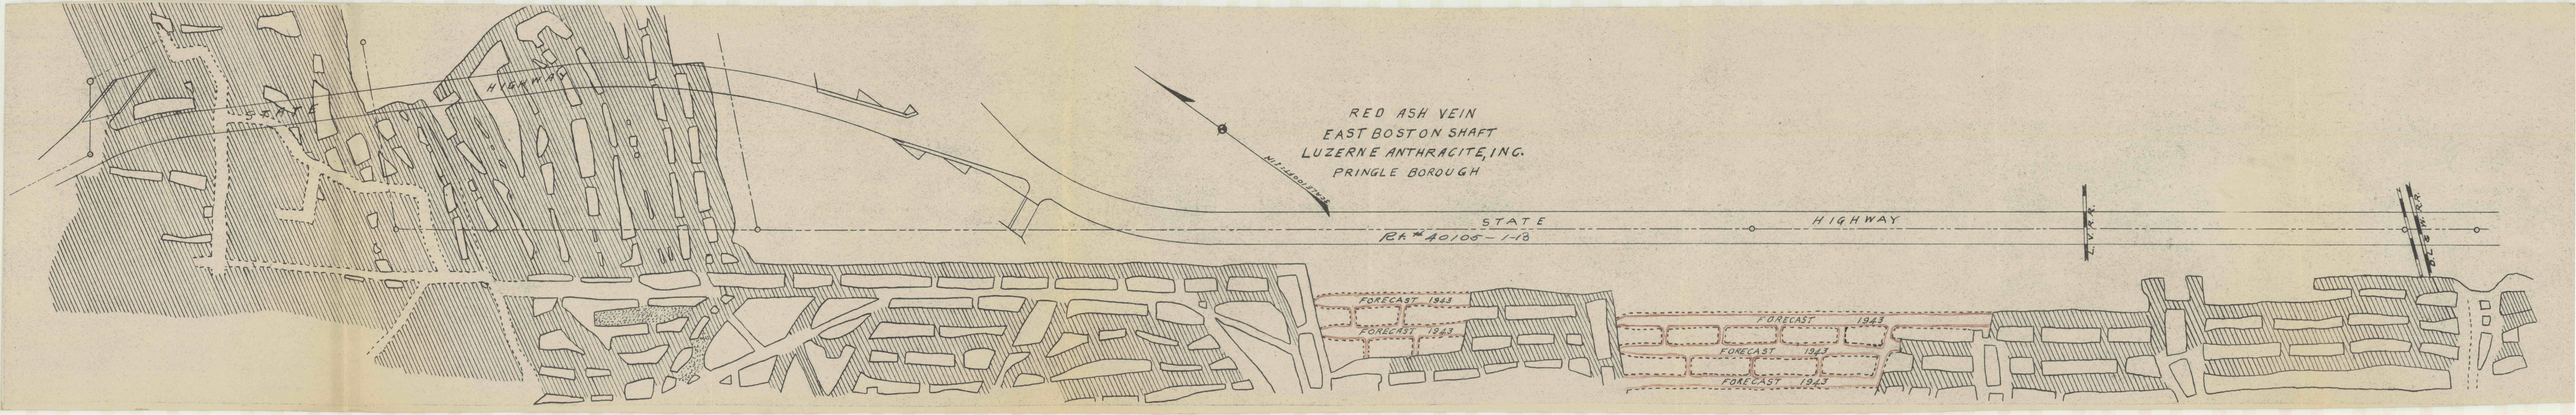
RED ASH VEIN
EAST BOSTON SHAFT
LUZERNE ANTHRACITE, INC.
PRINGLE BOROUGH
STATE HIGHWAY
Rte. # 40105 - 1-18
FORECAST 1943
FORECAST 1943
FORECAST 1943
FORECAST 1943
FORECAST 1943