


L16

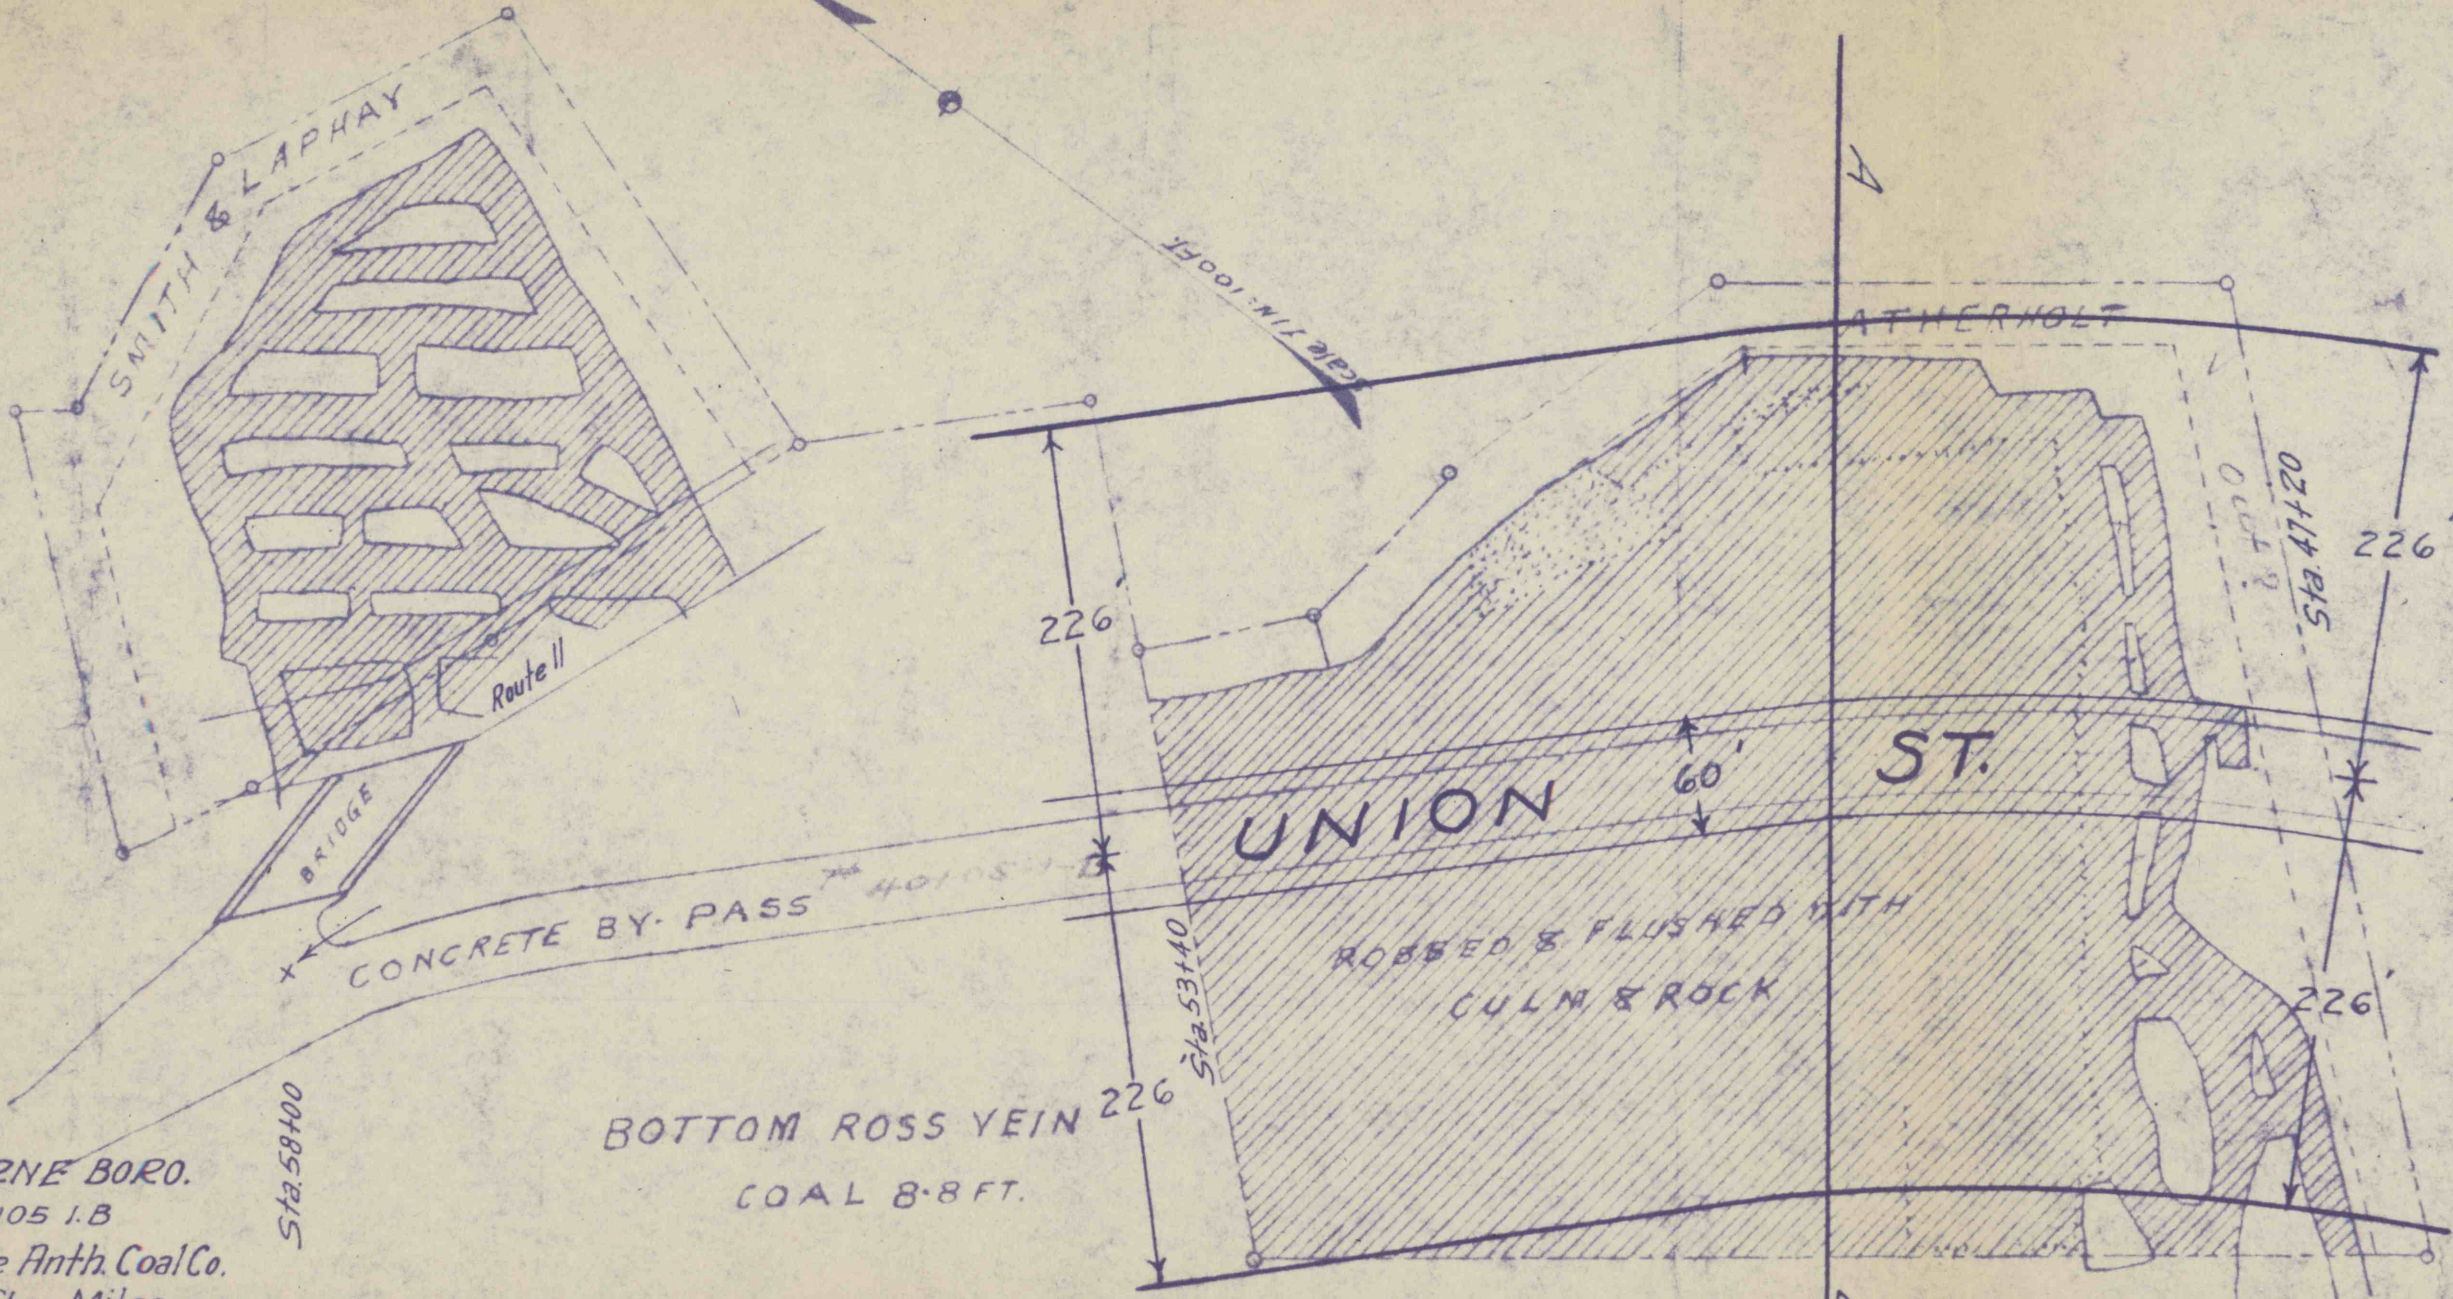

LUZERNE BORO.  
 40105 I.B  
 Luzerne Anth. Coal Co.  
 From Chas. Miles -

Sta. 58+00

BOTTOM ROSS VEIN  
 COAL 8.8 FT.

Sta. 53+40

Sta. 47+20

A

B