


SECTION A-B

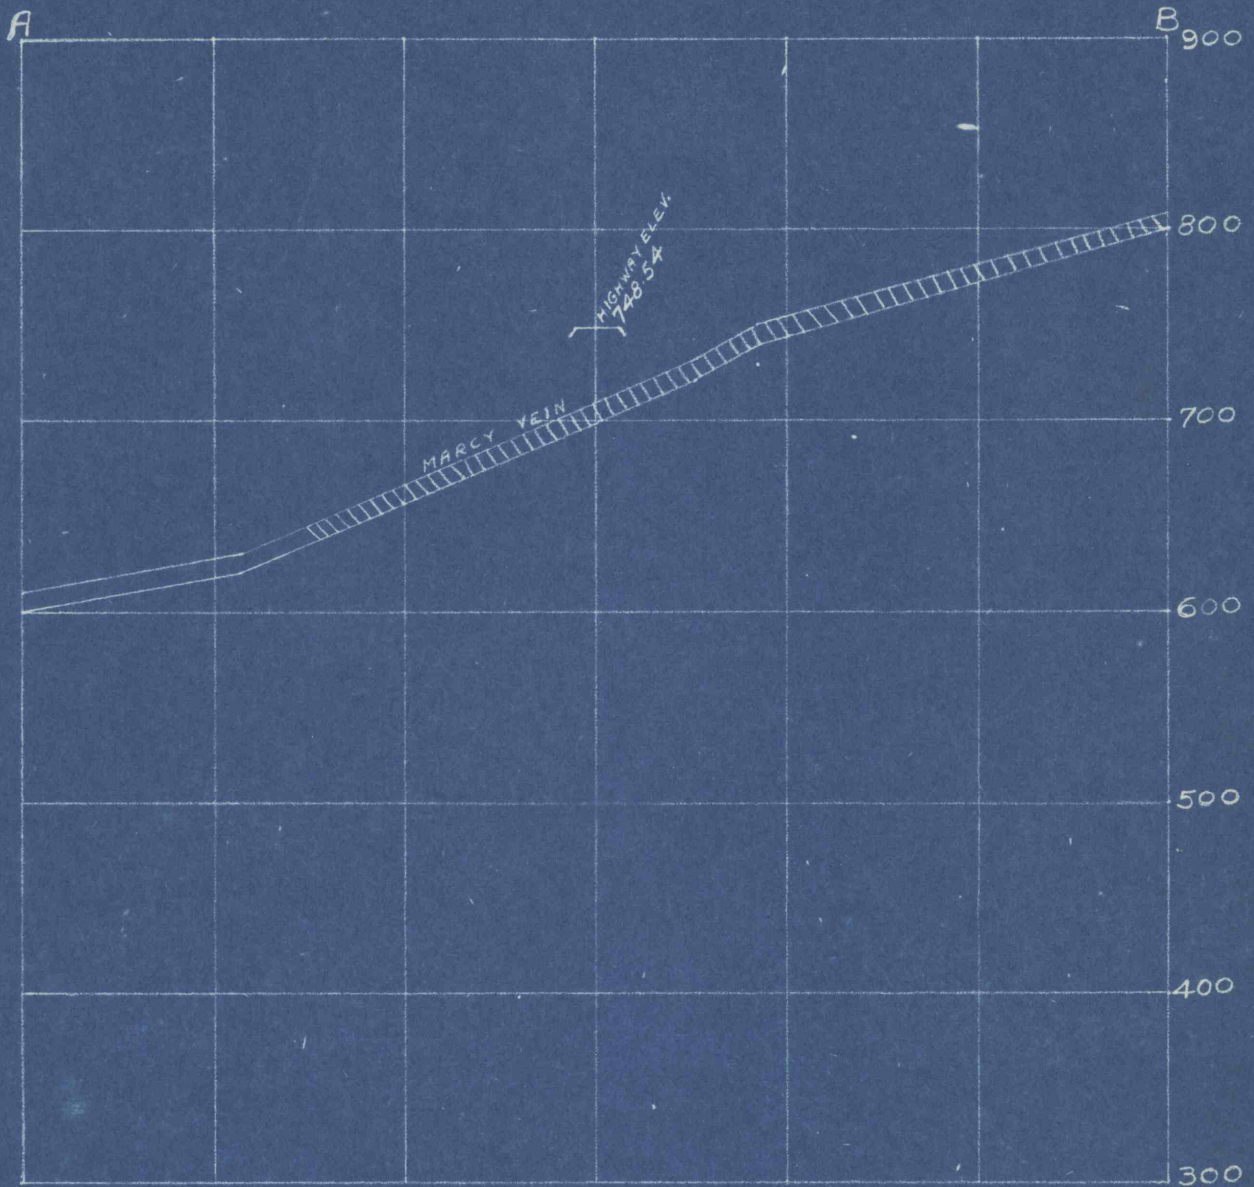

BUTLER COLLIERY  
Butler Slope - - - Marcy Vein  
Scale 1" = 100'

Cross section of Marcy Vein  
underlying Leg. Route No. 5 &  
No. 40109, Hughestown Borough,  
Luzerne County, Pa.

□ First mined  
▨ Complete mining