


Mill St Pittston
at
Church St

40109
St Line fx 10+60

Highway Elevation
629.75

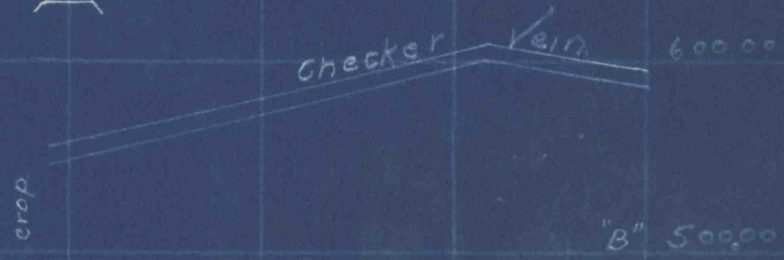

"A"

"B" 500.00

Cross section

3 2 1 0 1 2 3

MORGAN SLOPE COAL CO. 81 LAMBERT, PITTSBURGH PA.
SENECA SLOPE - CHECKER VEIN.
OWNED by THE PENNA COAL CO. DUNMORE PA.
OPERATOR- MORGAN SLOPE COAL CO.
MINING ENGR. H.M. HOCK 125 BROAD ST. PITTSBURGH PA.
SUPT. PETER MINICHELLO 48 WILSON ST. PITTSBURGH PA.
ANTICIPATED MINING
DEVELOPMENT COMPLETED.
HIGHWAY SCALE 1" = 100' ST. LINE REF. 1/3/38.