


PITTSTON CITY

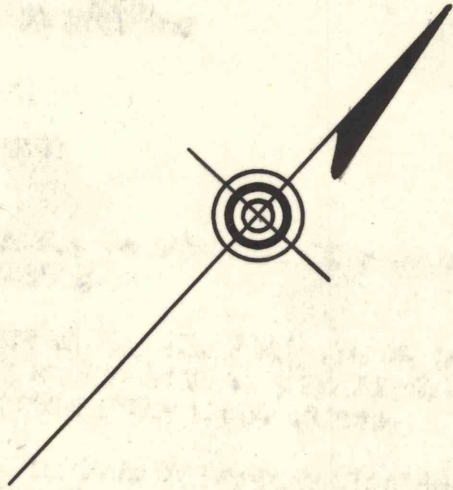


SIDEWALK

ROUTE 40109

RES. 137

RES. 140

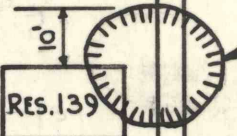

HOLE 60' ON SURFACE - 25' DEEP

RES. 139

RES. 146

(BRICK PAVE)

SIDEWALK

RES. 143

RES. 148

SEARLE ST. ROUTE 40109

SIDEWALK

MILL ST.

NO 9 COAL CO.
CHECKER VEIN
PITTSTON CITY
LUZERNE COUNTY
SKETCH:- DO NOT SCALE

Pennsylvania Dept. of Highways
May 24, 1948

Scranton, Pa.
T.F.S.