


# PITTSTON CITY

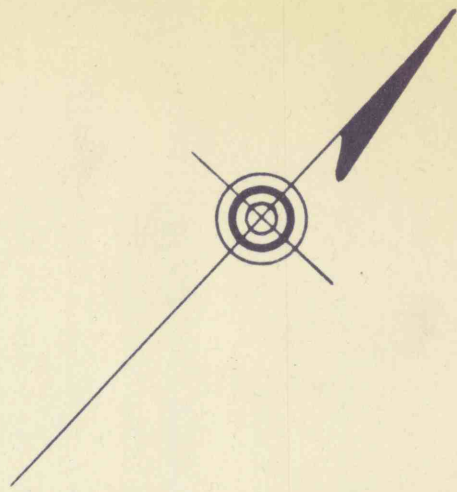


ROUTE 40109

SIDEWALK

RES. 137

RES. 140

RES. 139

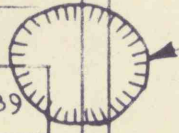

HOLE 60' ON SURFACE - 25' DEEP

RES. 146

(BRICK PAVE)

SIDEWALK

RES. 143

RES. 148

SEARLE ST. ROUTE 40109

SIDEWALK

MILL ST.

NO 9 COAL CO.  
CHECKER VEIN  
PITTSTON CITY  
LUZERNE COUNTY  
SKETCH:- DO NOT SCALE

Pennsylvania Dept. of Highways  
May 24, 1948

Scranton, Pa.  
T.F.S.