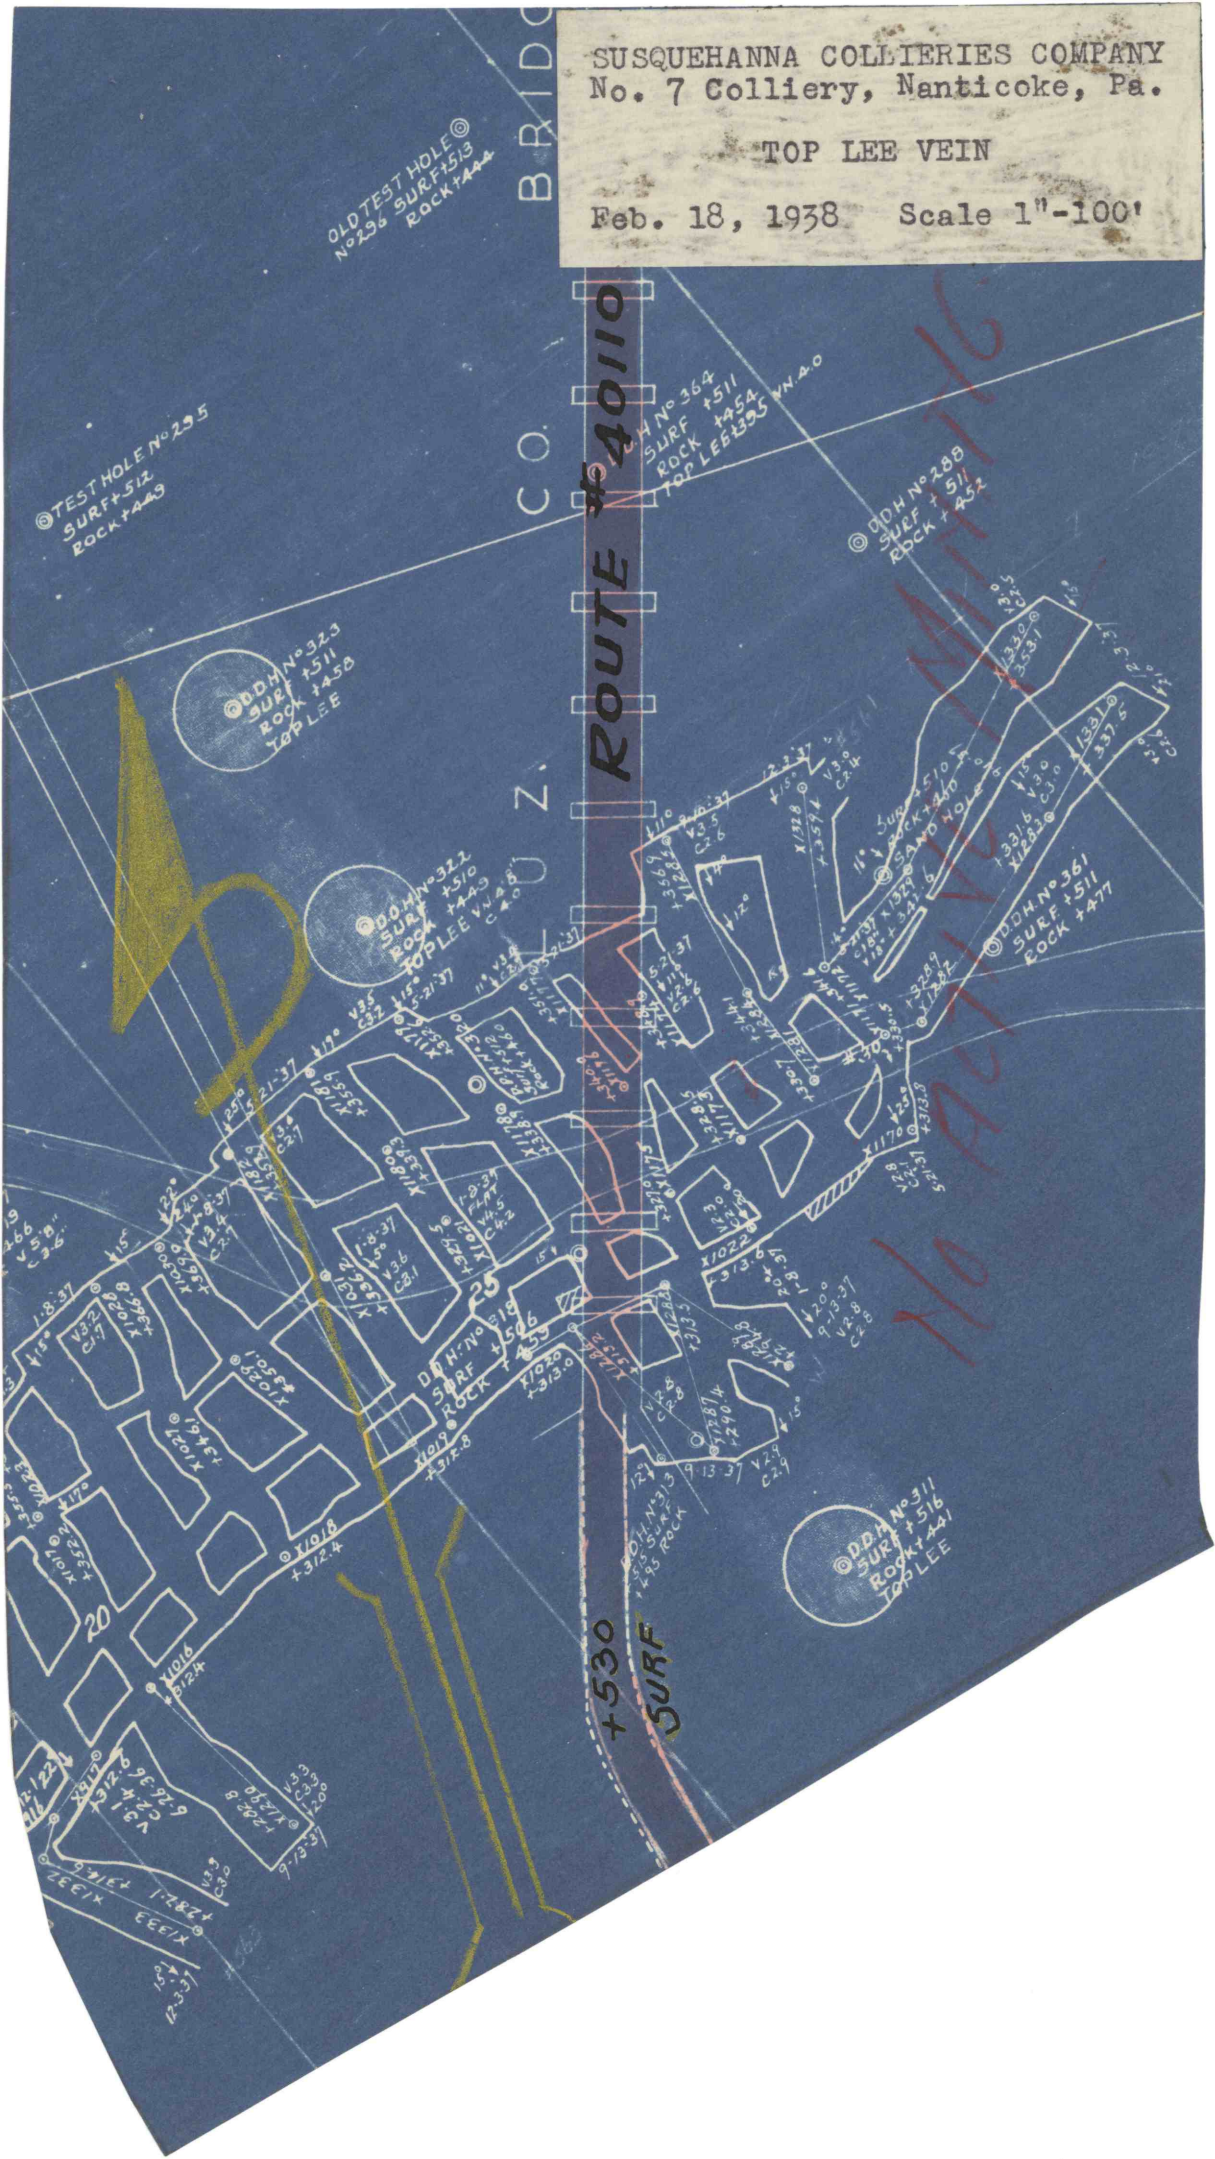
SUSQUEHANNA COLLIERIES COMPANY
No. 7 Colliery, Nanticoke, Pa.
TOP LEE VEIN
Feb. 18, 1938 Scale 1"-100'
ROUTE #40110
+530 SURF
OLD TEST HOLE No 296 SURF +513 ROCK +444
TEST HOLE No 295 SURF +512 ROCK +449
DDH No 364 SURF +511 ROCK +454 TOP LEE +395 VN 4.0
DDH No 288 SURF +511 ROCK +452
DDH No 323 SURF +511 ROCK +458 TOP LEE
DDH No 322 SURF +510 ROCK +443 TOP LEE VN 4.8 C 4.0
DDH No 361 SURF +511 ROCK +477
DDH No 311 SURF +516 ROCK +441 TOP LEE
DDH No 313 SURF +545 ROCK +493
DDH No 319 SURF +546 ROCK +455
SAND HOLE
20
25