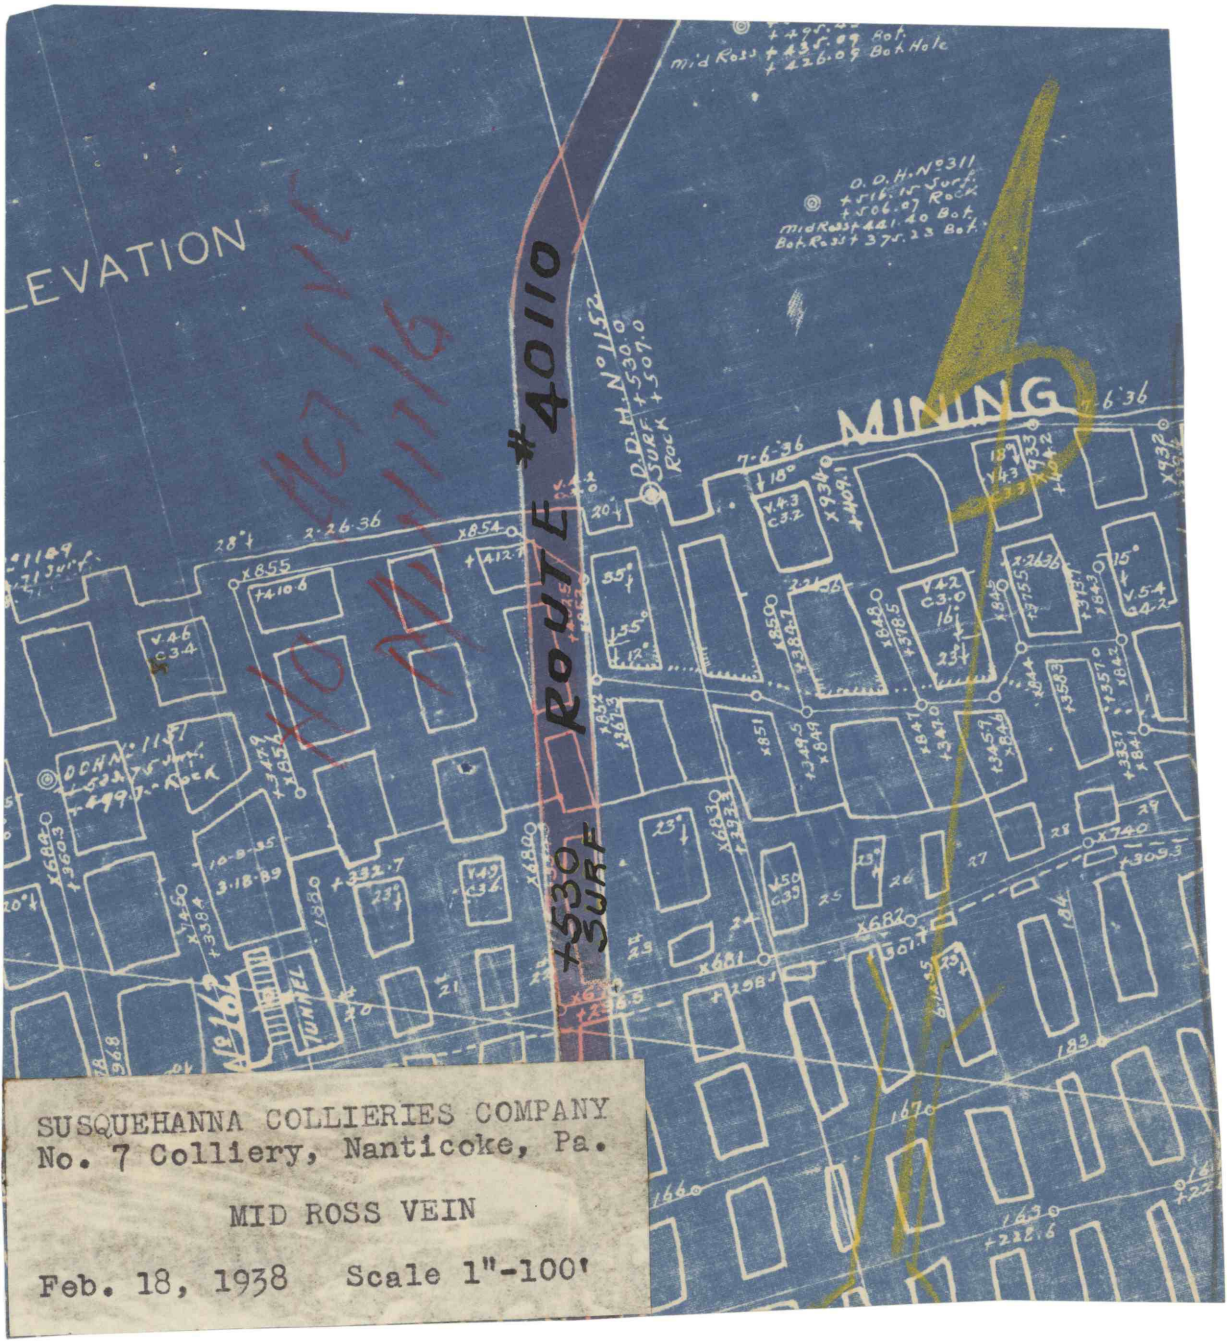

SUSQUEHANNA COLLIERIES COMPANY
No. 7 Colliery, Nanticoke, Pa.

MID ROSS VEIN

Feb. 18, 1938 Scale 1"-100'