



UPPER LEHIGH BASINS - SECTION No. 30 ON MINE SHEET No. III, THROUGH MINE WORKINGS OF UPPER LEHIGH COLLIERY No. 2
Bearing N. 8° 55' W.



POND CREEK BASINS - SECTION No. 32 ON MINE SHEET No. IV, THROUGH BORE HOLE No. 1 AND MINE WORKINGS OF SANDY RUN COLLIERY (M.S. REMMERER & CO.)
Bearing N. 19° 20' W.

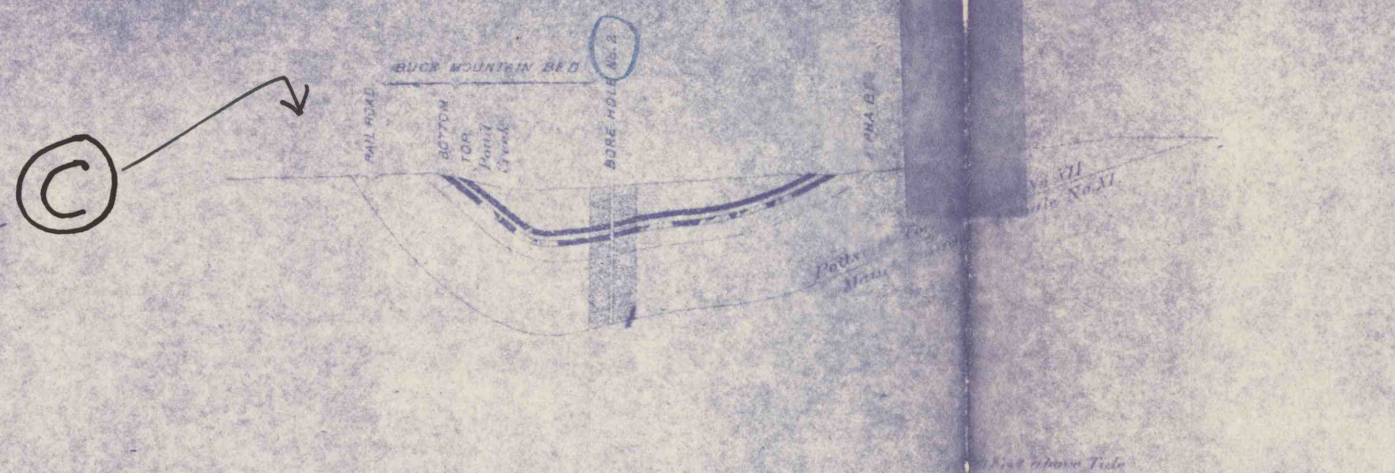

Bearing N. 17° 45' W.

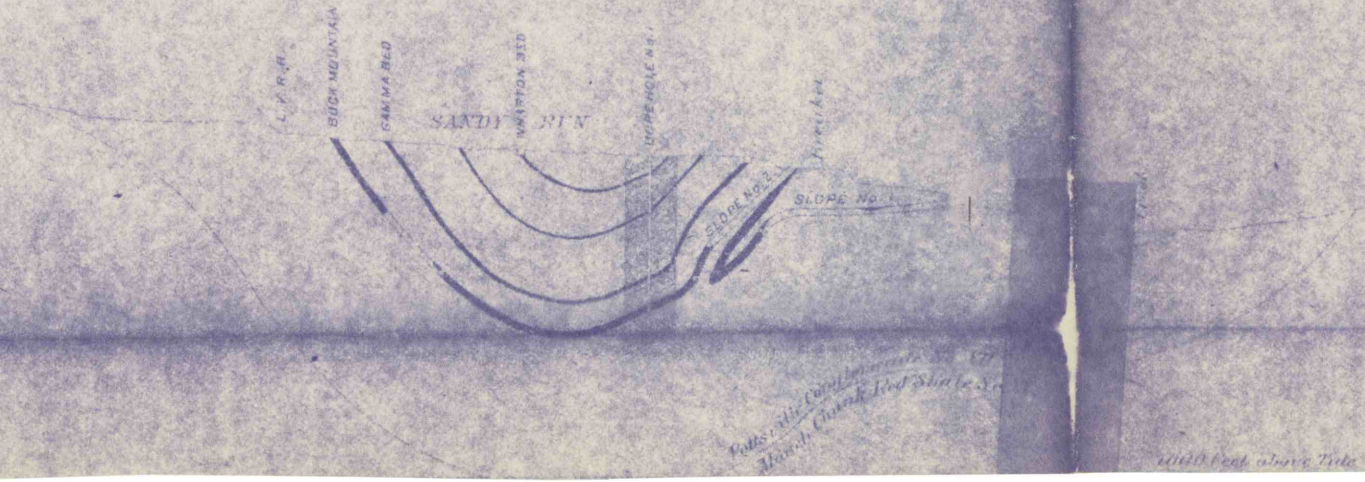

Bearing N. 15° 30' W.

