
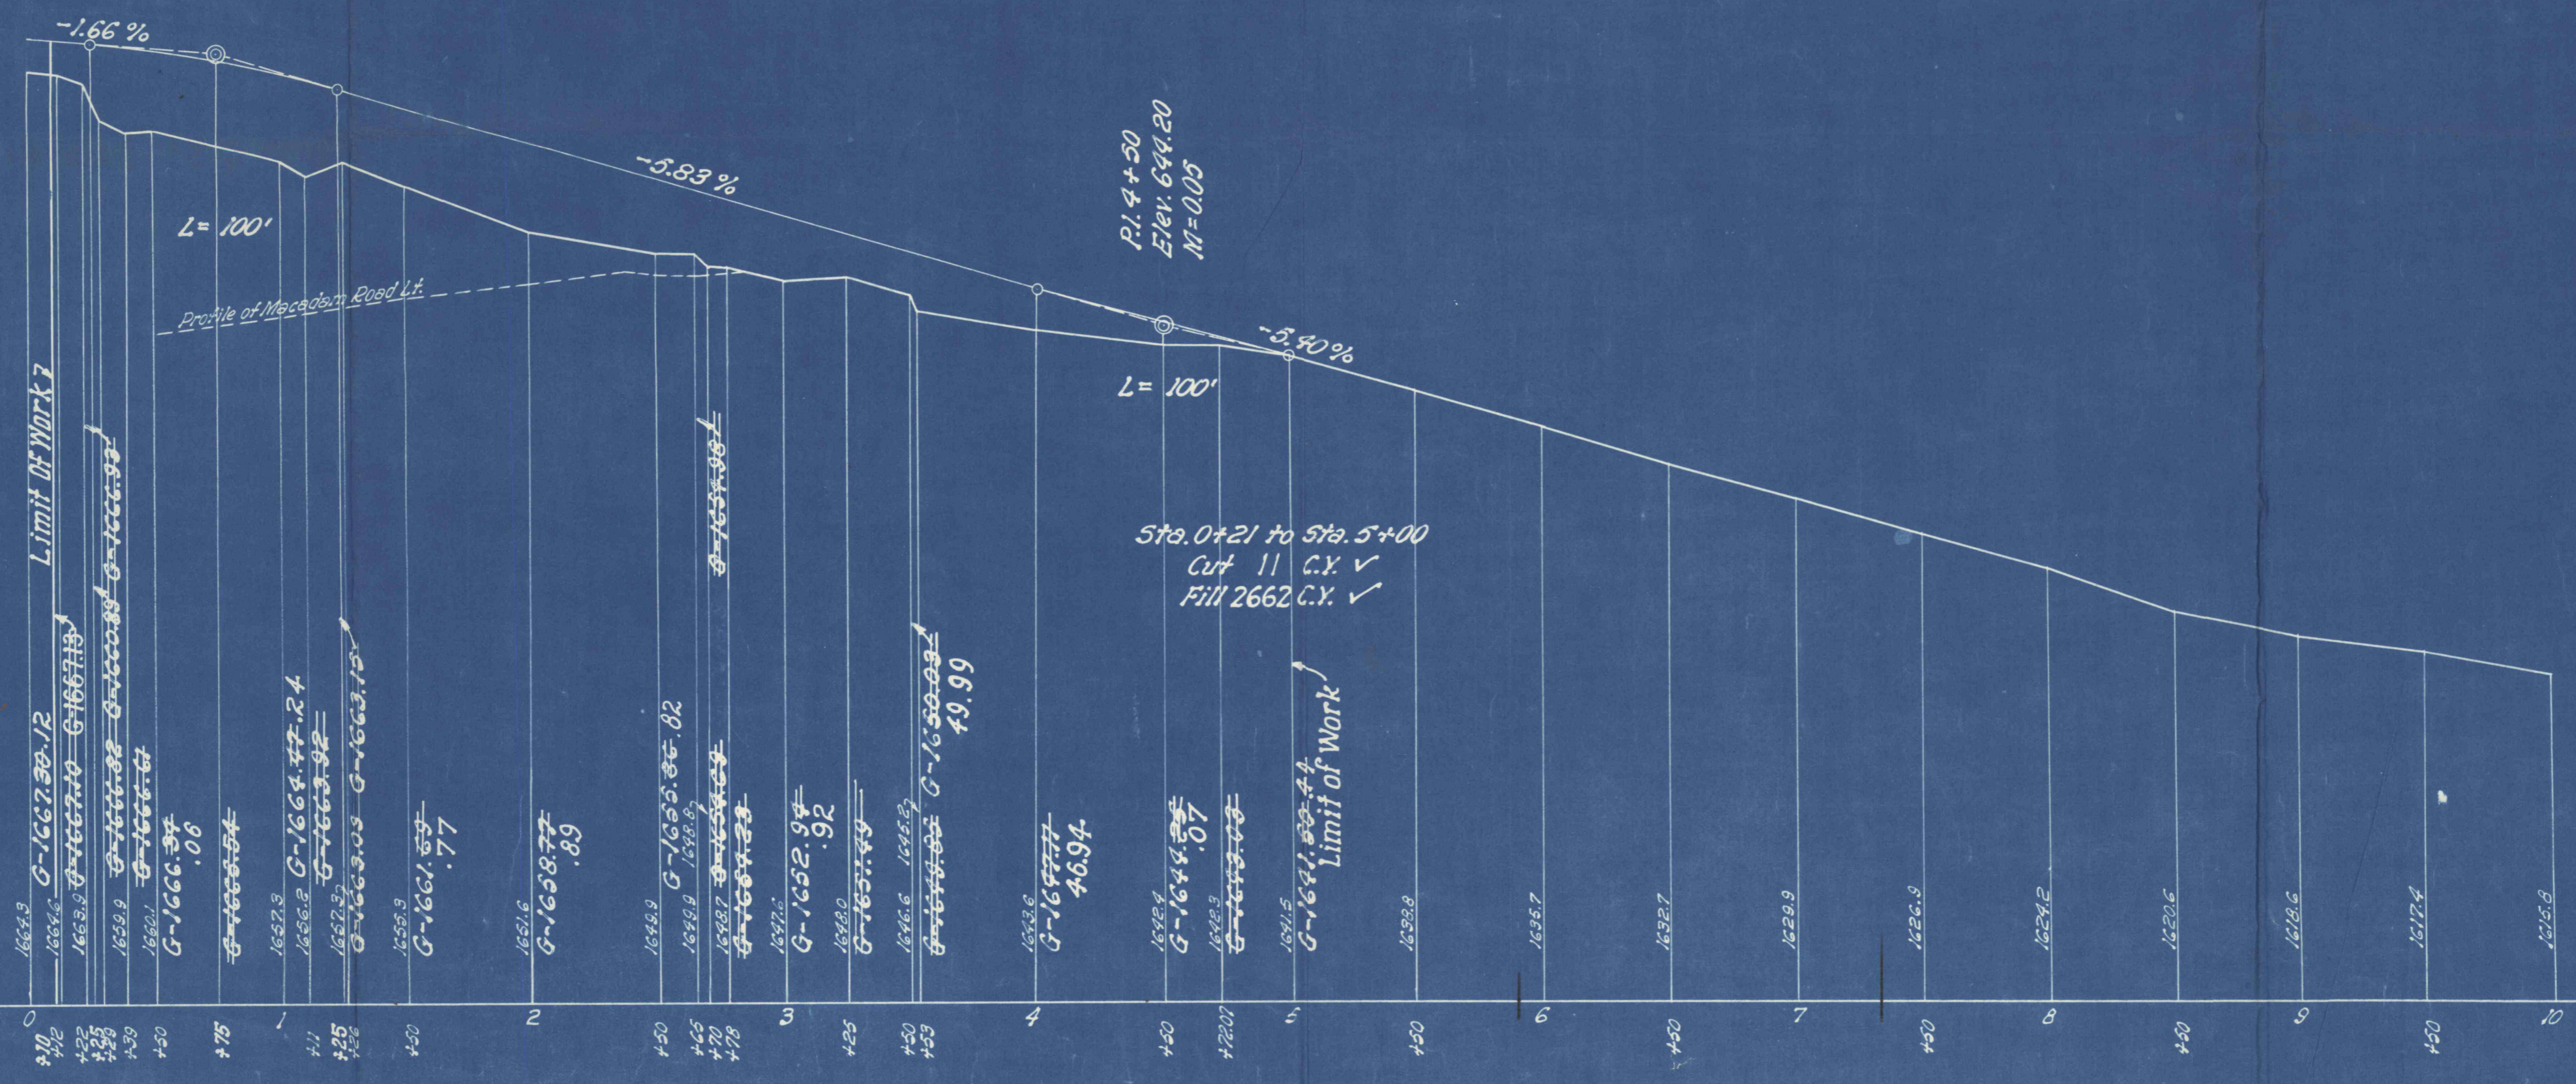


12" Oak
+20 (Main Line)

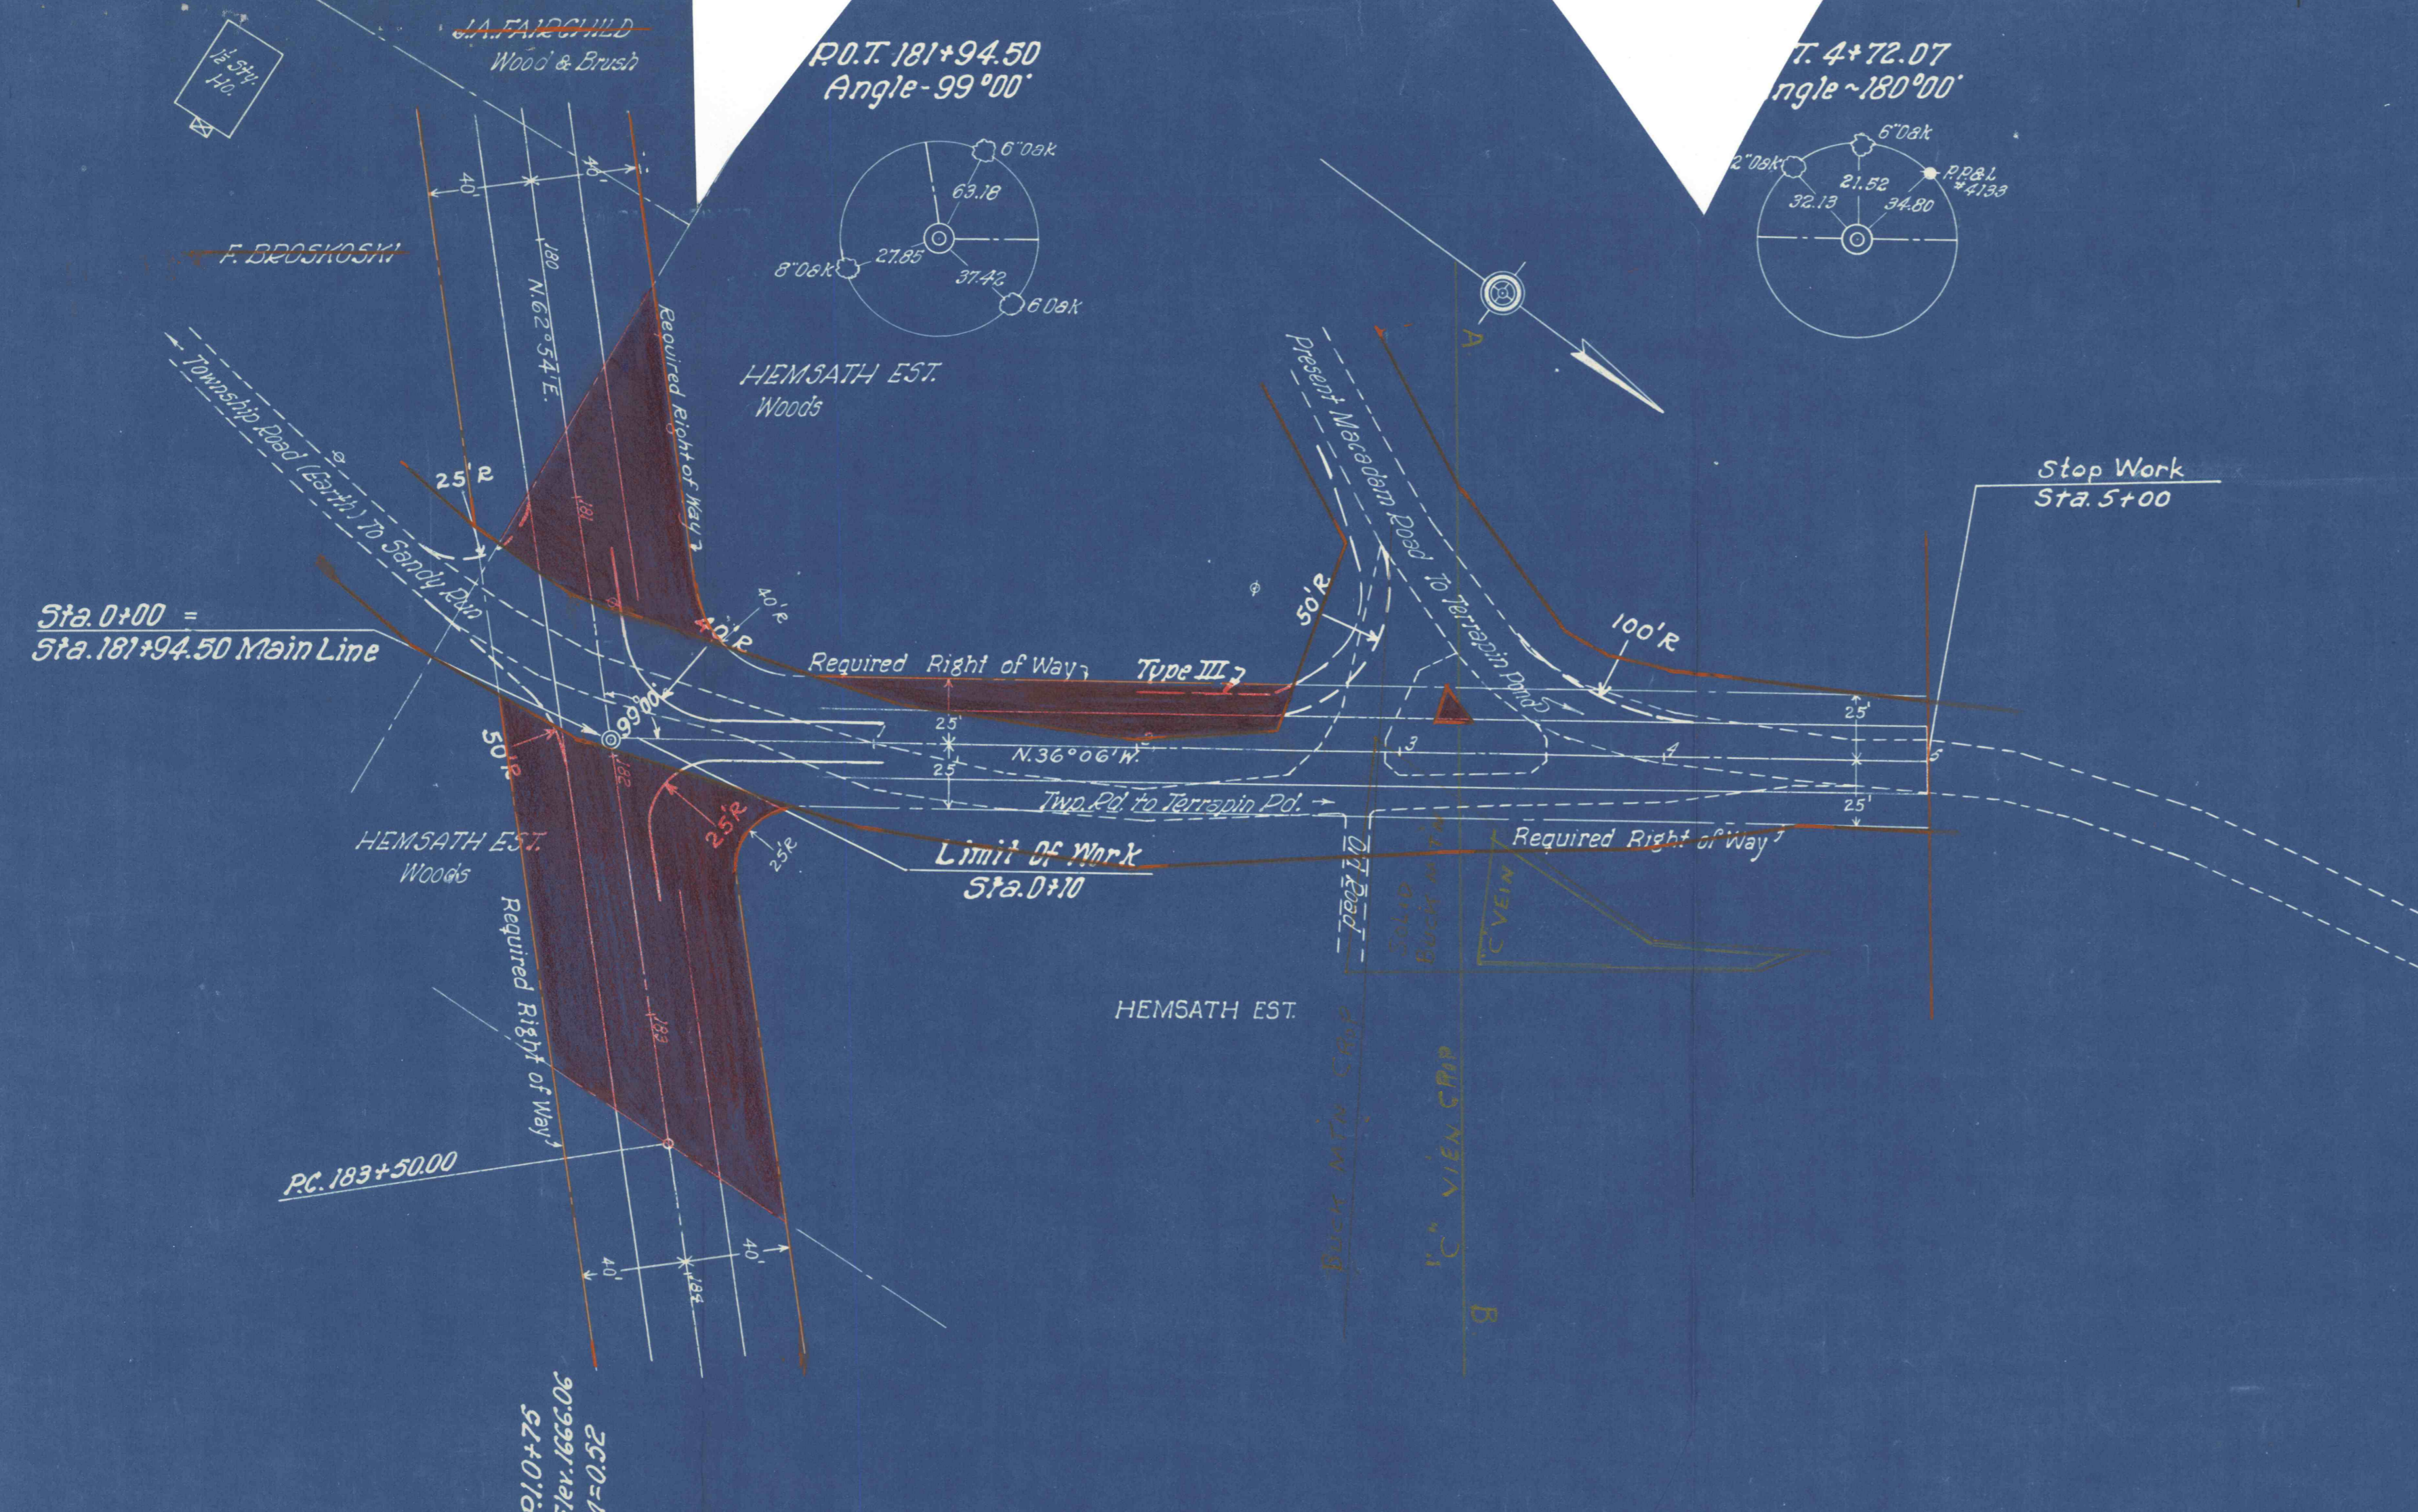

DATUM 1590

49.6
46.1