


90' ROCK COVER LIMIT
VIRGINIA-COAL

1ST MINED
APP. PROX. 1 YEAR

VIRGINIA-COAL

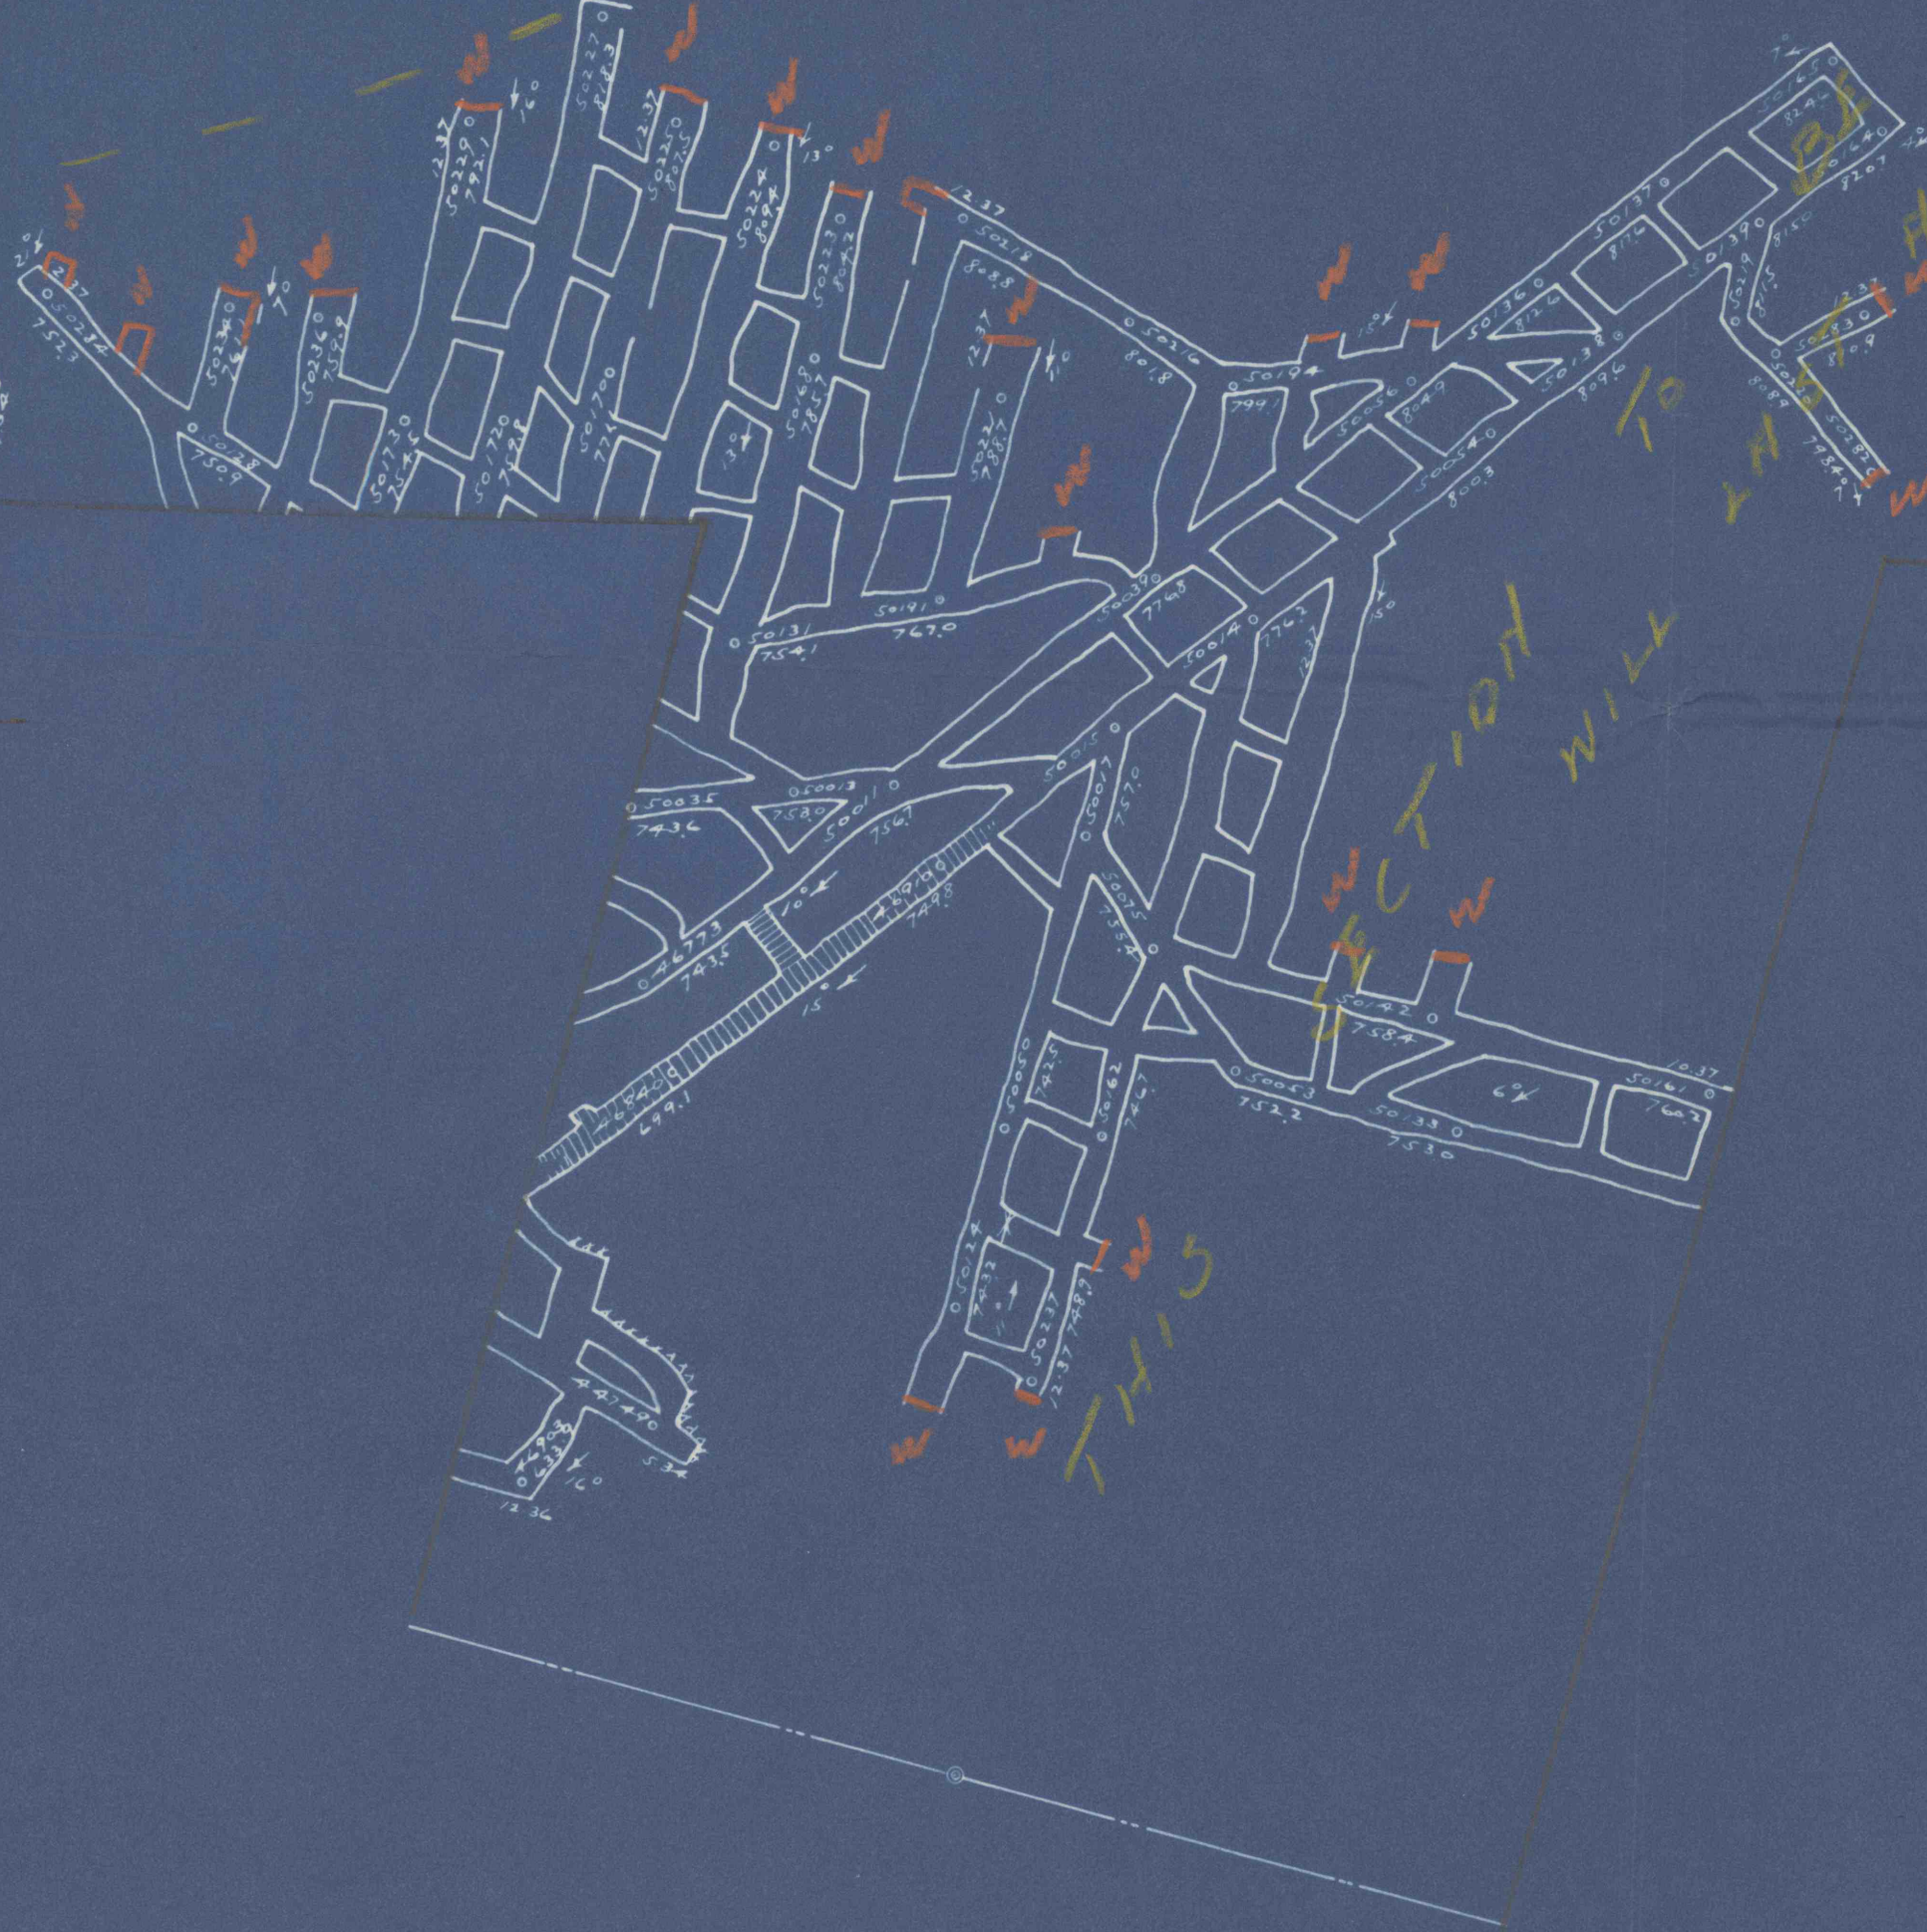


HILL

K.C. CO. HILLMAN-VEIN VEIN
K.C. CO. ELEVATIONS - 500' = TIDE
SCALE 1" = 100'
RED = PRESENT-WORKING-FACES,