


MIYERS

S 4500
W 800

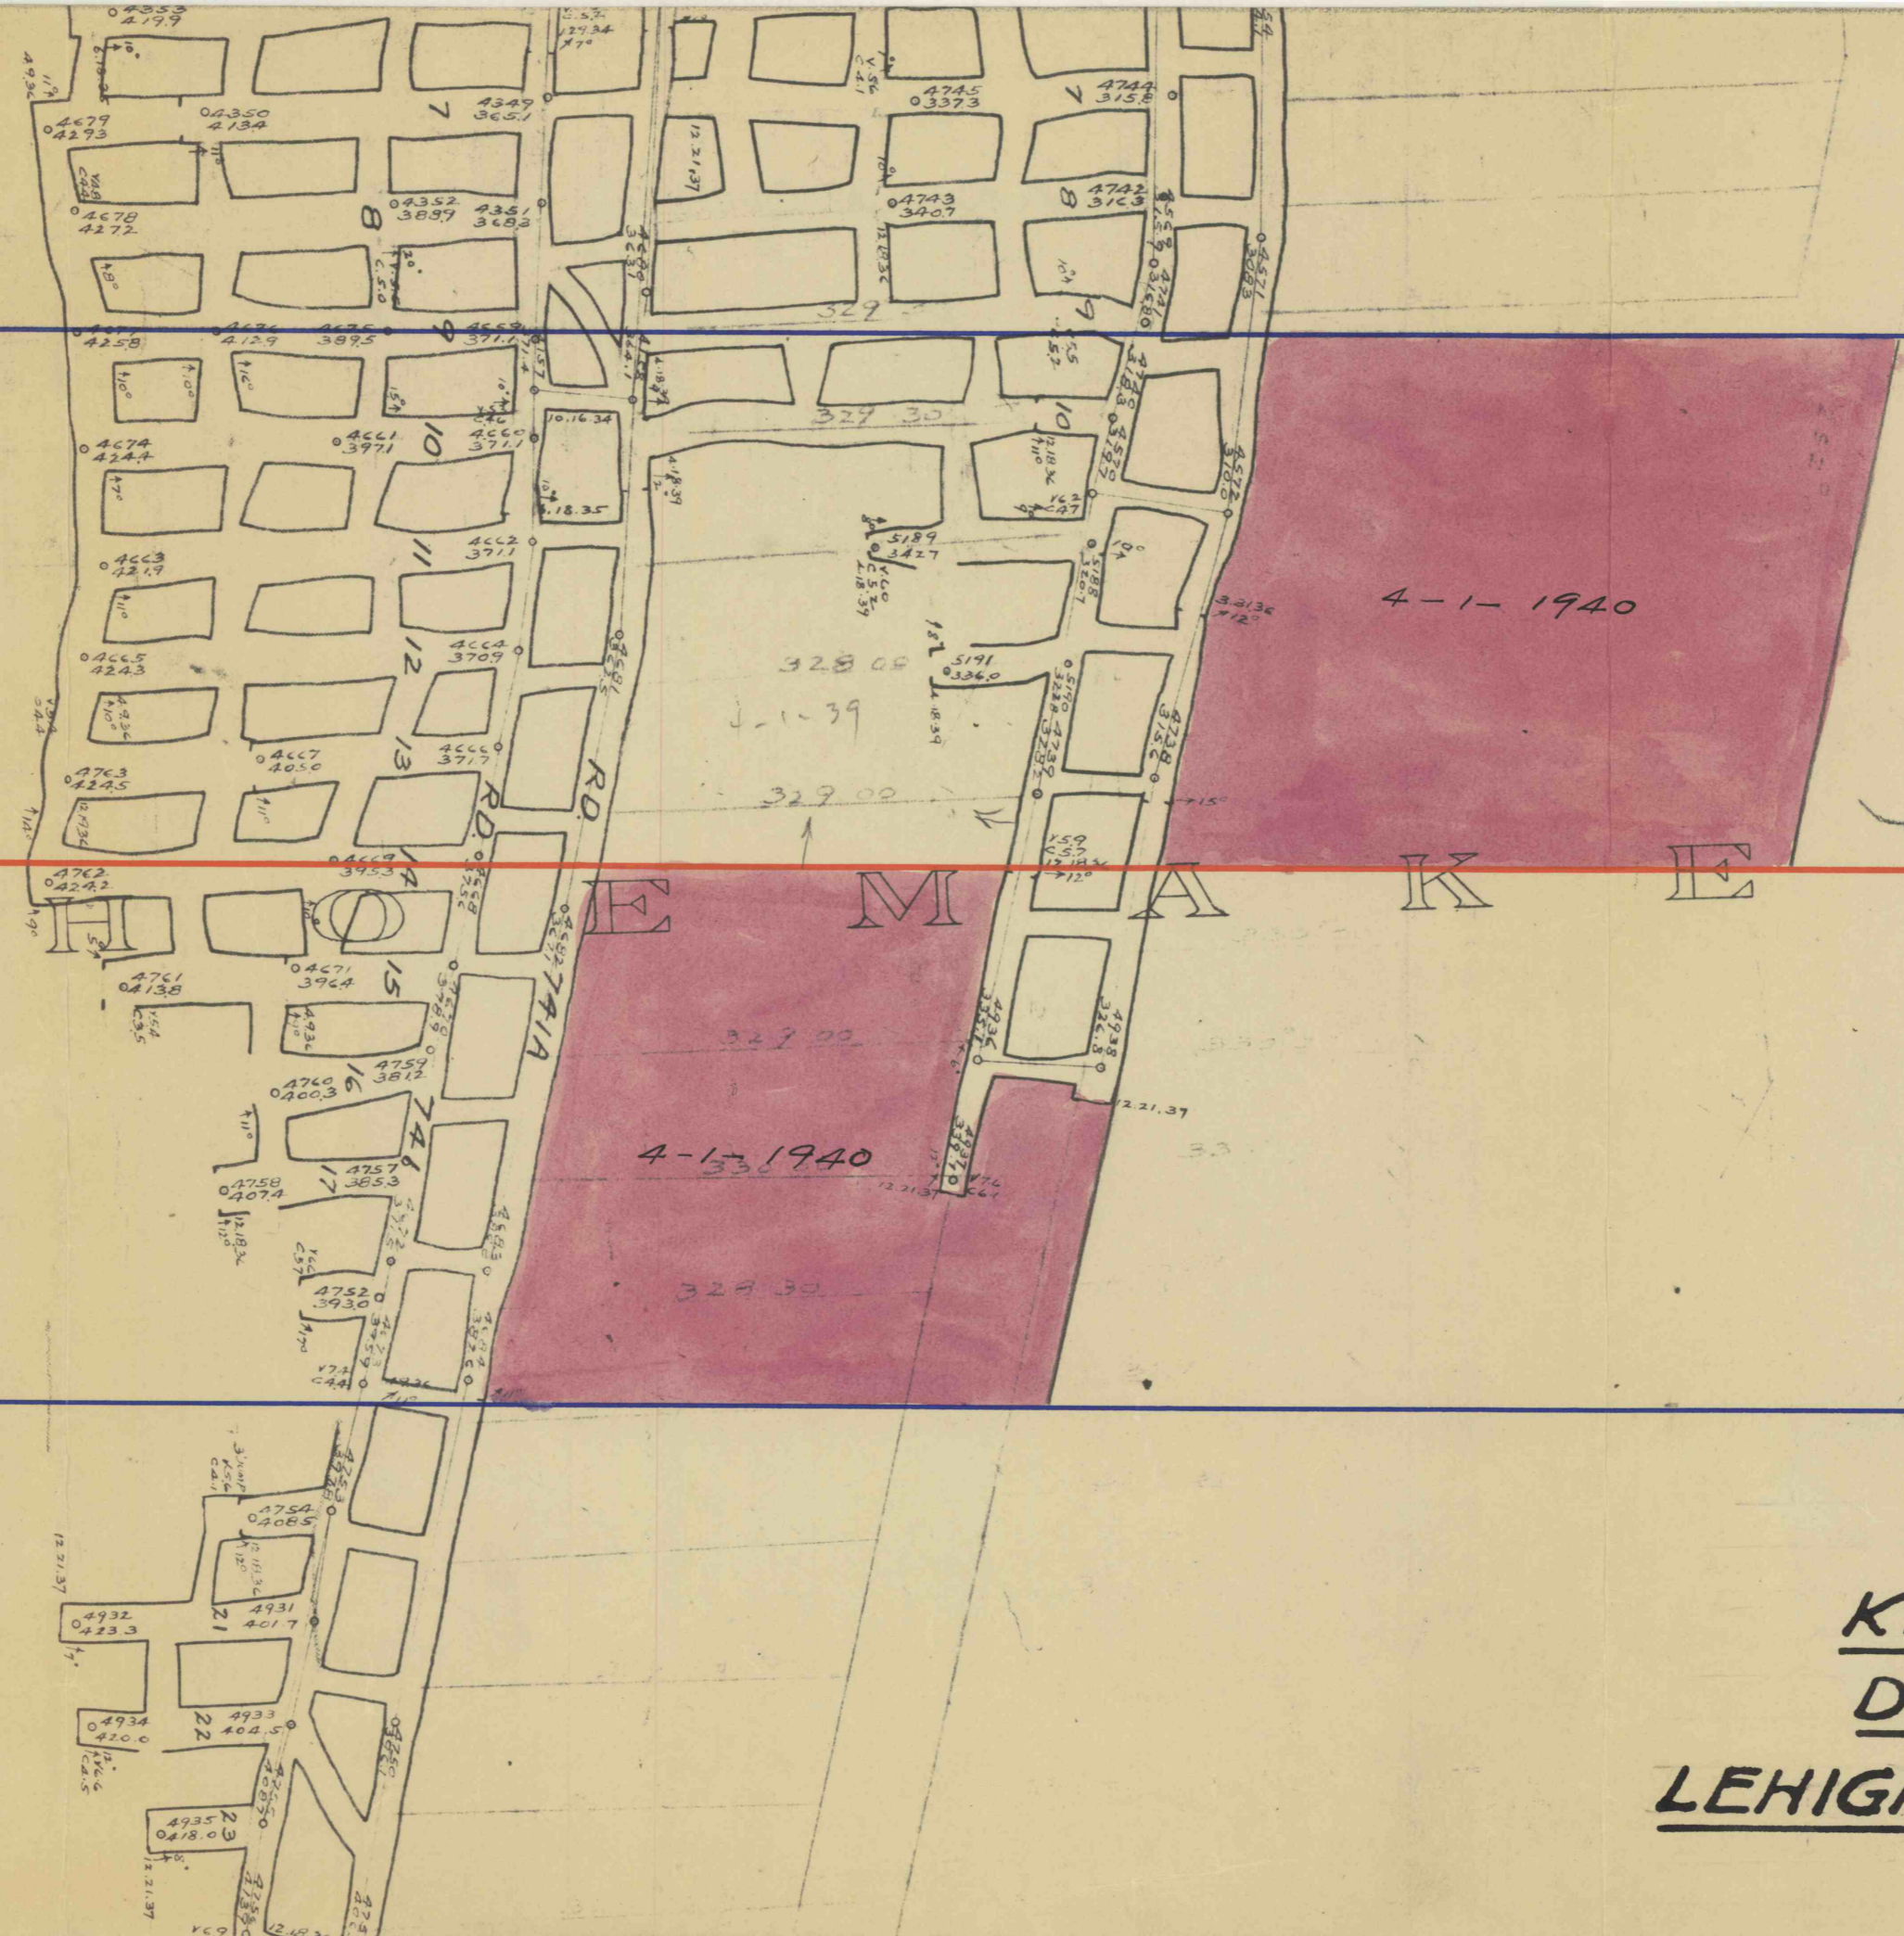

D. S. H.

Pierce St

ROUTE 40116
KINGSTON BOROUGH
DORRANCE COLLIERY
LEHIGH VALLEY COAL COMPANY
LANCE VEIN

W 7500