


DATUM 500 FEET BELOW TIDE.

HILLMAN VEIN  
SCALE 1"=100'

ROUTE No 40116  
KINGSTON BOROUGH & WILKES-BARRE CITY  
DORRANCE COLLIERY  

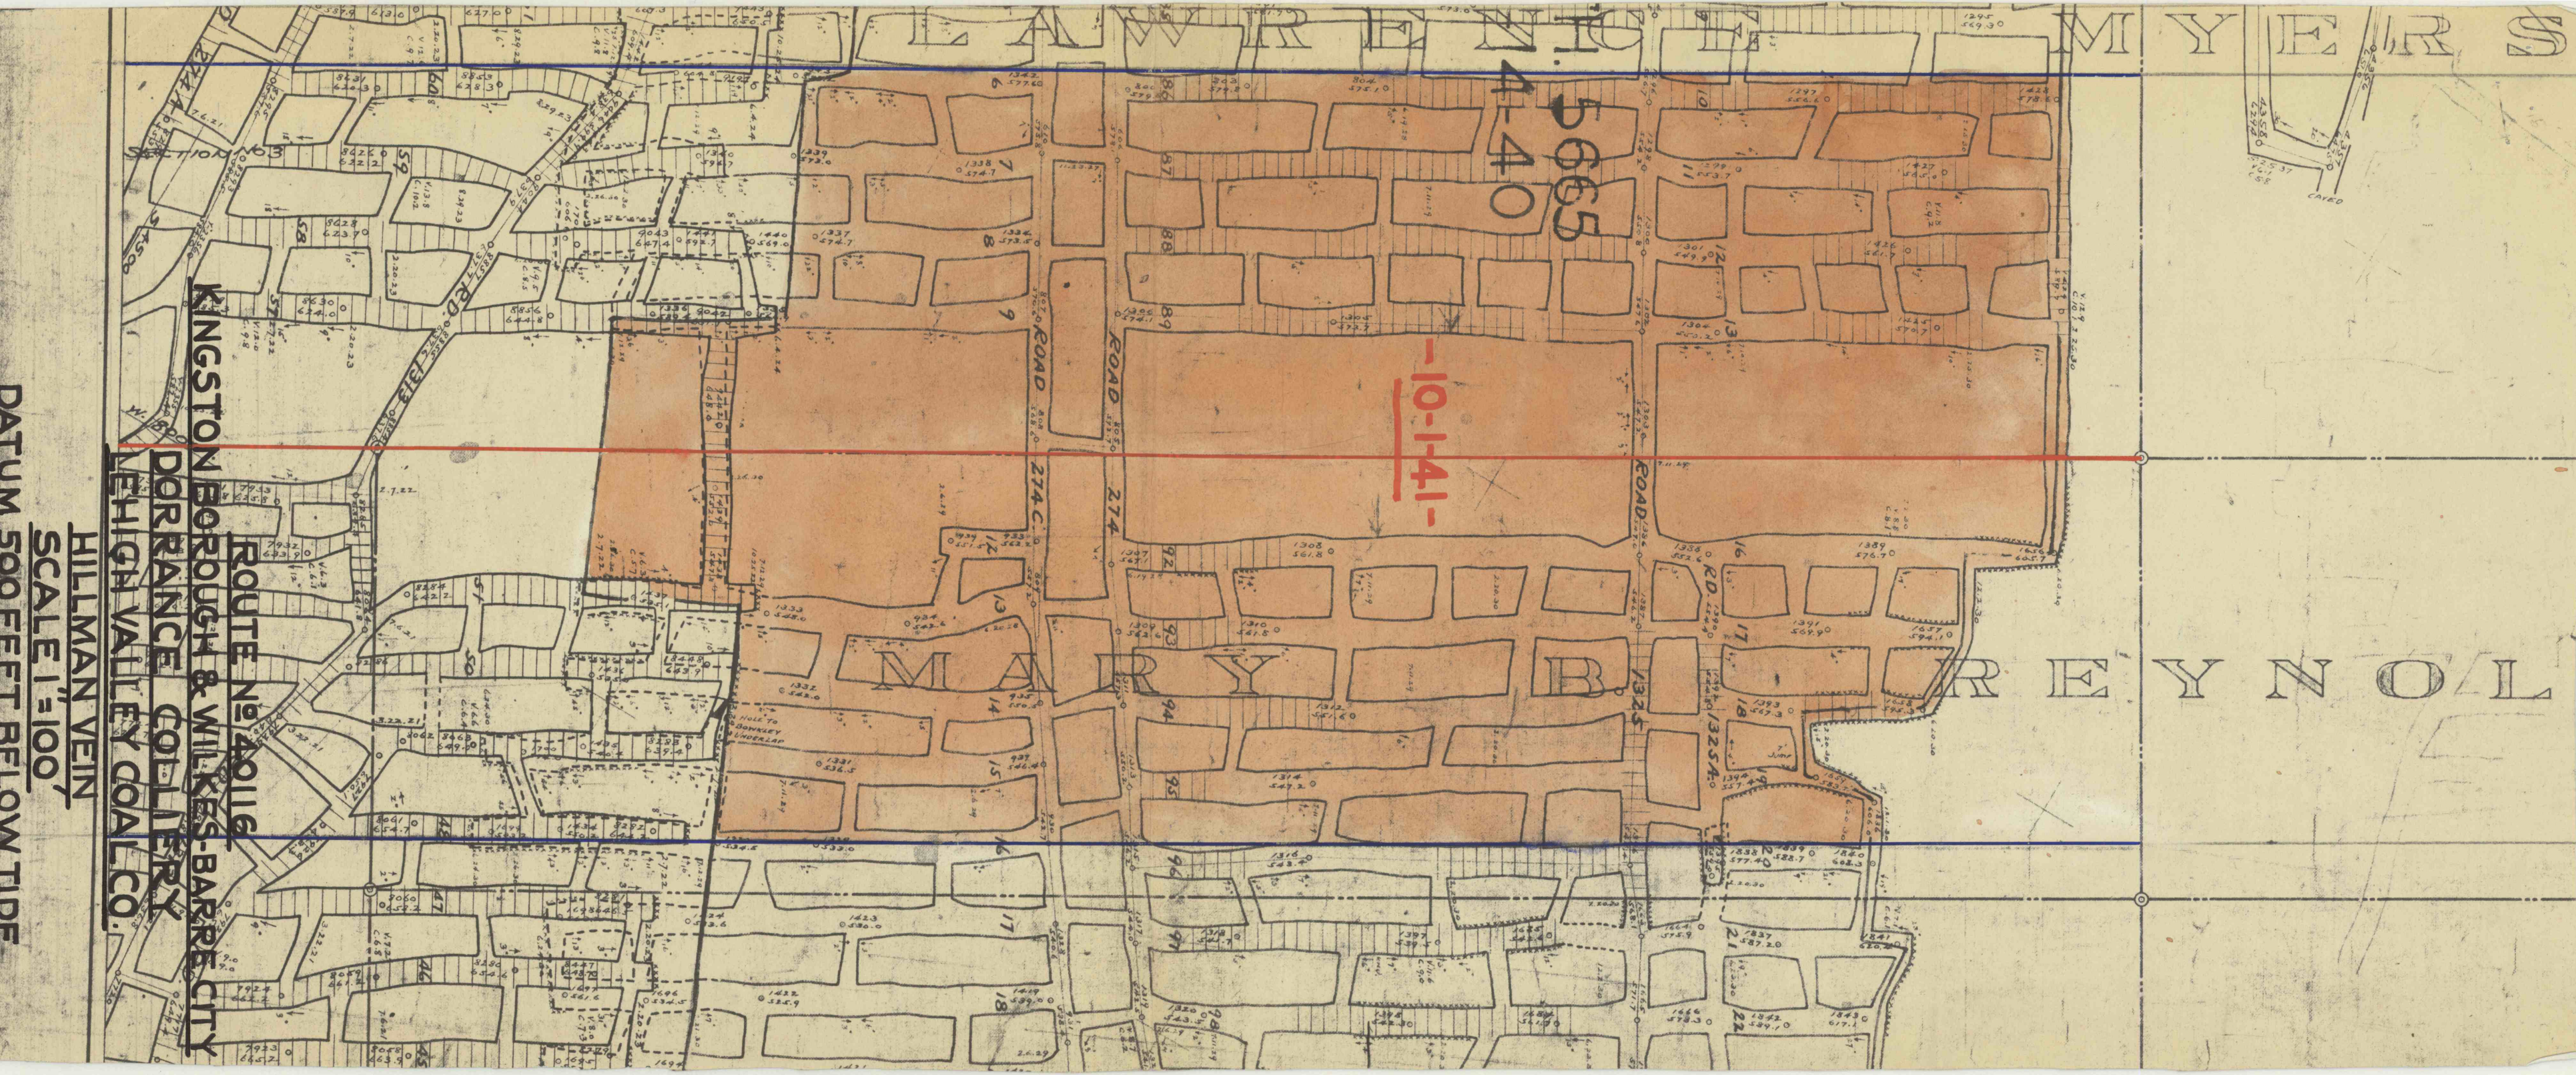

5665  
4-40

10-1-41

DORRANCE

REYNOL