


APPROVED BARRIER PILLAR H.W.M. To D.L.D. 5-26-45

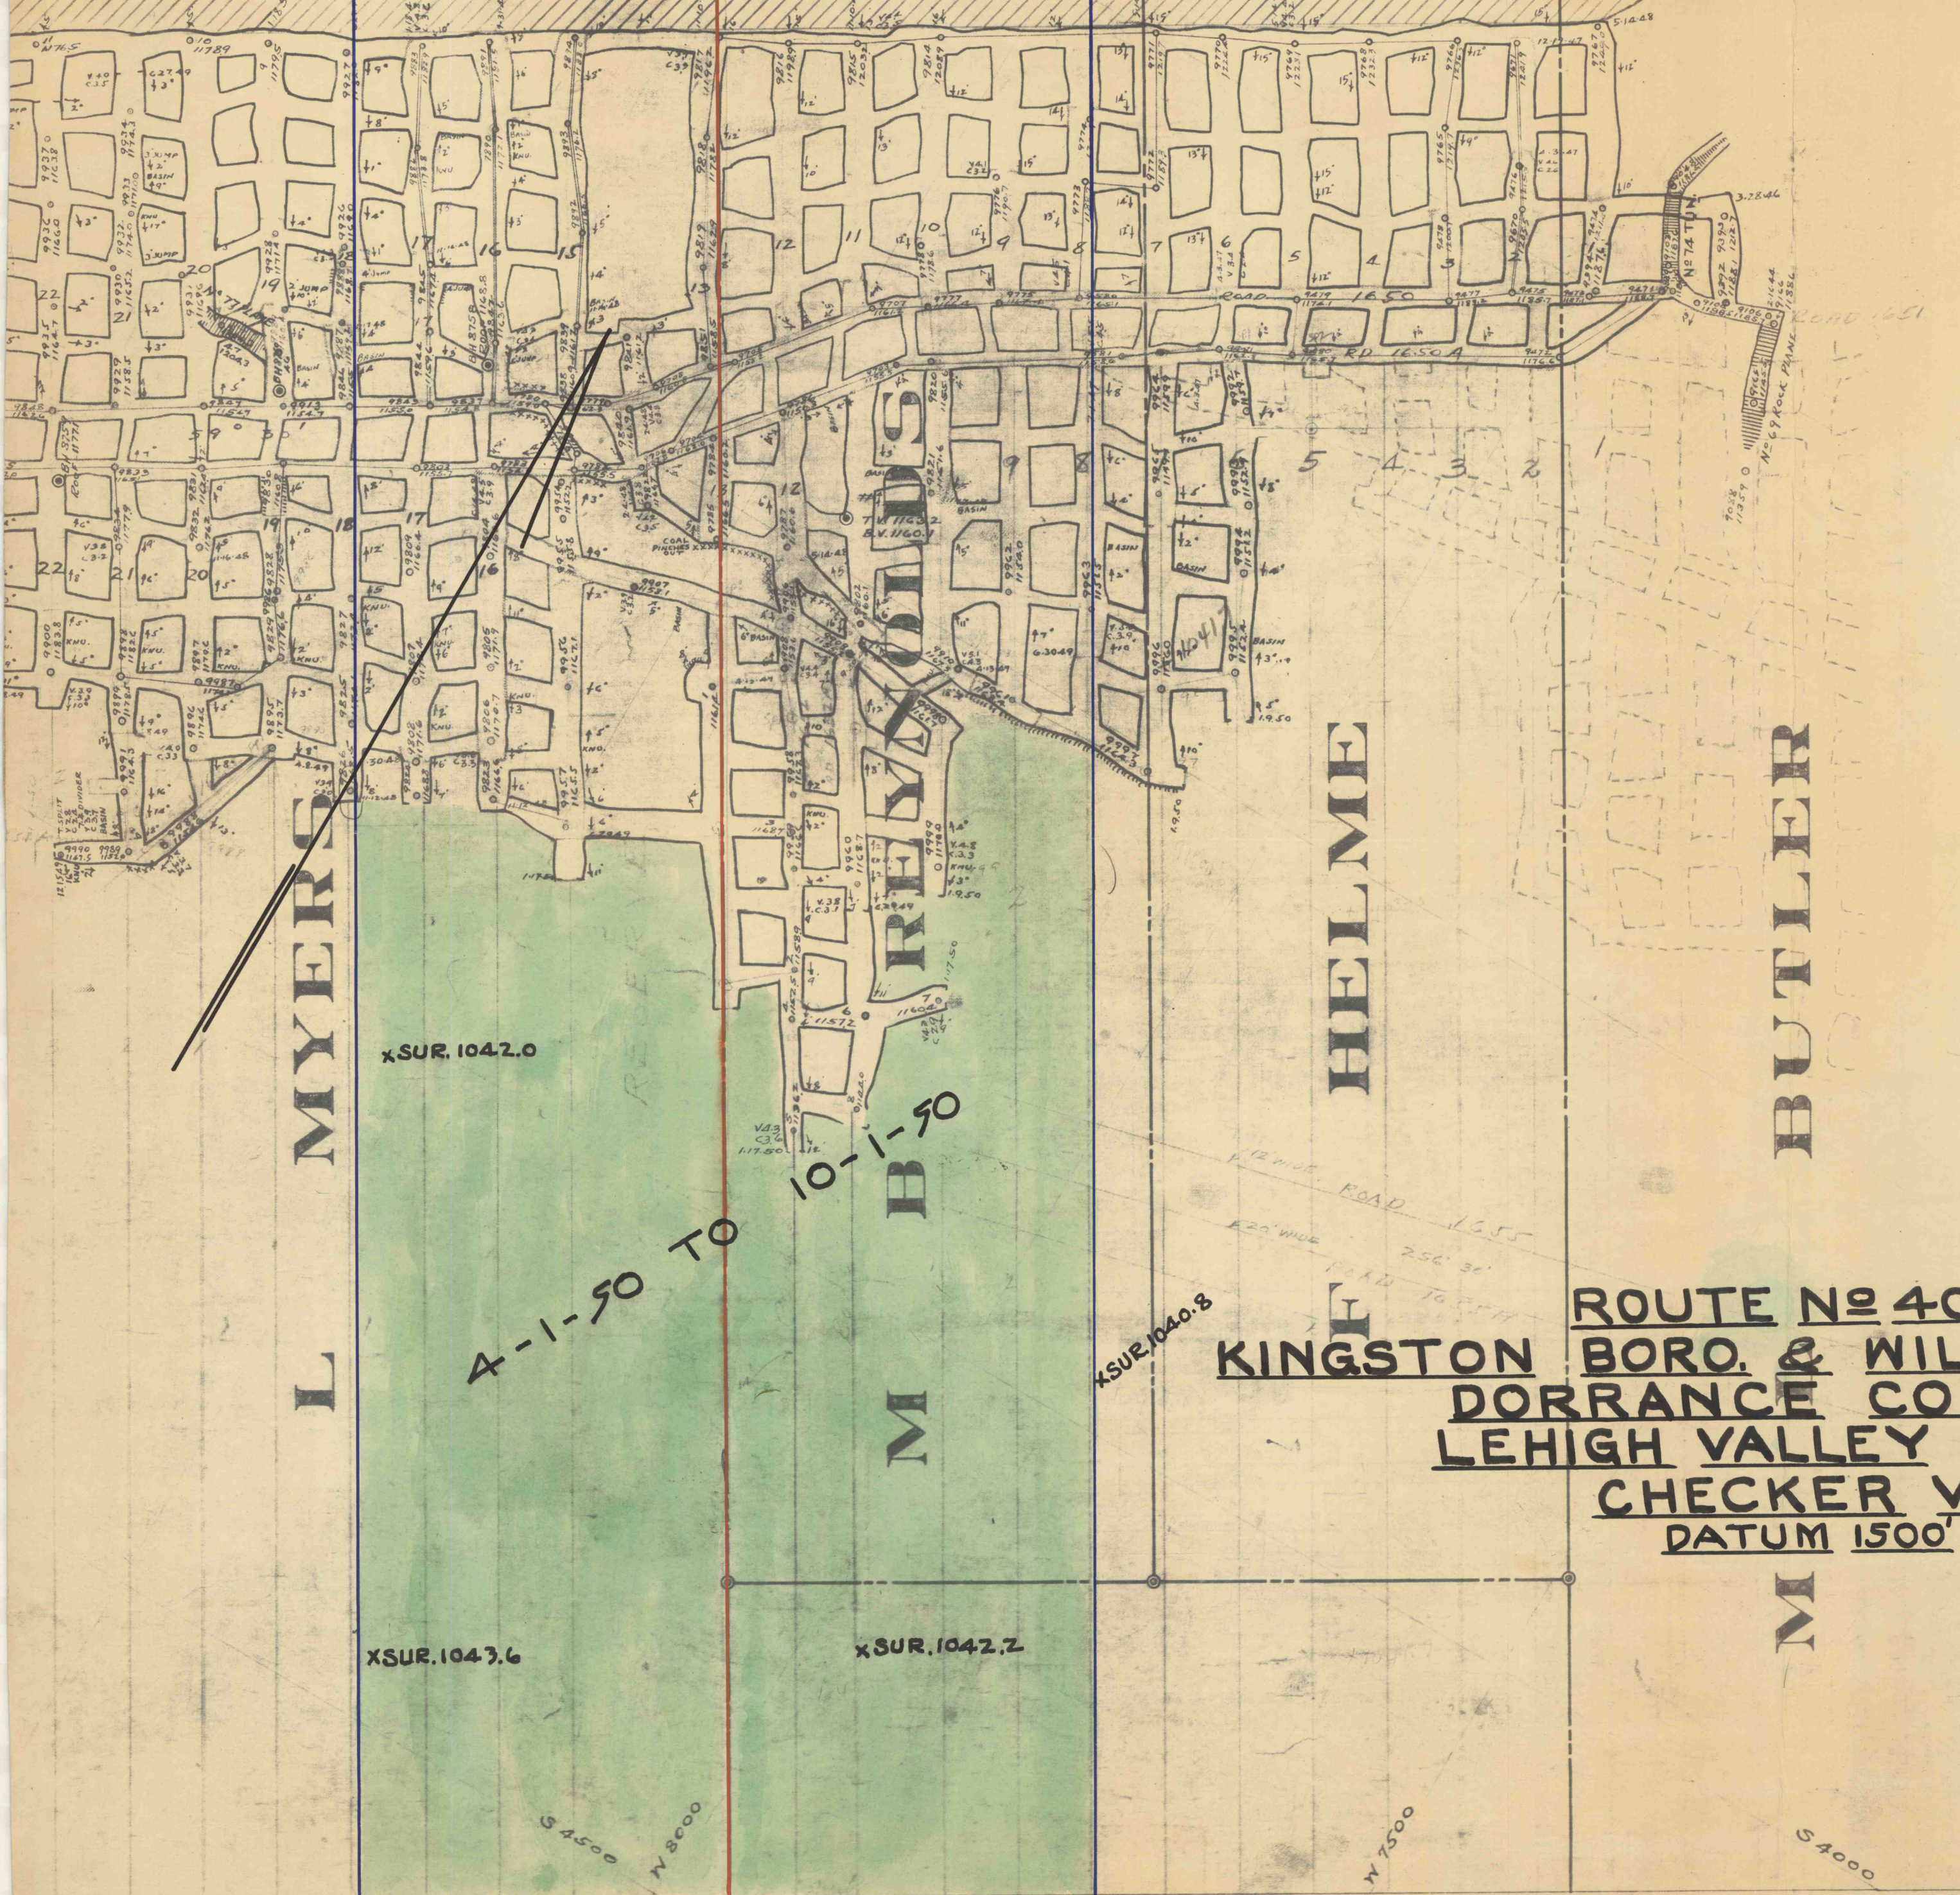

7150
© TV 1162.5
BY 1160.9

ROUTE No 4016
KINGSTON BORO. & WILKES-BARRE CITY
DORRANCE COLLIERY
LEHIGH VALLEY COAL CO.
CHECKER VEIN
 DATUM 1500' BELOW TIDE.
 SCALE 1"=100.

2

S 4500
 N 8000
 N 7500
 S 4000
 N 7000