


SUR.10460X

SUR1048.3X

4-1-48 - 10-1-48.

X SUR 1031.0

X1030.1 SUR.

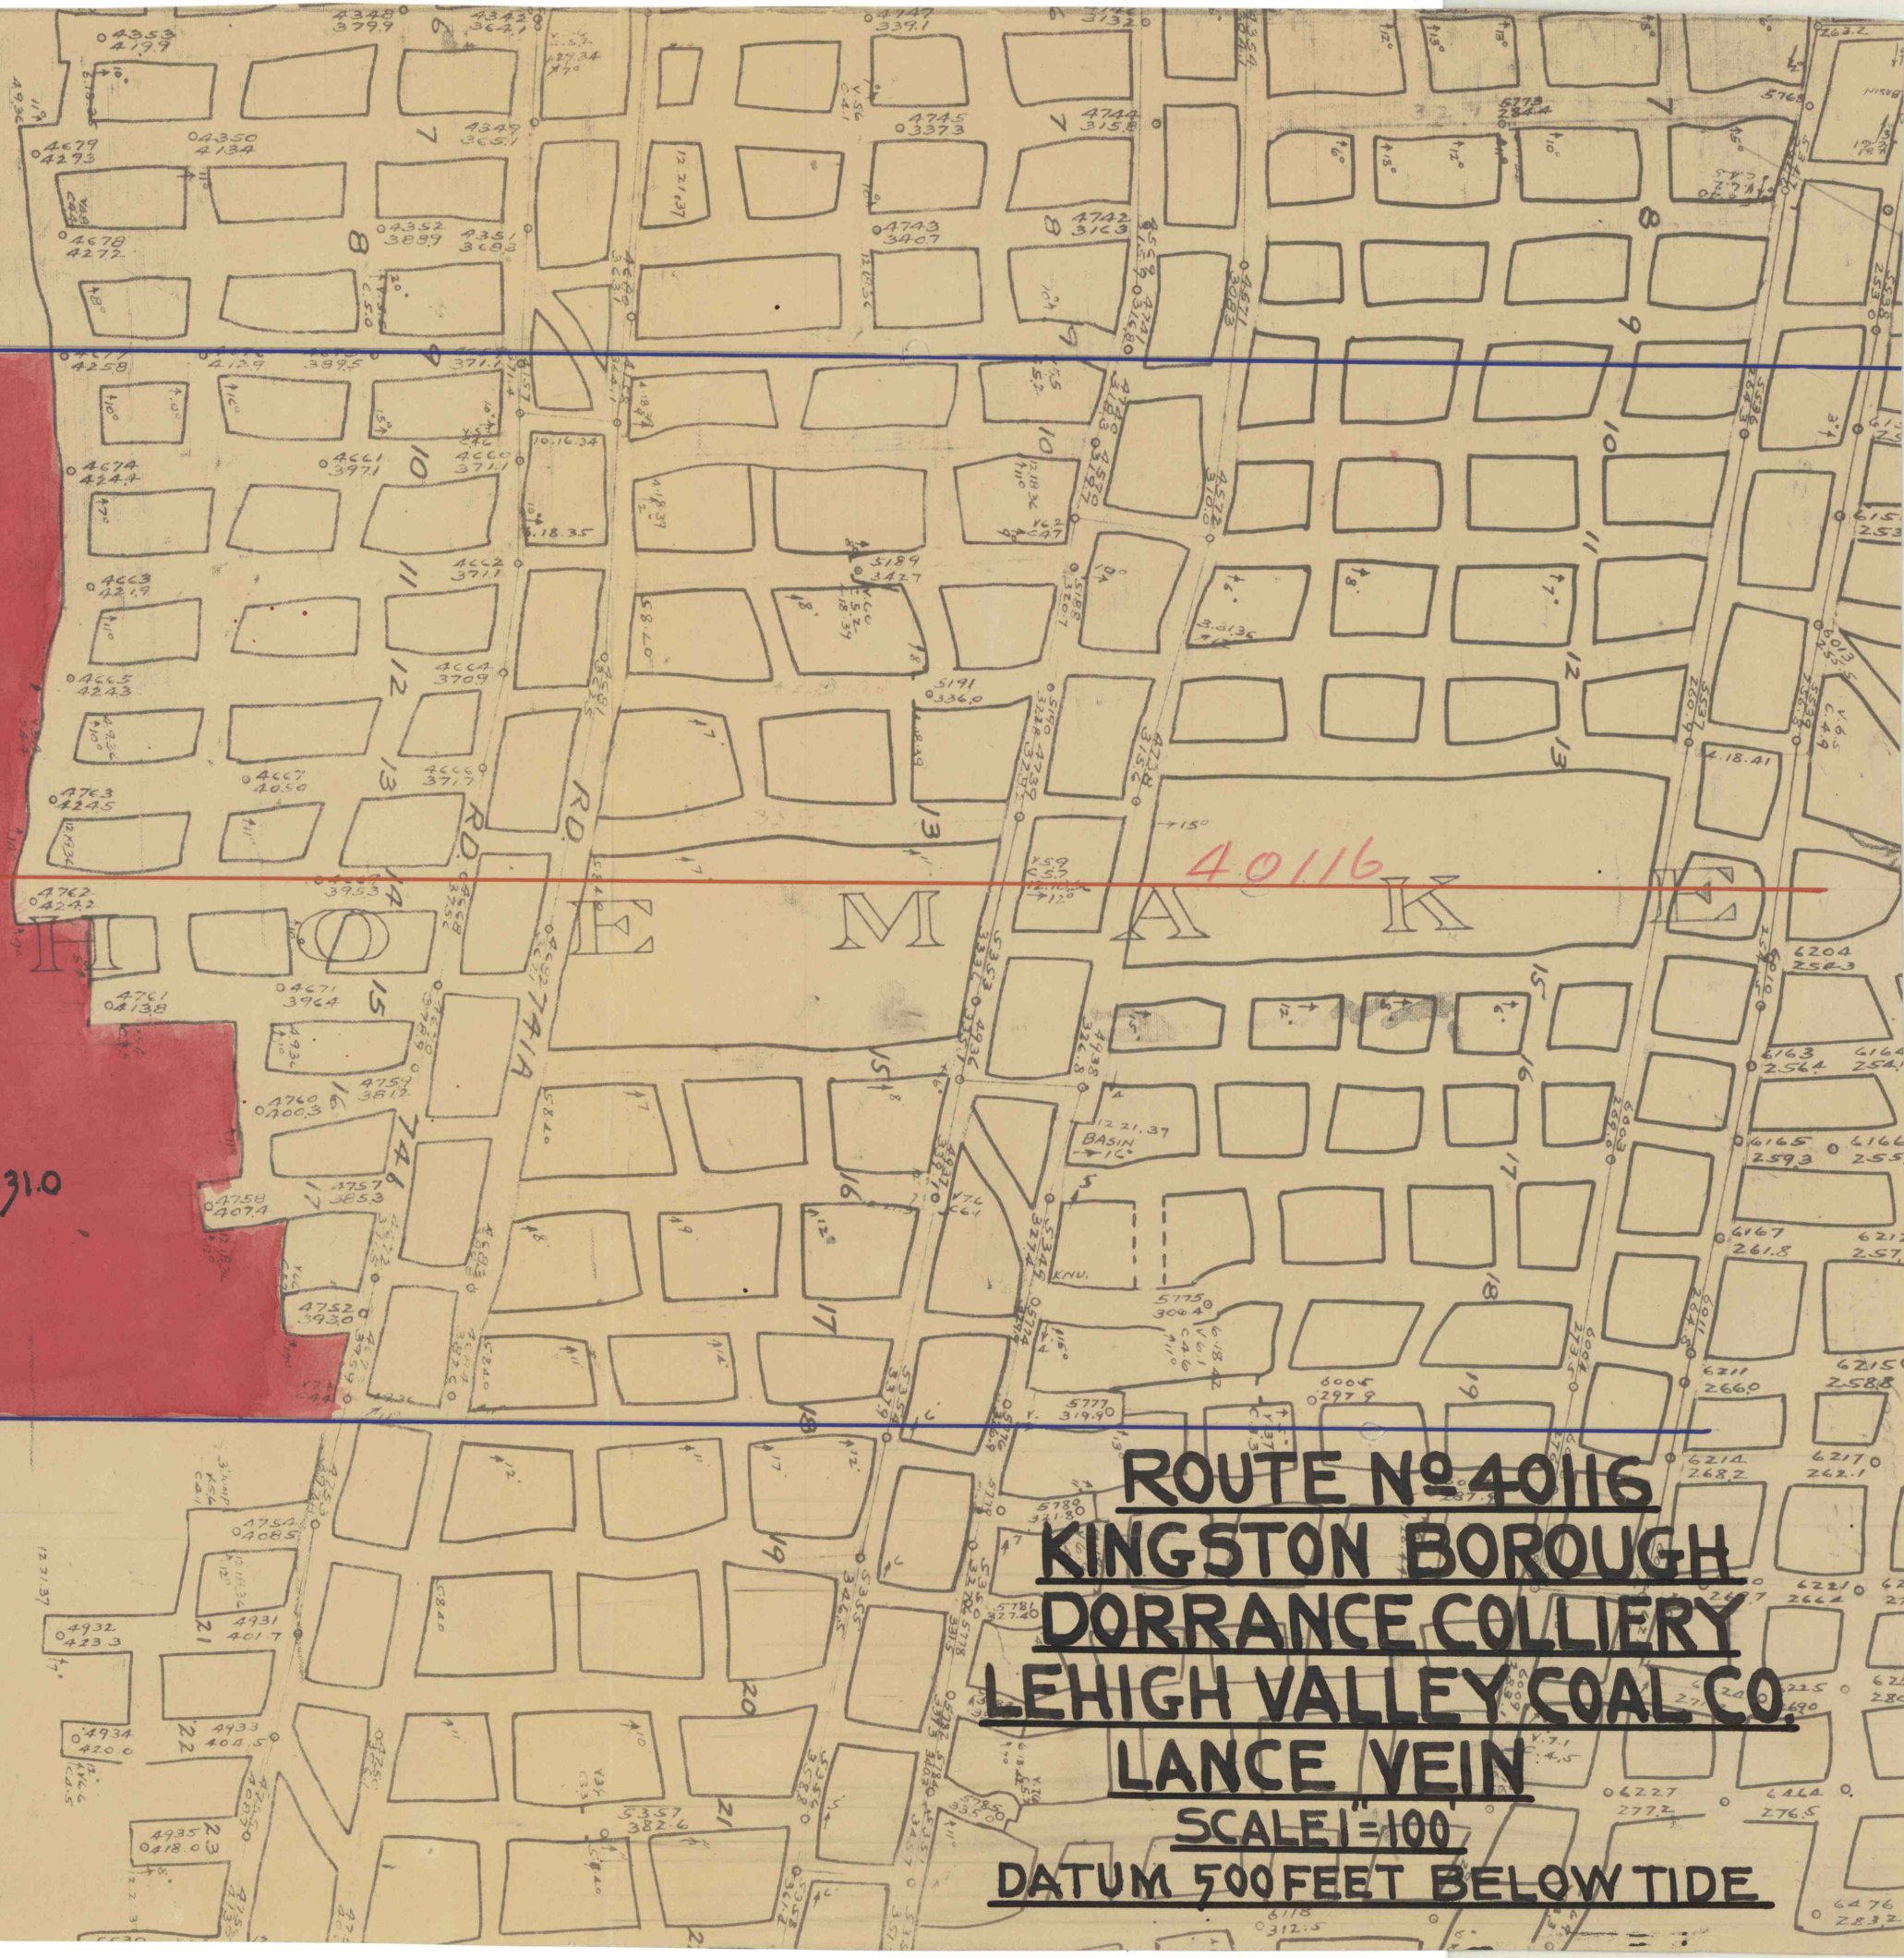

**ROUTE No 40116**  
**KINGSTON BOROUGH**  
**DORRANCE COLLIERY**  
**LEHIGH VALLEY COAL CO.**  
**LANCE VEIN**  
**SCALE 1"=100'**  
**DATUM 500 FEET BELOW TIDE**