

SUR. 1017.6

SUR. 1016.0

10-1-47


SUR. 1020.9

TO 4-1-48

SUR. 1016.3

SUR. 1014.6

R L E S

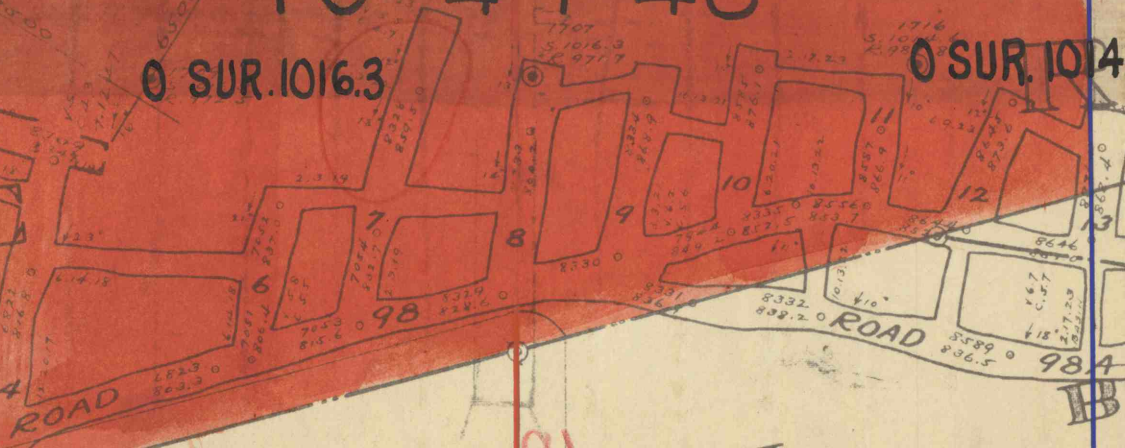

R K

ROUTE No 40,116

KINGSTON BORO. AND WILKES-BARRE CITY

DORRANCE COLLIERY

LEHIGH VALLEY COAL CO.

ABBOTT VEIN

SCALE 1"=100'

DATUM 500' BELOW TIDE