


LR 40116 A10  
Luz Co.

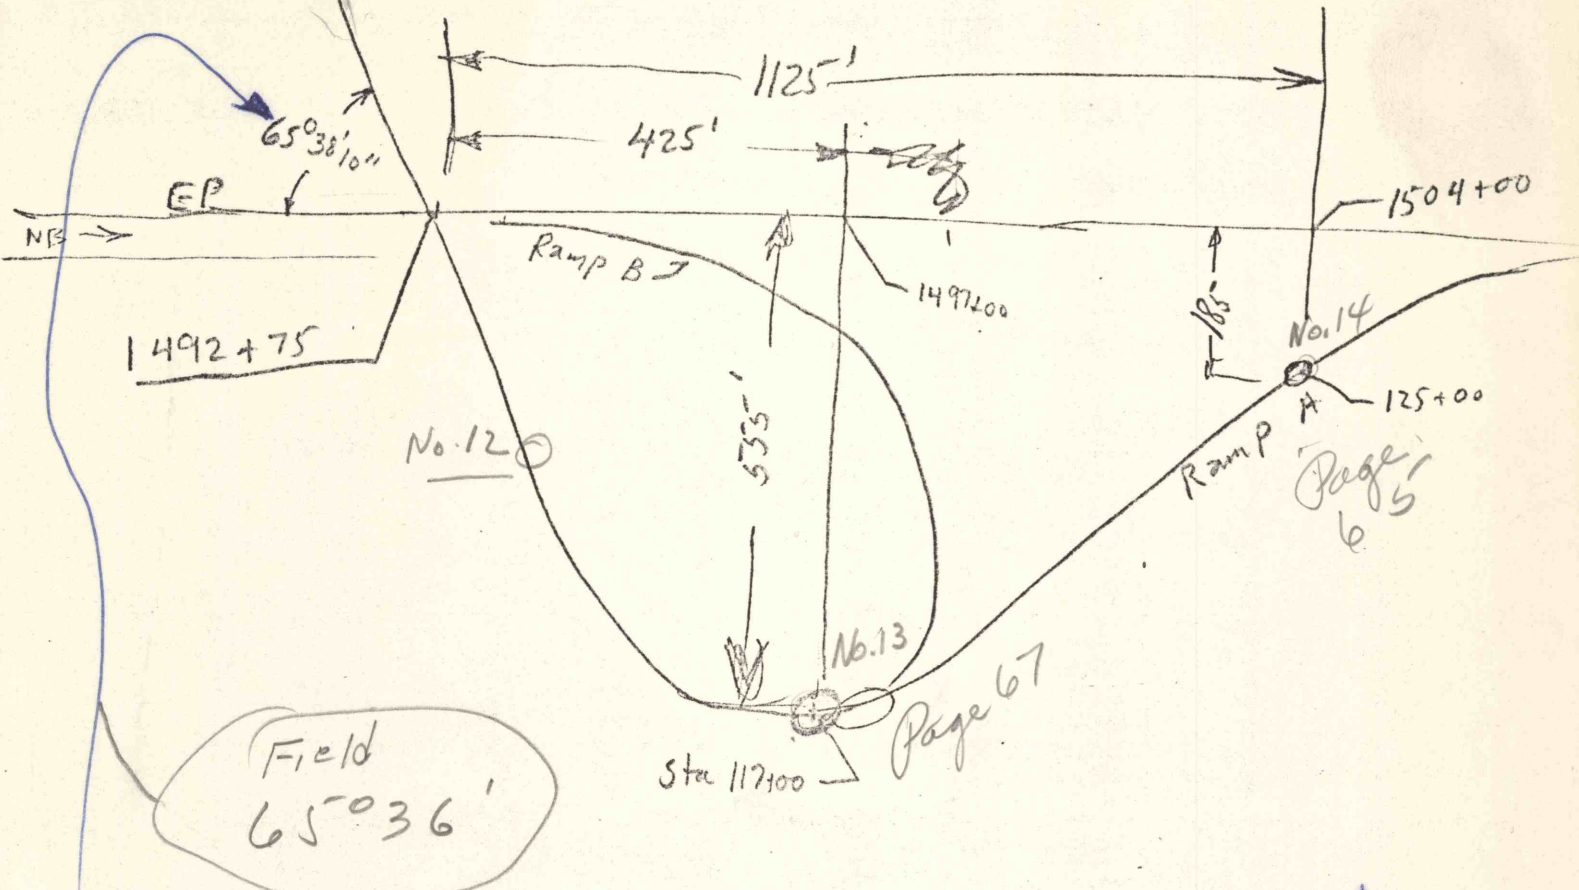

Jo Lewis  
Calculated this  $\checkmark$

11/5/80