




EDWARDSVILLE BOROUGH

KINGSTON BOROUGH

PRINGLE BOROUGH

DELAWARE LACKAWANNA RAILROAD

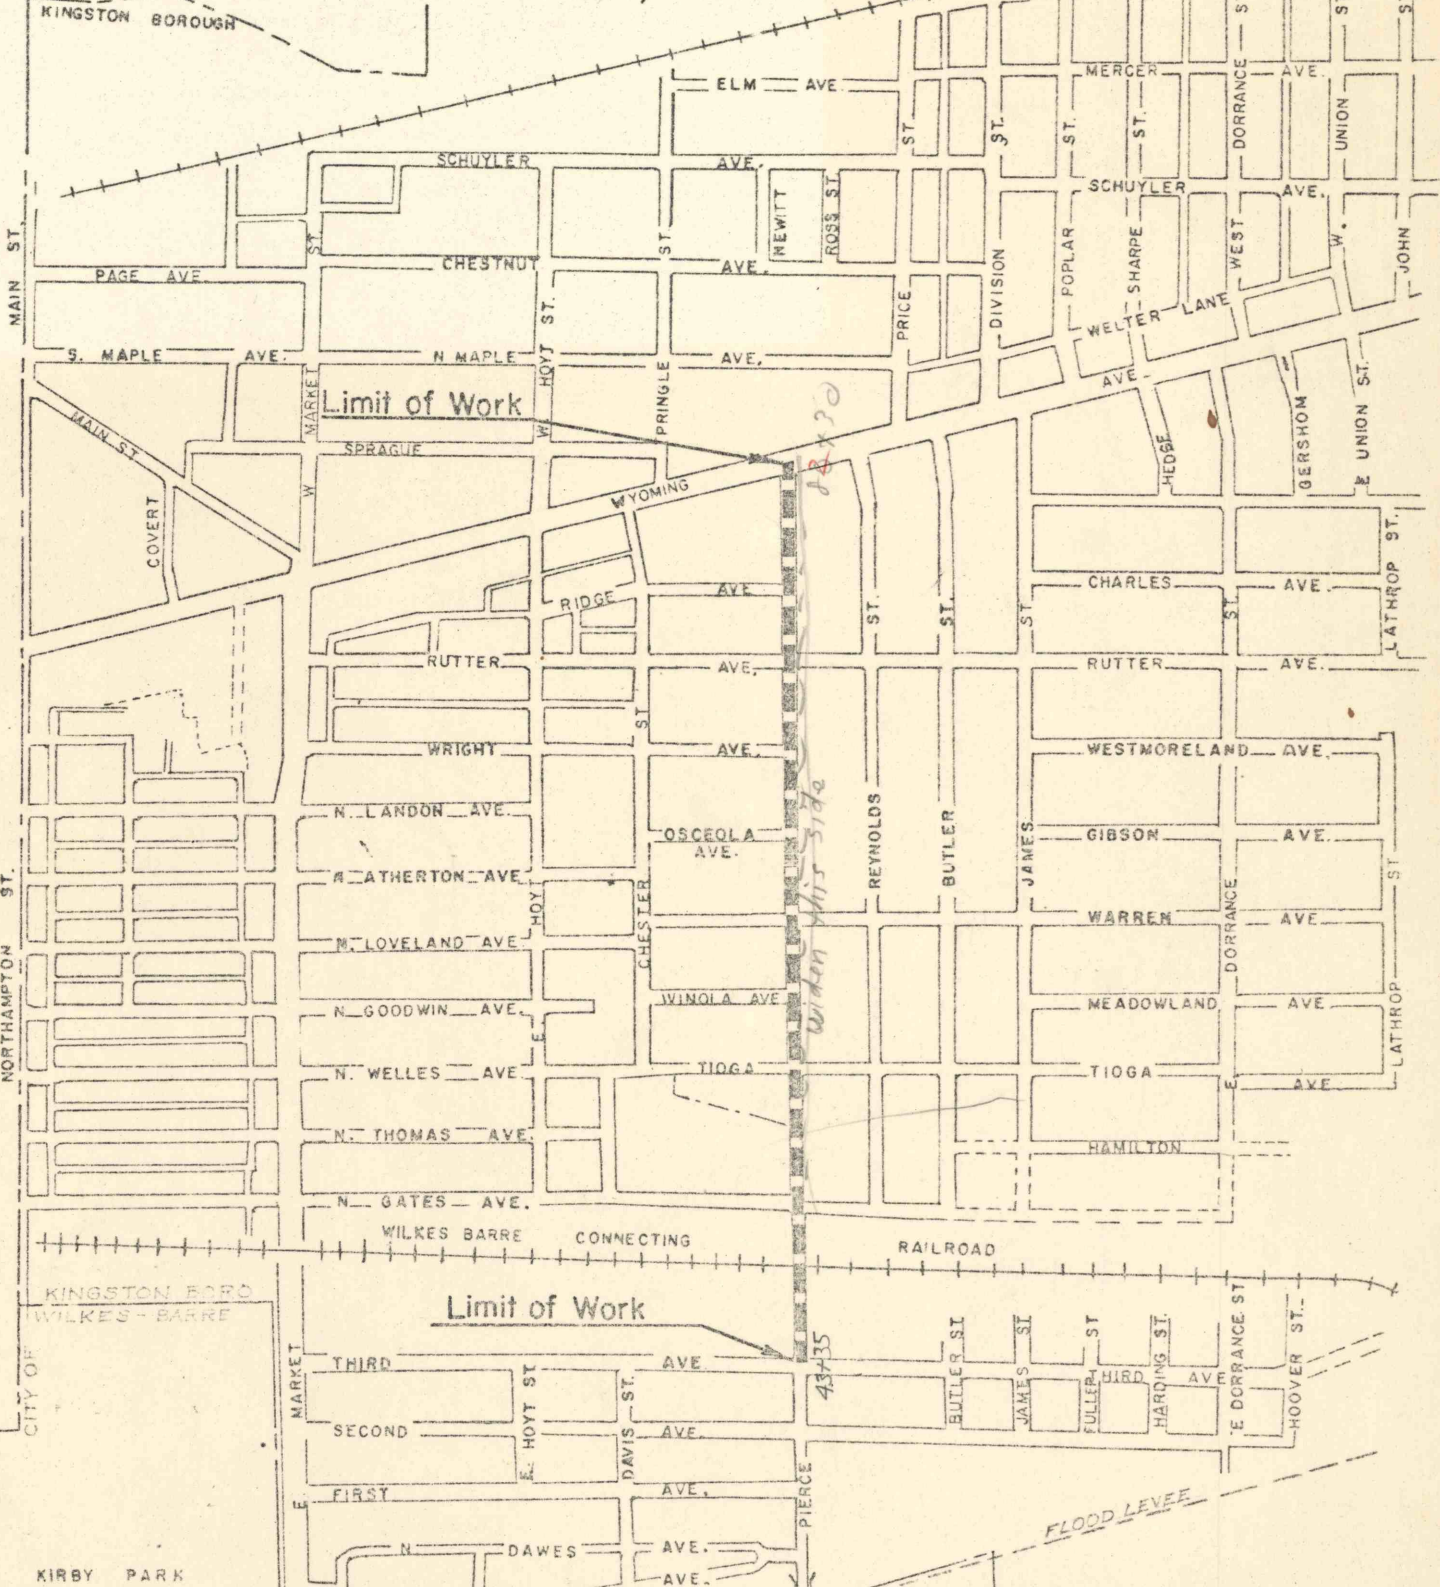

Limit of Work

Limit of Work

28x30

Widen this side

43735

Location Map

L.R. 40116 - Pierce Street

Kingston Borough

Scale: 1" = 800'