


RESERVE THIS MARGIN TO PASTE PRINT ON

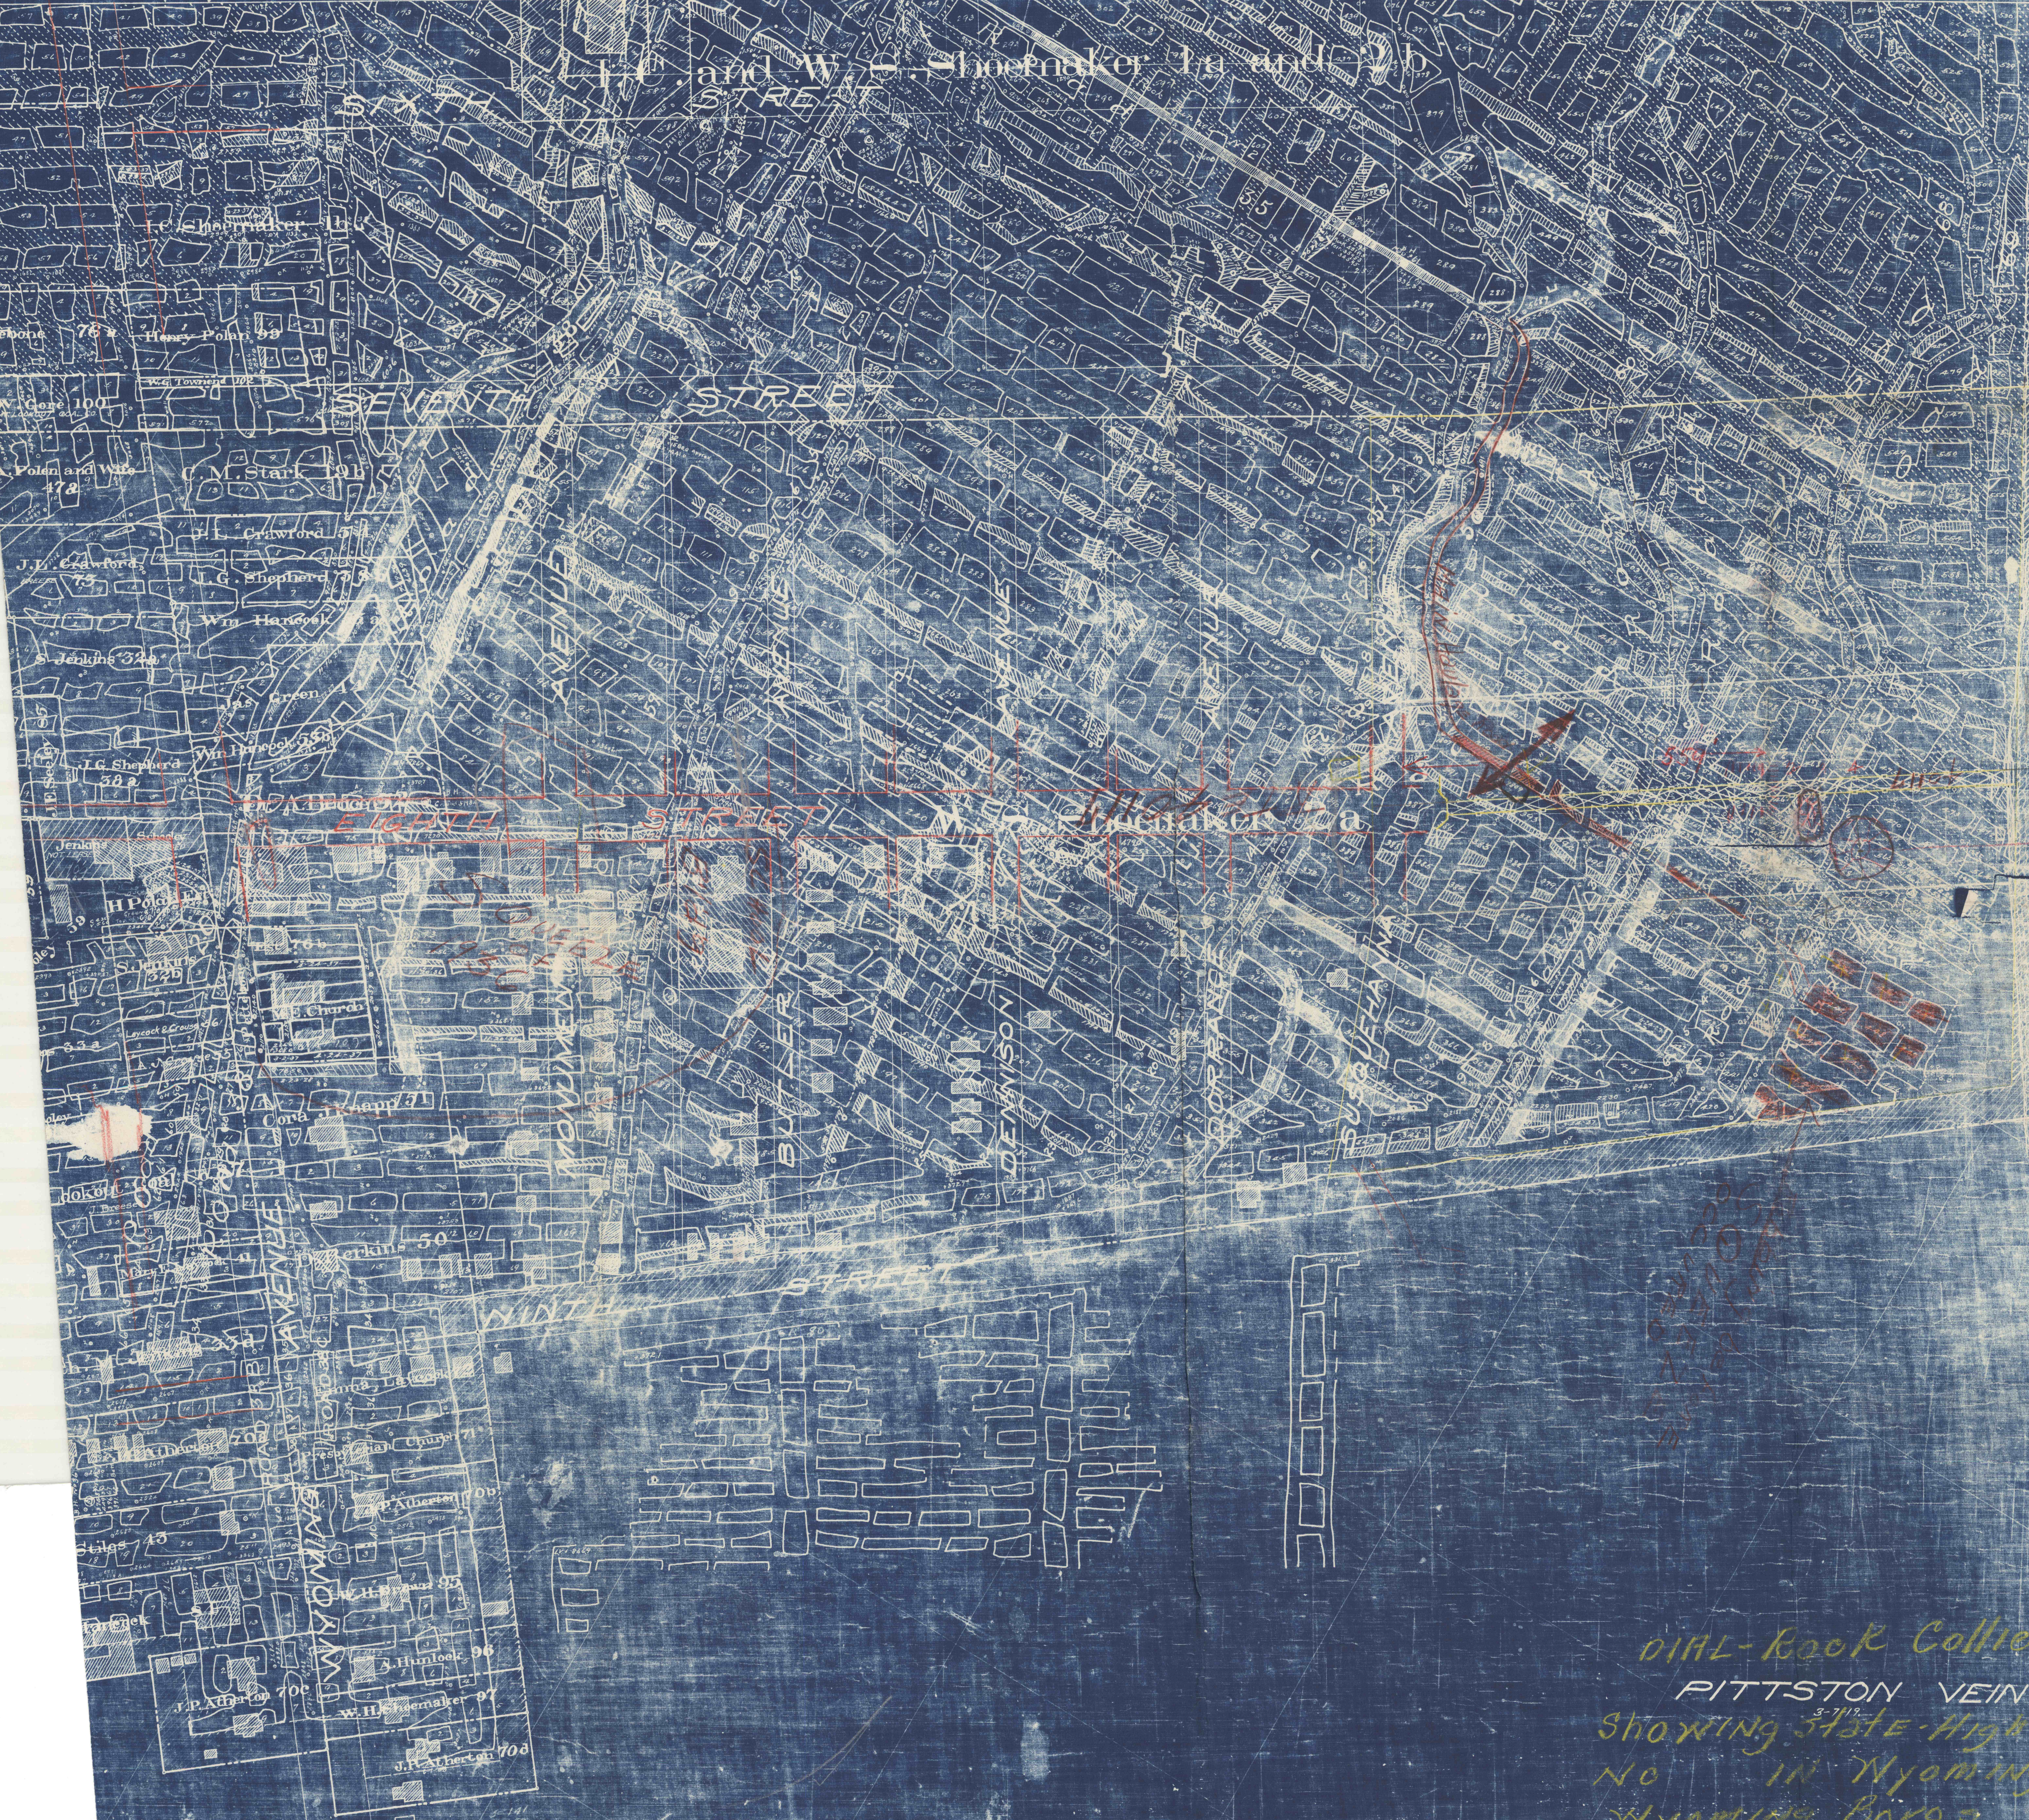

✓✓ from 44th St. Suss. Ave.  
to 1st pier (10) ?  
Flood map 30x44L  
2 pot holes 12' deep - Holding  
Water - 7/15/46  
Flood map 30x44L  
① 33'x75'x120  
② - 98' diam - 12' D

DIAL-ROCK Colliery  
PITTSTON VEIN  
Showing State-Highway Routes  
No 1 in Wyoming West  
Wyoming Boro  
L. Co. R.