

B.H. 3379  
SURFACE TO  
TOP ROCK

SECTION B-12-22 SECTION LINE  
E-12-22  
WILKES DAM

435

B-12-36

B-12-36

N.P. 4370

Stripping Operation # T55  
Permit 30-52

This Area Will not be Stripped

Proposed Stripping Area  
Revised  
7.30 Acres

No 8 Vein

U.S. COAL CO.  
D.L. & W.R. CO. FILE NO. 2118



D.L. & W.R. CO. FILE NO. 2118

Middle Road

Blue Coal Corporation  
Truesdale Colliery  
Dist. #1

Scale 1" = 100'

Apr 7 1968

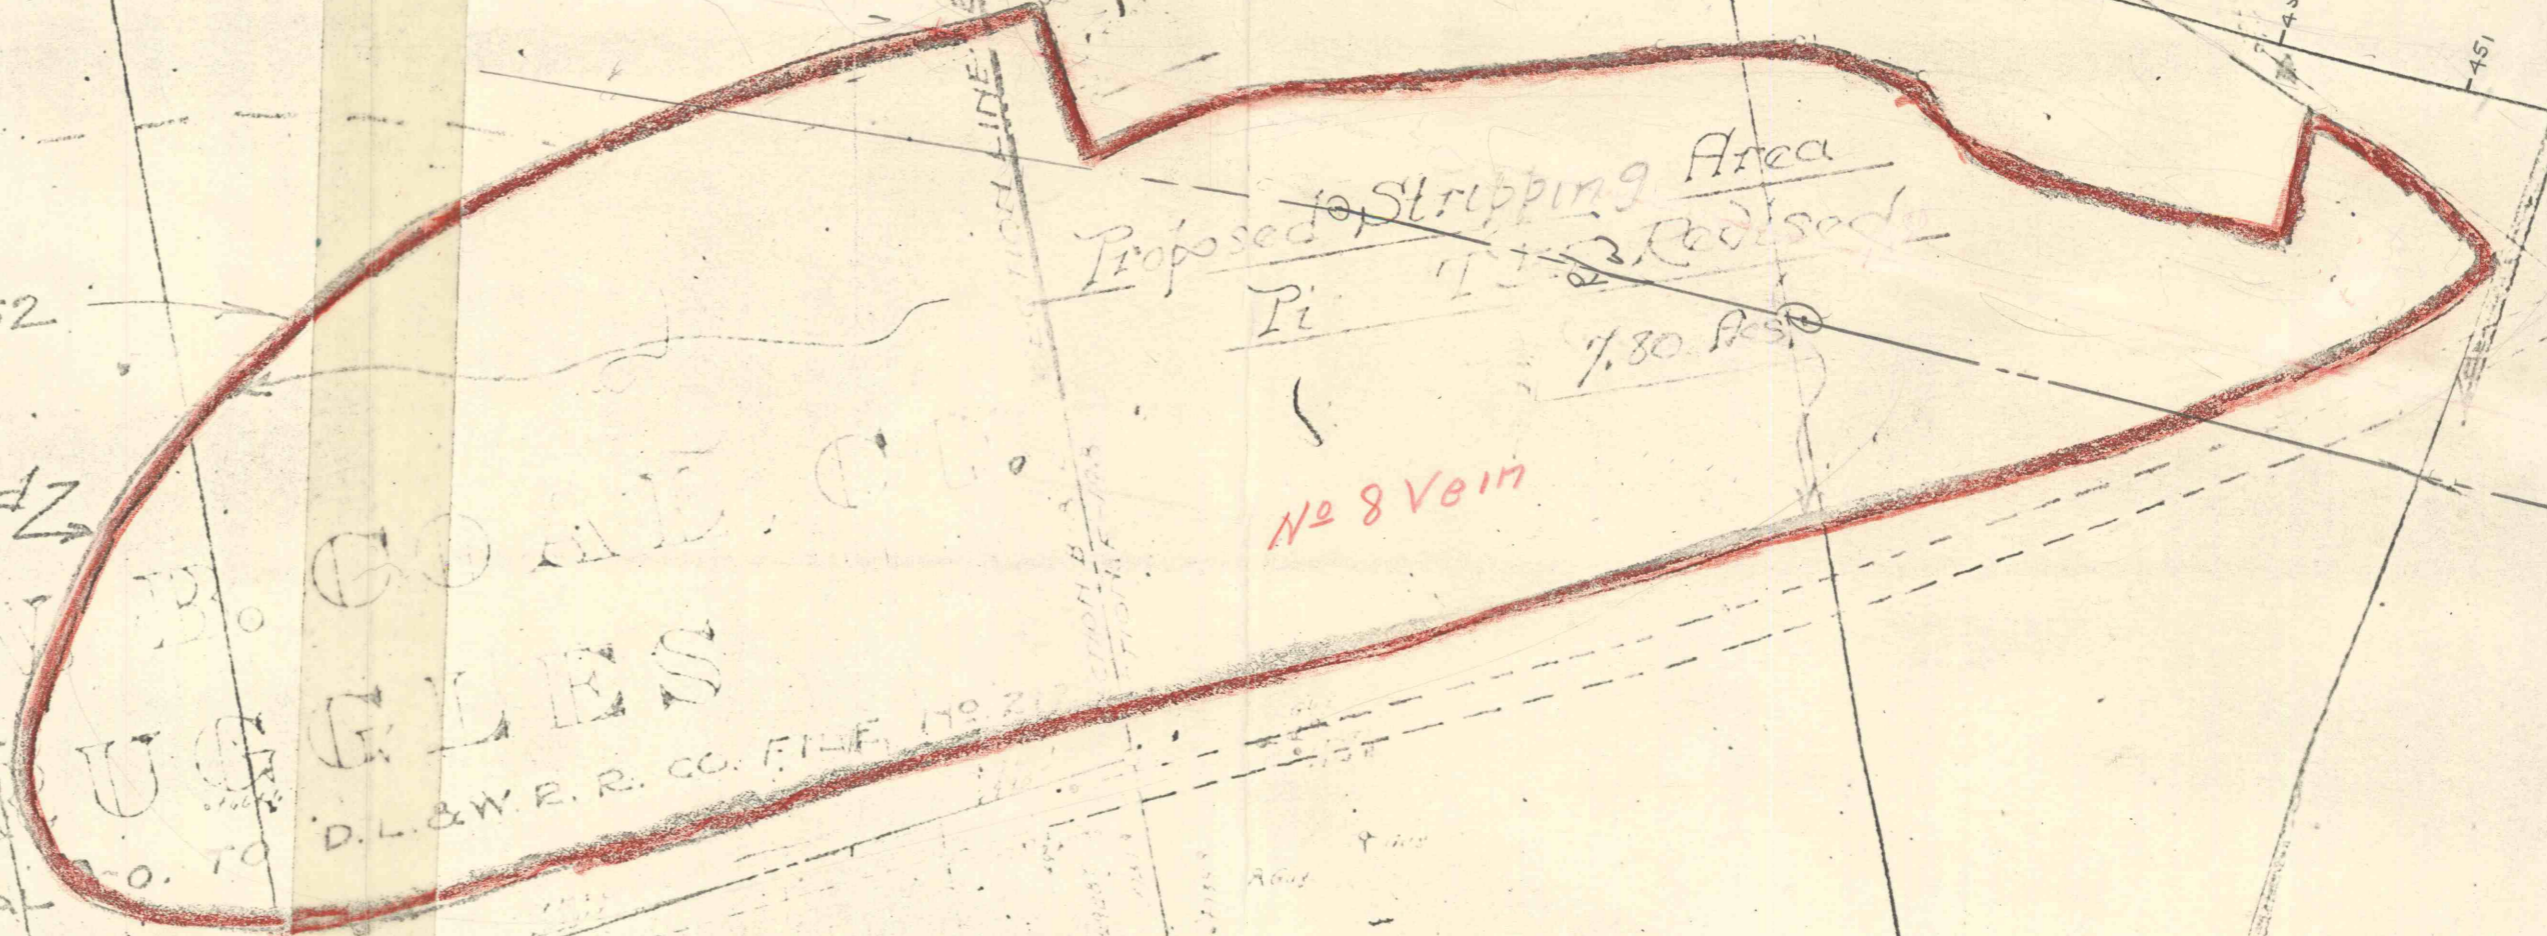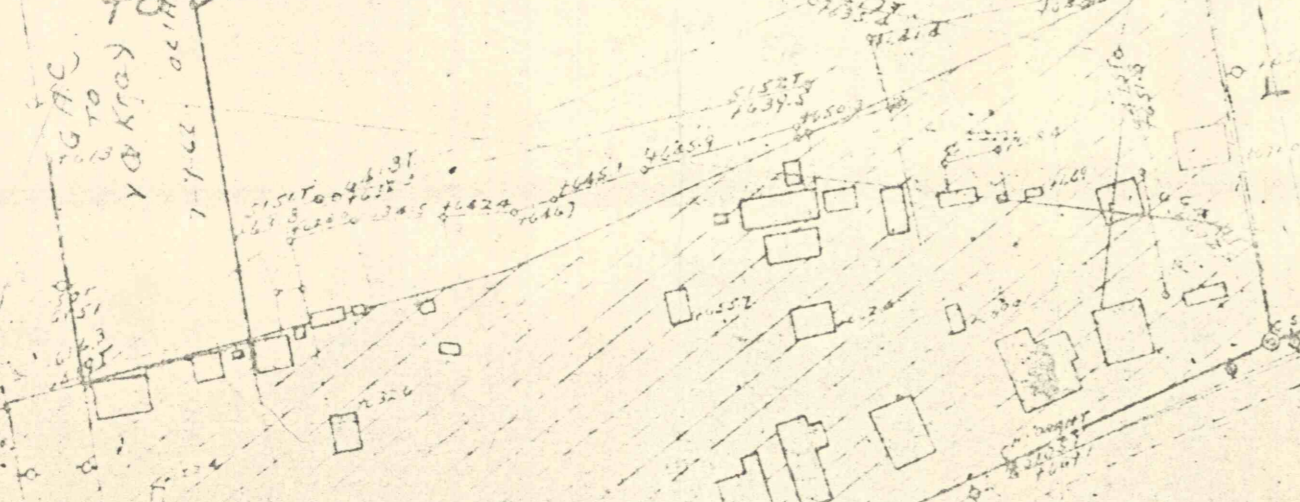

452787