

LOCATION PLAN  
1"=2000'



**GENERAL NOTES:**

- EXISTING & ADJACENT PROPERTIES NORTH, EAST, & WEST OF CONAHAN TRACT ARE PRESENTLY UNSUITABLE FOR DEVELOPMENT DUE TO PAST STRIPPING AND AREA HAS NOT BEEN RESTORED. AREA SOUTH OF CONAHAN TRACT IS PRESENTLY OWNED & OPERATED BY HAZLETON AIRPORT AUTHORITY.
- HIGHEST ESTIMATED FUTURE LAND USE OF AREA: COMMERCIAL AND INDUSTRIAL DEVELOPMENT.
- NO RESIDENTIAL HOMES ARE LOCATED WITHIN 1000' OF AREA TO BE STRIP MINED.
- TOTAL MINE DRAINAGE AREA - ALL OF CONAHAN TRACT 7.57 ACRES.
- TOTAL MINE PERMIT AREA - PORTION OF CONAHAN TRACT 4.80 ACRES.
- ESTIMATED AMOUNT OF EXCESS AND UNSUITABLE MAT'L - NONE - ALL MATERIALS WILL BE USED AND NEEDED TO BACKFILL EXISTING HOLES ON SITE.

**PLAN REVISIONS 6-11-80**

- 100' ROAD BARRIERS ADDED ON PLANS (SHEETS 1 & 2.)
- VARIANCE TO CONSTRUCT TEMP SETTling BASIN IN 100' ROAD BARRIER AREA APPLIED FOR ON 6-11-80 TO PENN DOT MINING ENGR, P.O. BOX III, SCRANTON, PA. PLANS SUBMITTED SHOW 3 X-SECTIONS OF EXISTING & PROPOSED ELEVATIONS.
- NO EXCESS AND UNSUITABLE MATERIALS WILL BE REMOVED FROM PROJECT SITE. SEE GENERAL NOTE 6 THIS SHEET.
- ADJACENT PROPERTY OWNER PREVIOUSLY LISTED AS "PA. DEPT OF FORRESTS & WATERS" REV. AS LANDS OF COMMONWEALTH OF PENNA., DEPT. OF ENVIRONMENTAL RESOURCES.
- PLANTING PROPOSAL COMPLETED AND ATTACHED TO REV. PLAN SHEETS.

**PROPOSED SITE PLAN**  
SCALE 1"=200'

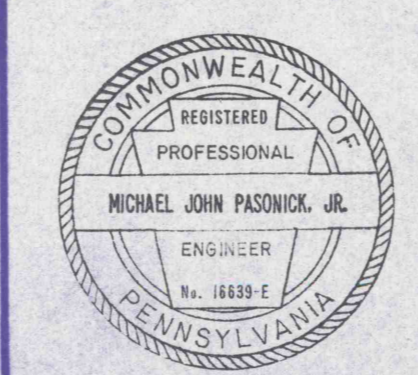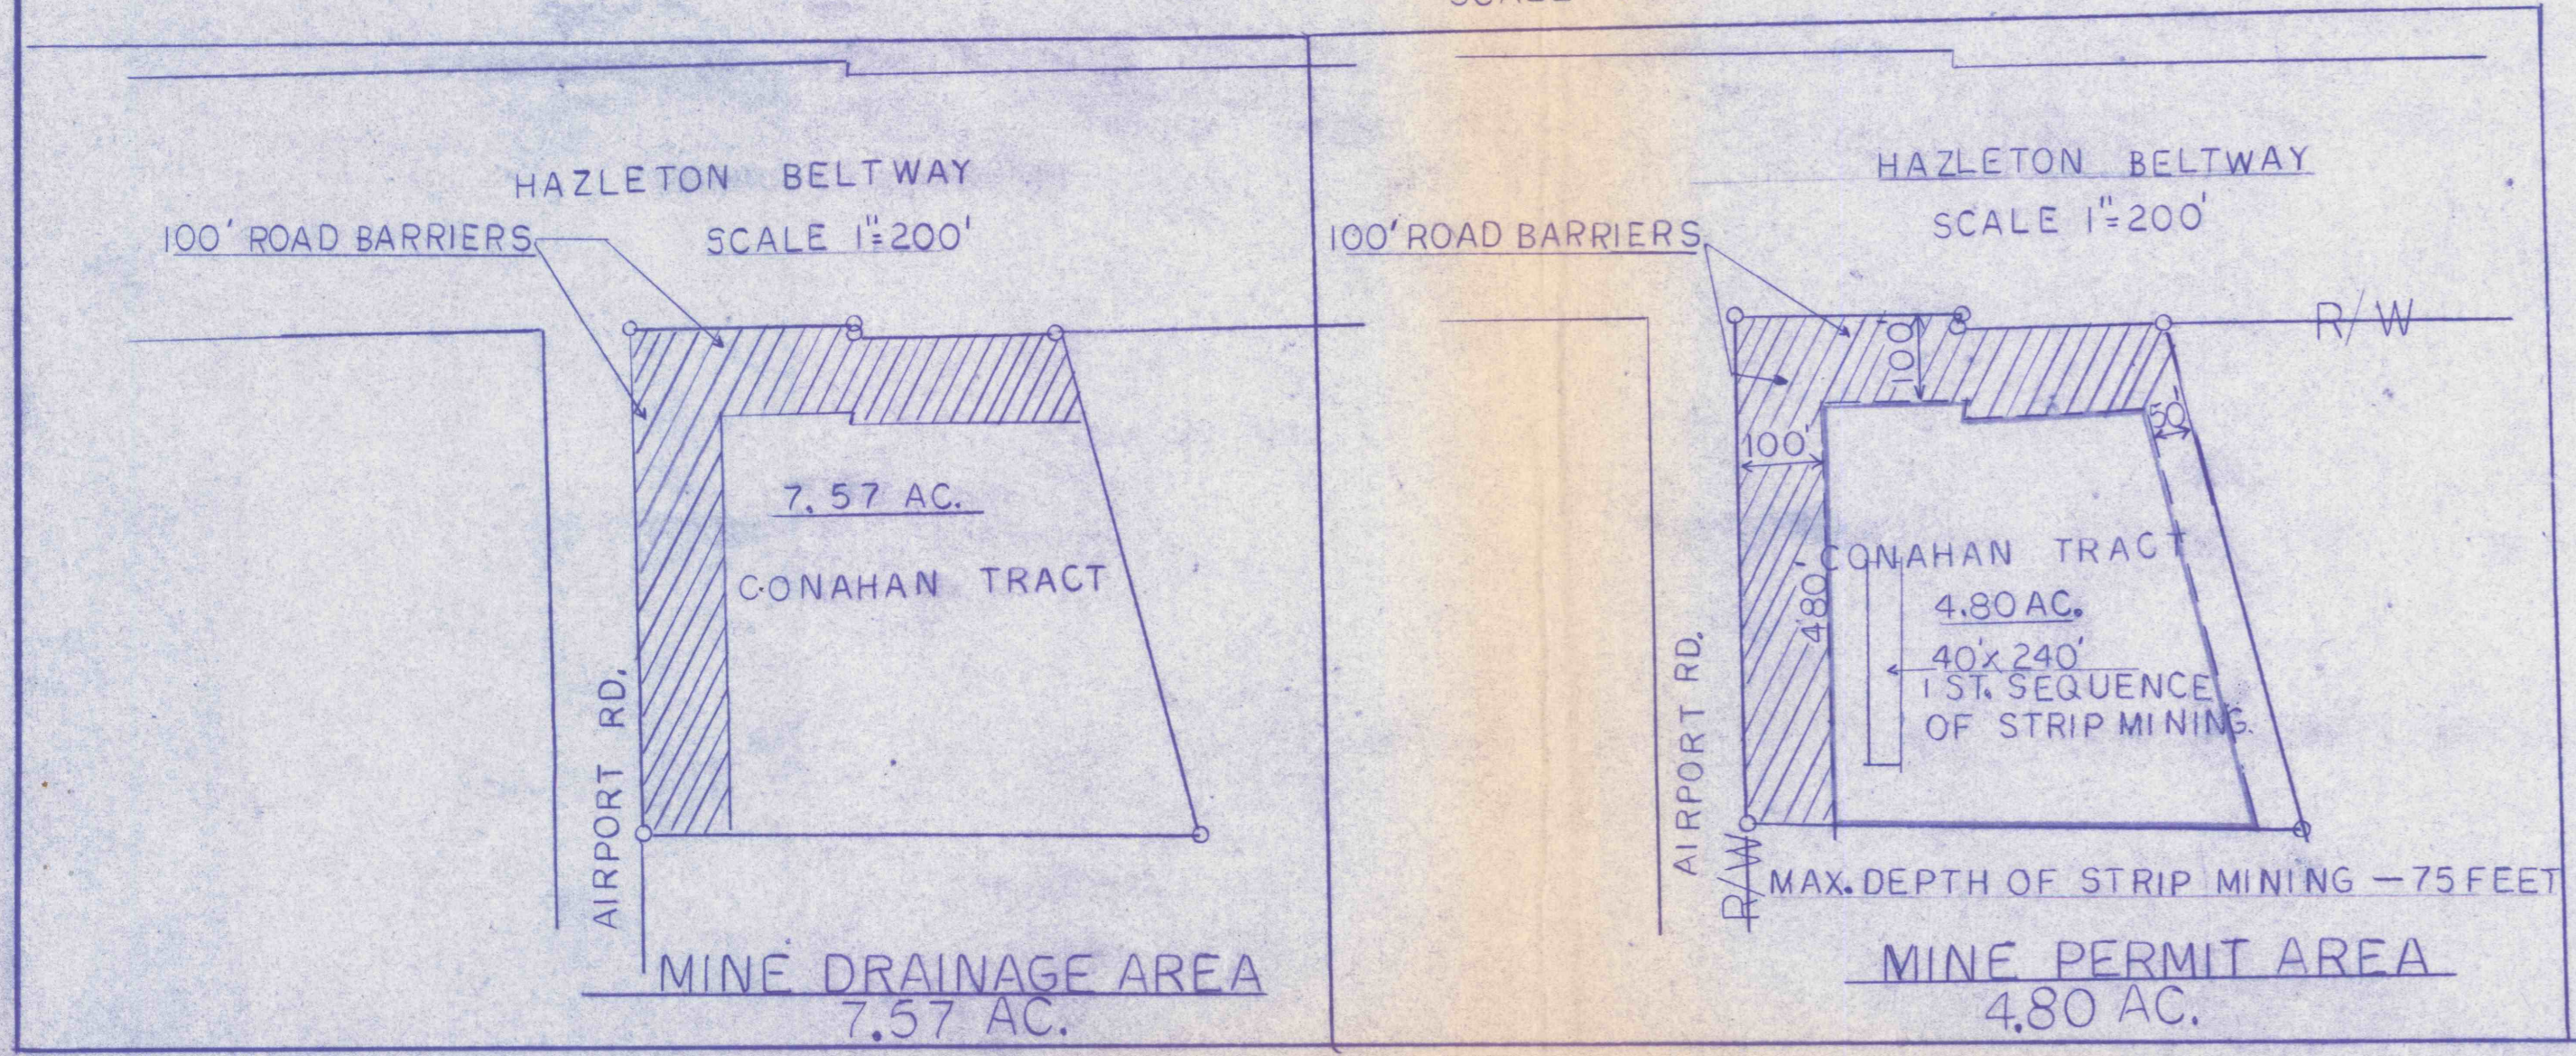

"BYPASS REFUSE PROJECT"  
PROPOSED STRIP MINE  
HAZLE TWP, LUZERNE COUNTY  
PENNSYLVANIA

MICHAEL J. PASONICK JR., INC.  
Civil Engineers & Surveyors  
194 East Main Street  
Wilkes-Barre, Pennsylvania 18705

FOR:  
PENNA. PEAT MOSS INC.  
21<sup>ST</sup> & LAUREL STS.  
HAZLETON, PENNA.

Date	4-02-80	Job No.	
Drawn by	RT	Scale	AS SHOWN
Checked	JD	Sheet No.	
Survey Book	144		1 of 2

RECEIVED  
DEPARTMENT OF  
TRANSPORTATION  
DIVISION OF  
HIGHWAYS  
JUN 19 9 38 AM '80  
PENN. DOT  
SCRANTON, PA.

PLAN REV. 6-11-80