


100 200 300 400 500 600

L.R. 10176

10' TO E

100'

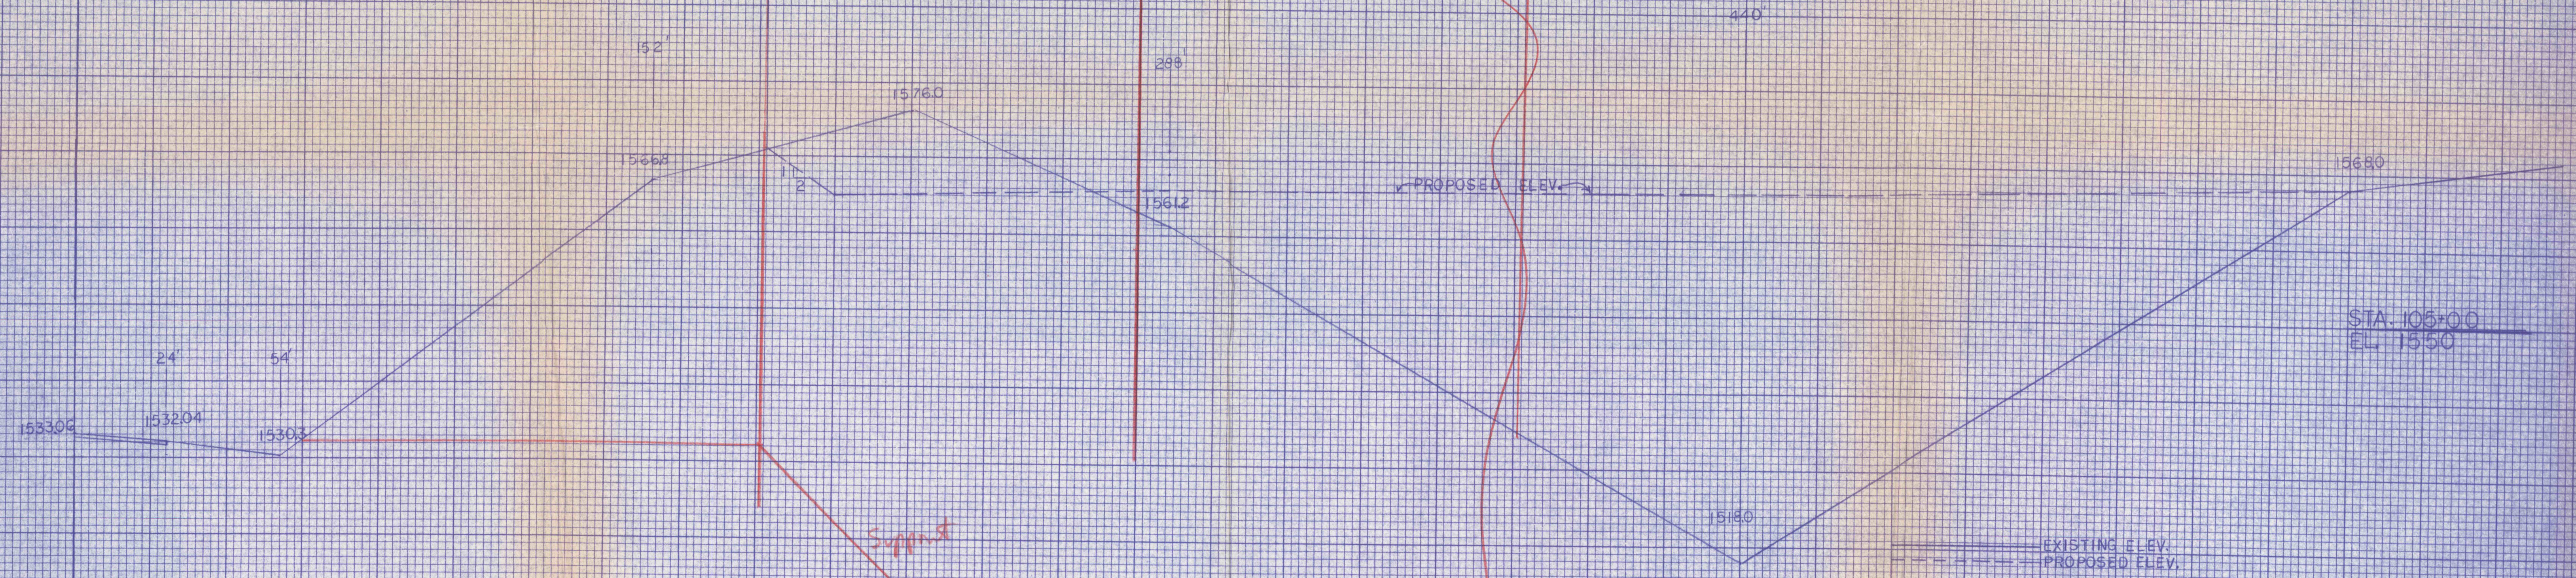

NOTE:  
ALL DISTURBED AREAS SHALL BE TOPSOILED AND SEEDED



CROSS SECTIONS OF PROPOSED AND EXISTING ELEVATIONS

MICHAEL J. PASONICK JR., INC.  
Civil Engineers & Surveyors  
194 East Main Street  
Wilkes-Barre, Pennsylvania 18705

BYPASS REFUSE PROJECT  
HAZLE TWP. LUZERNE CTY. PA.  
FOR  
PENNA. PEAT MOSS CO.  
21<sup>ST</sup> & LAUREL STREETS  
HAZLETON, PENNA.

Date 6-09-80	Job No.
Drawn by J.D.	Scale AS SHOWN
Checked	Sheet No.
Survey Book 142	3 OF 3

SCALES: HORIZ: 1"=20'  
VERT: 1"=10'