


10 11 12 



Nº 4 VEIN
EXTENDED 11-67

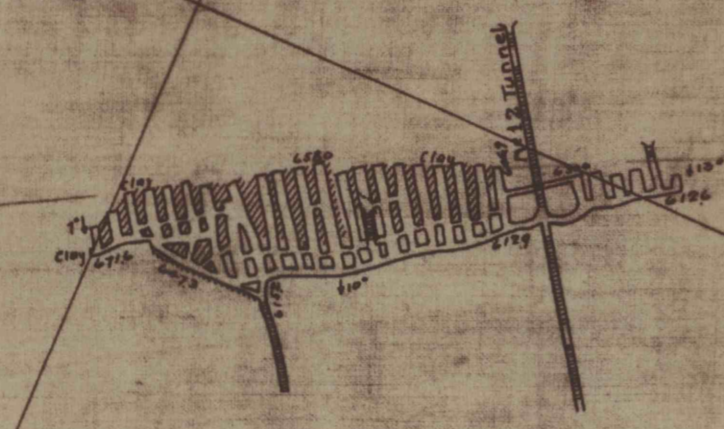




LOW
STEVENS

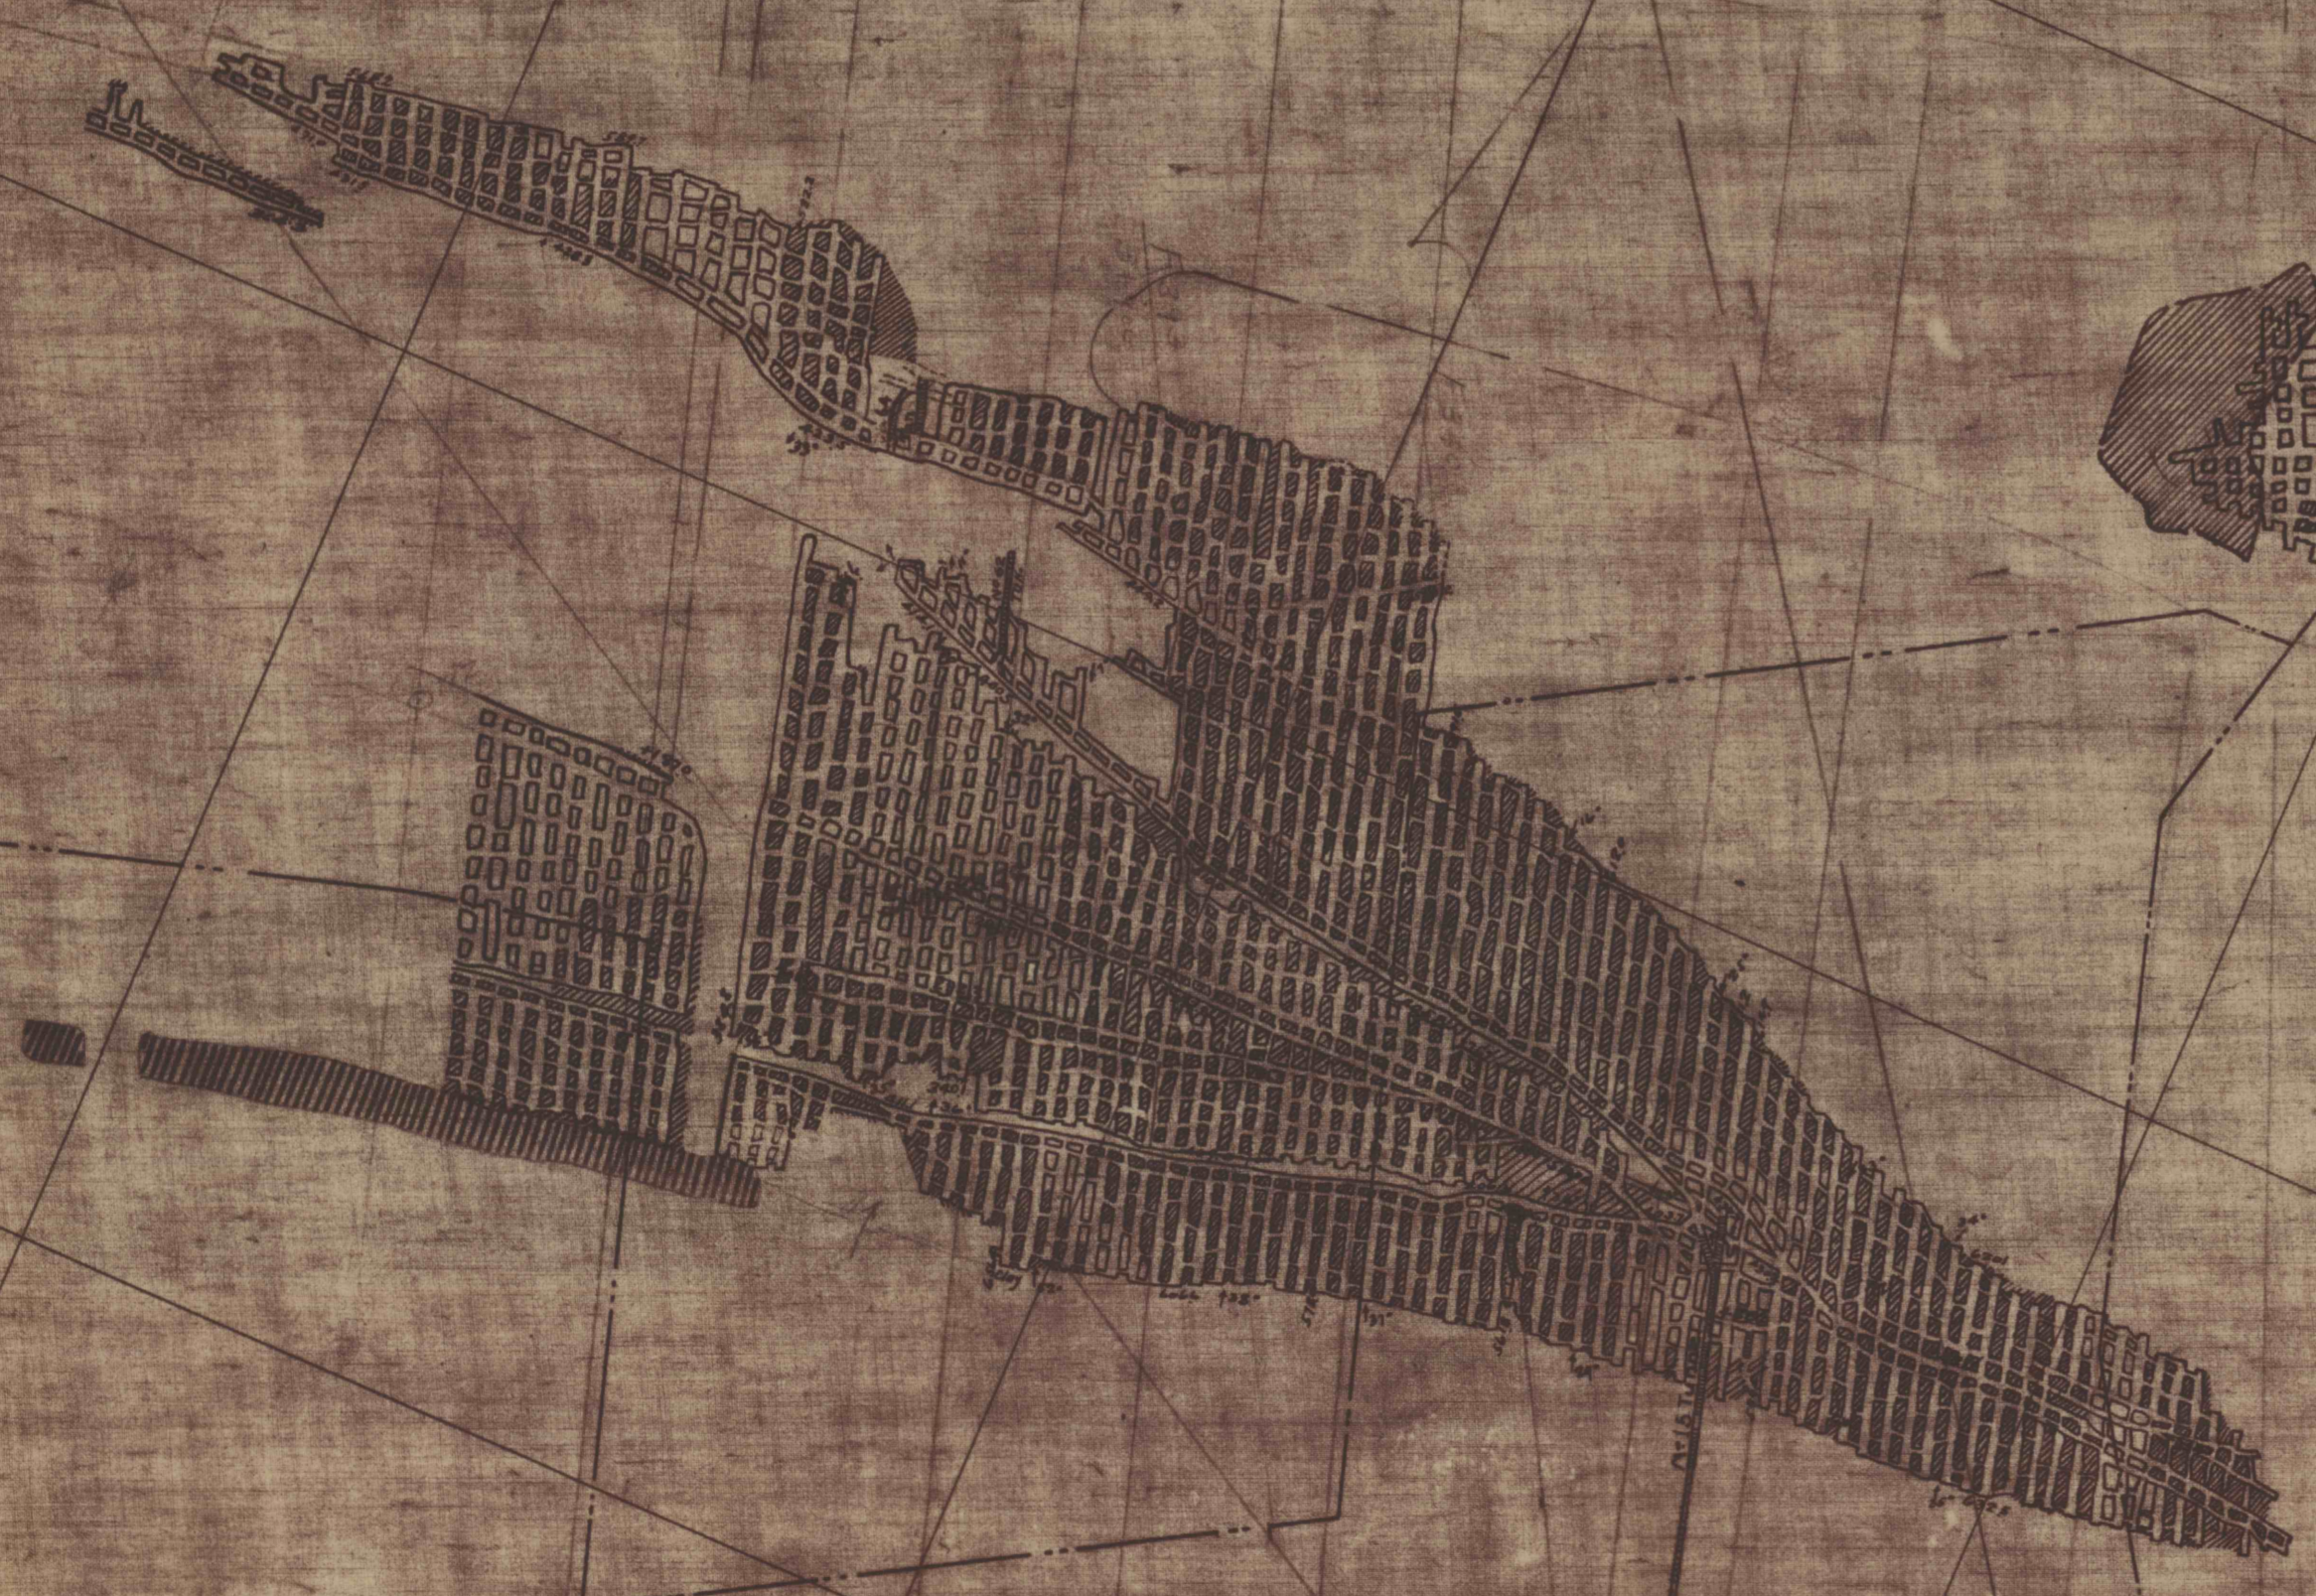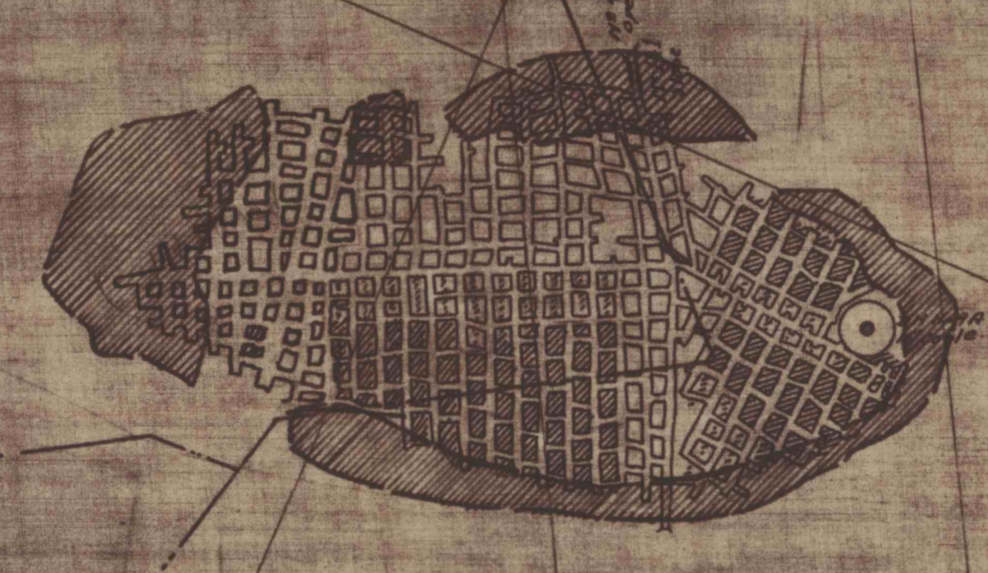

10 11 12 