
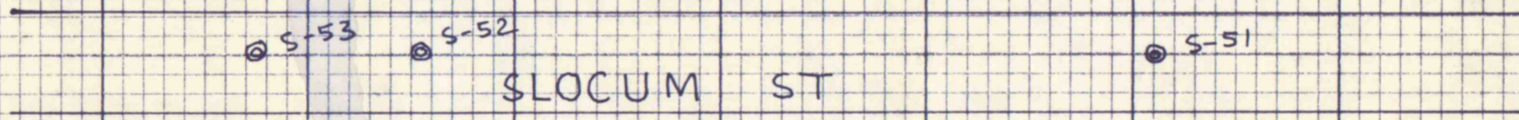
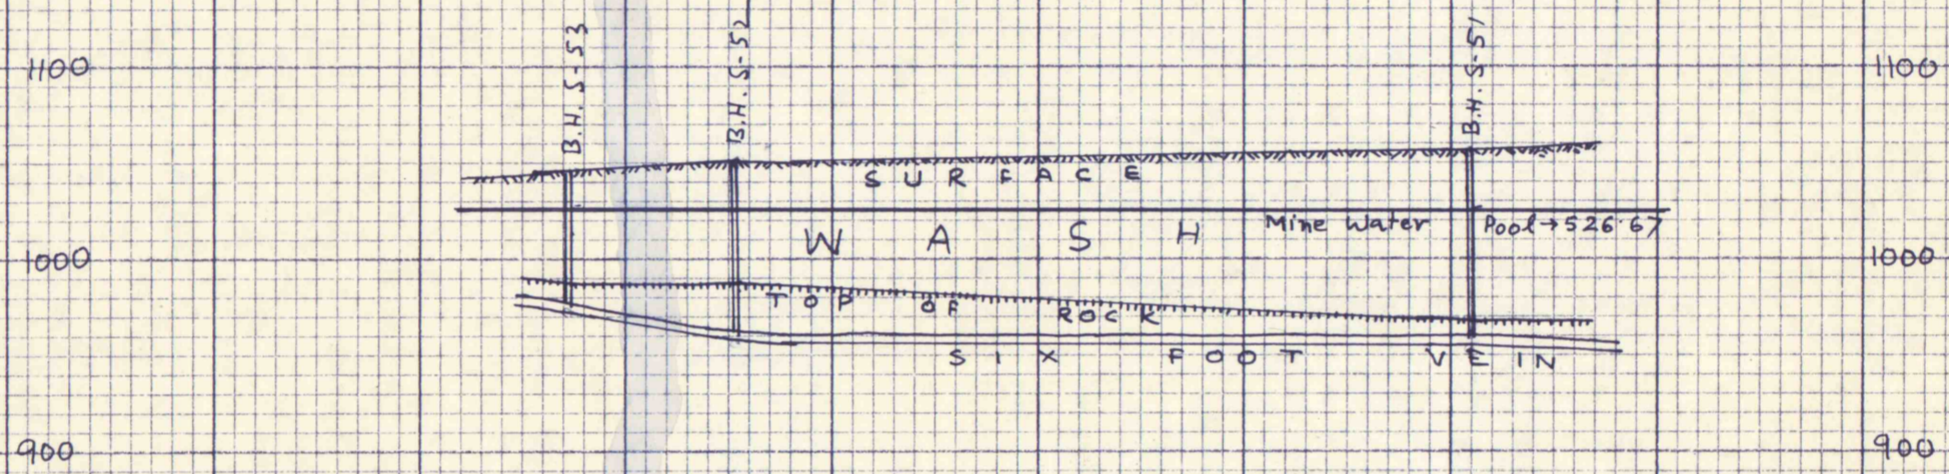
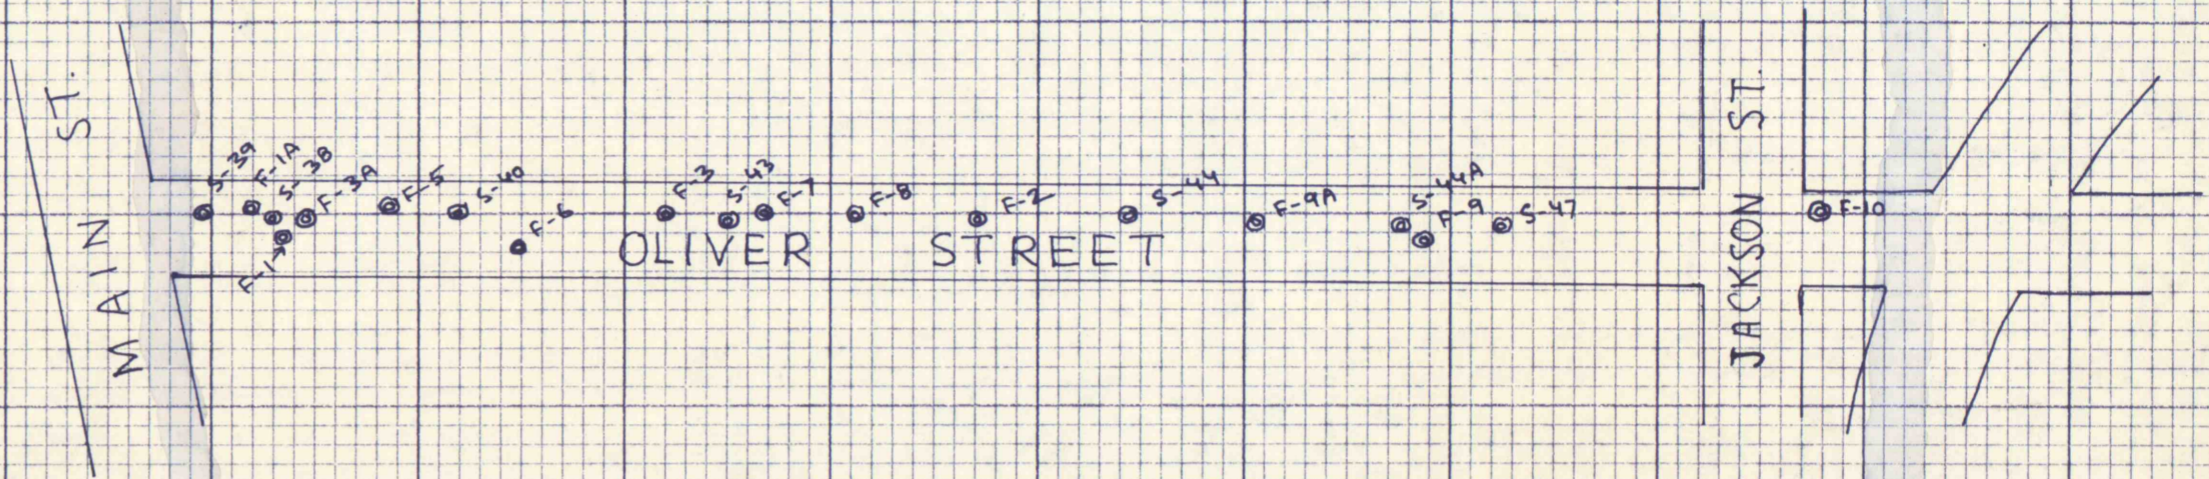


SWOYERSVILLE FLUSHING PROJECT ASP-15

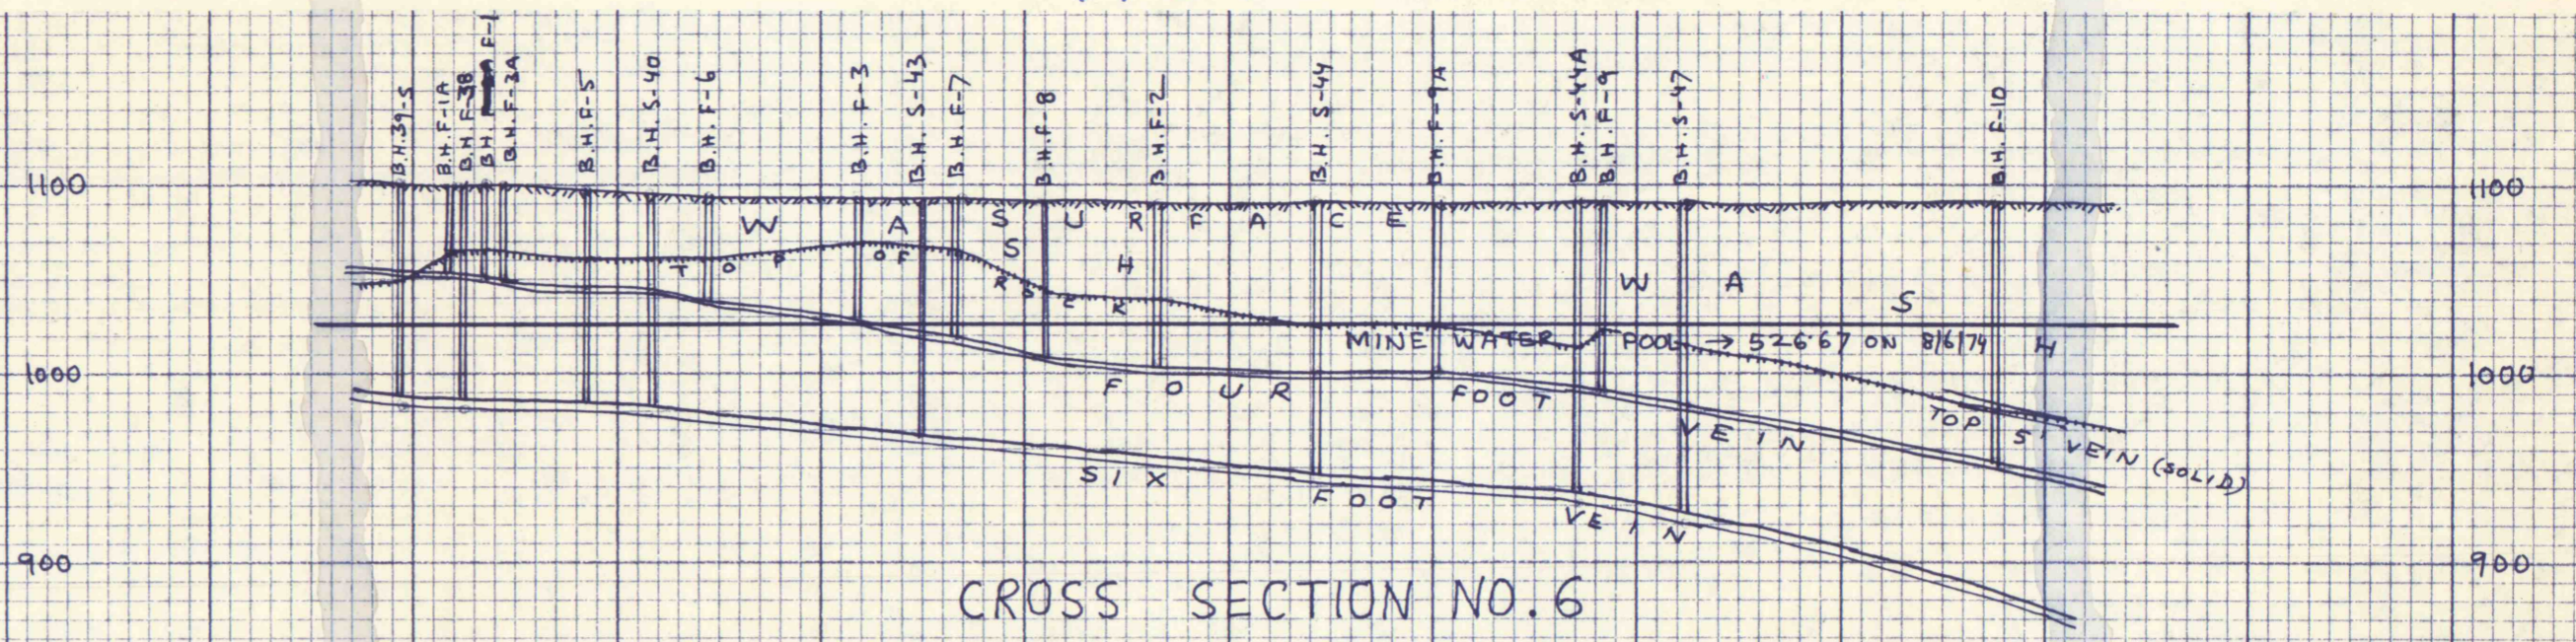

CROSS SECTION - 7