



SWOYERSVILLE PROJECT - A S P - 15 - CROSS SECTIONS

CHARLES BRUNING COMPANY
CROSS SECTION 10 X 10


CHARLES BRUNING COMPANY
CROSS SECTION 10 X 10

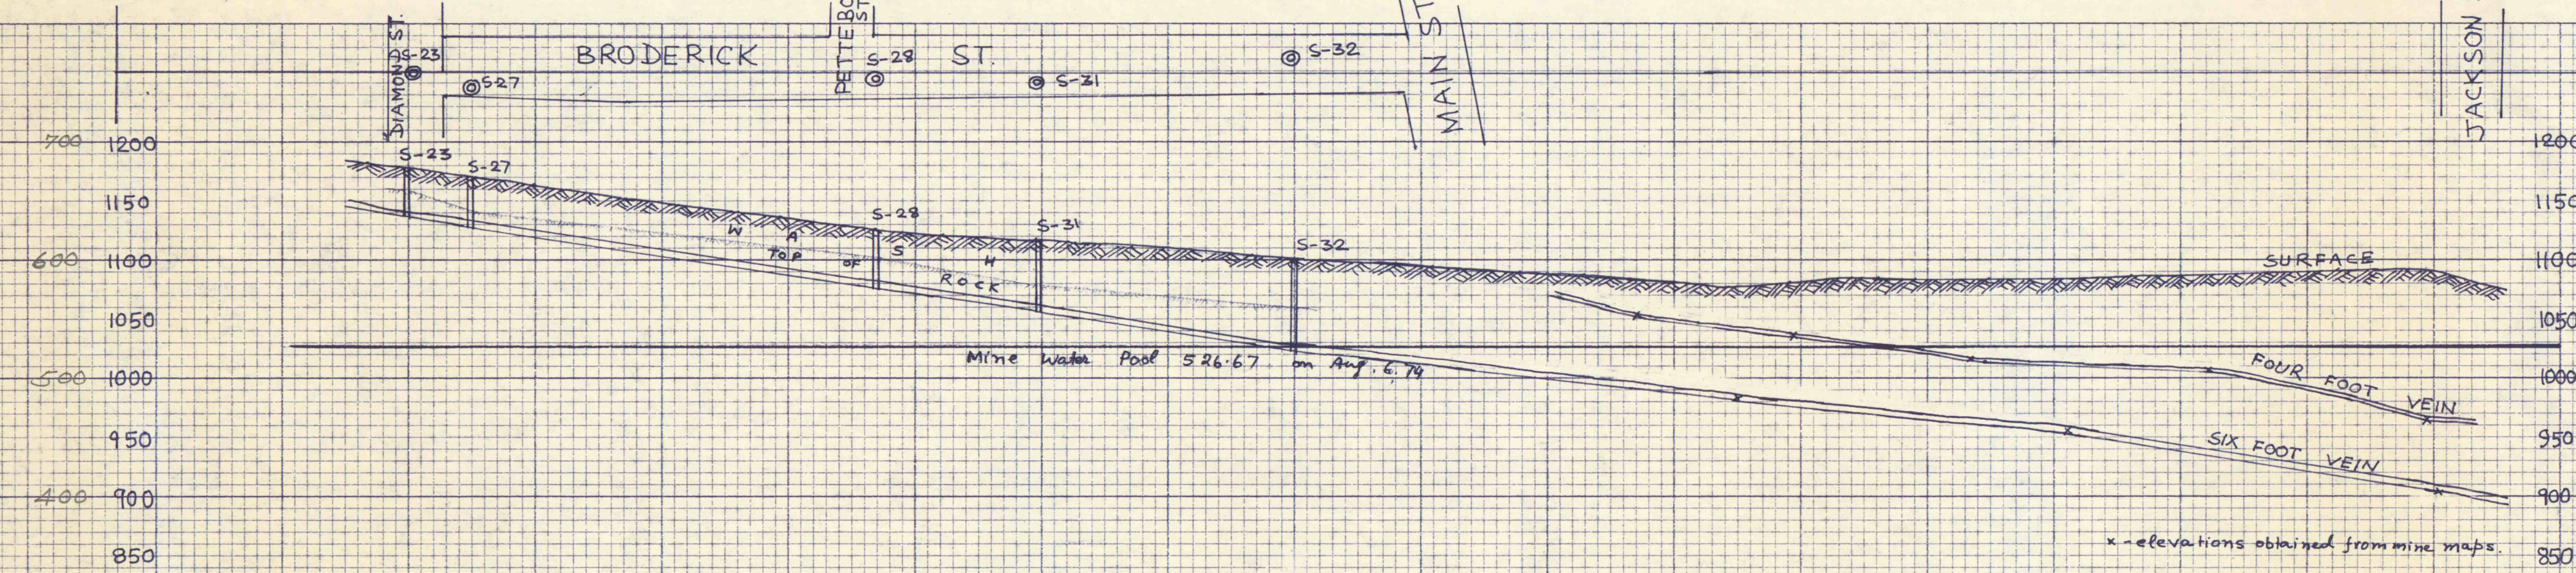


CROSS SECTION 1 SWOYERSVILLE FLUSHING PROJECT

 

SCALE -
HORIZONTAL - 1" = 100'
VERTICAL - 1" = 100'

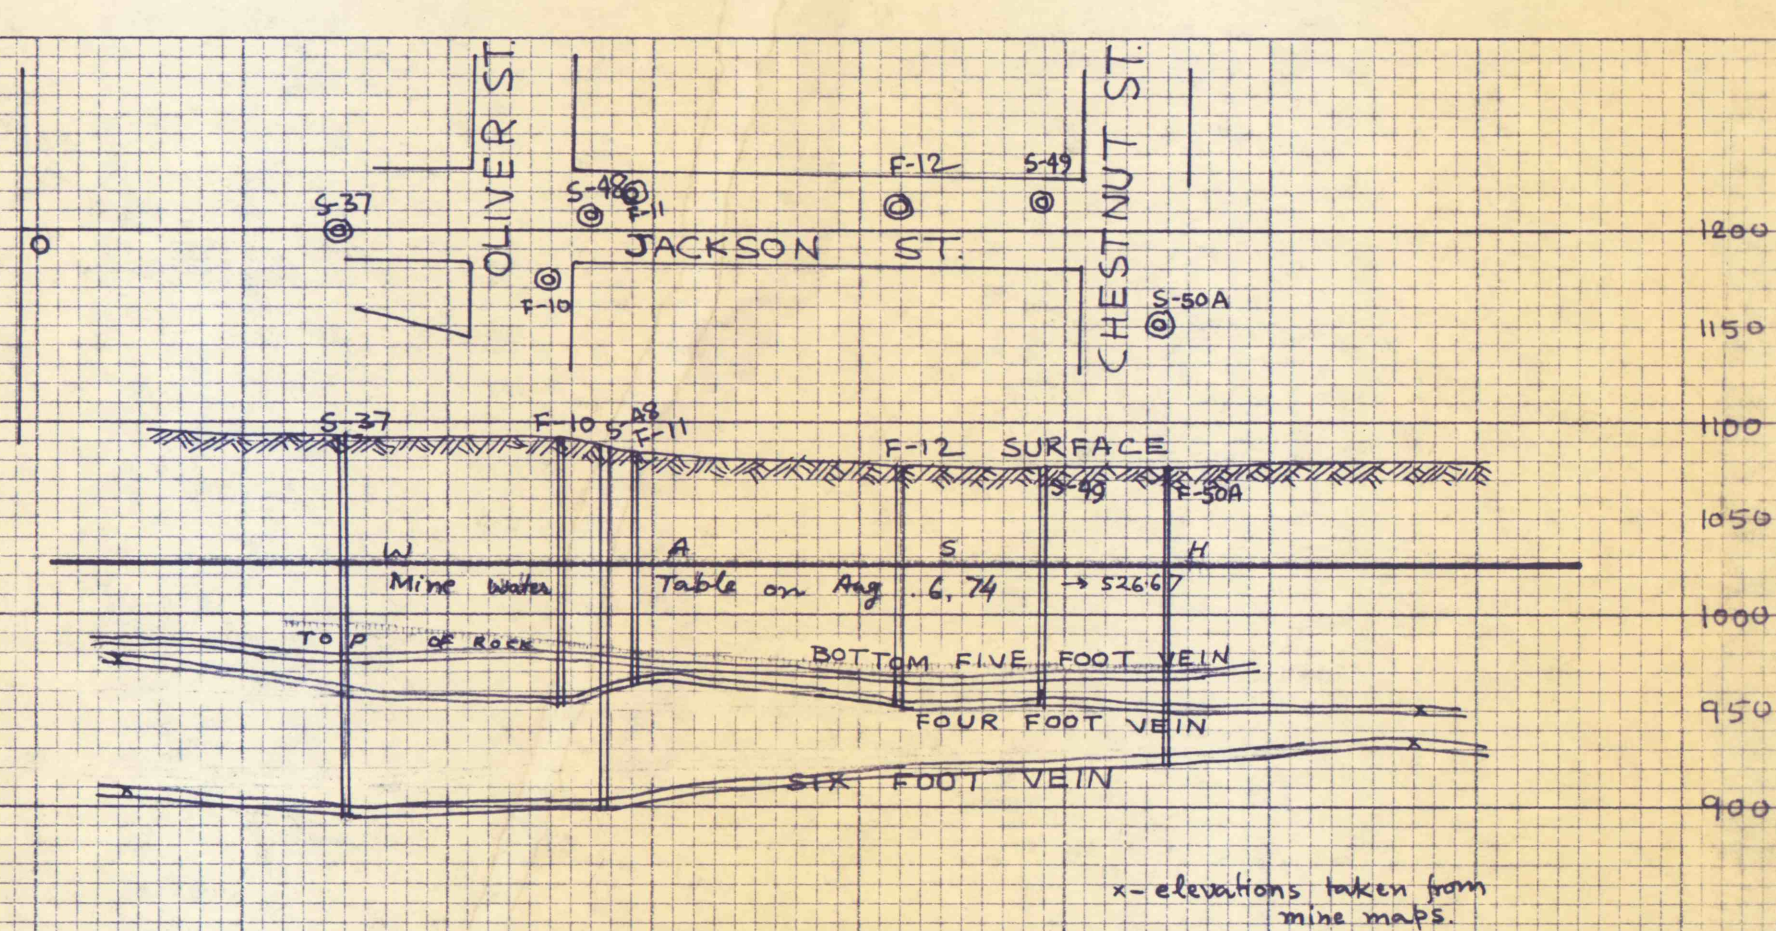


CROSS SECTION 2 SWOYERSVILLE FLUSHING PROJECT

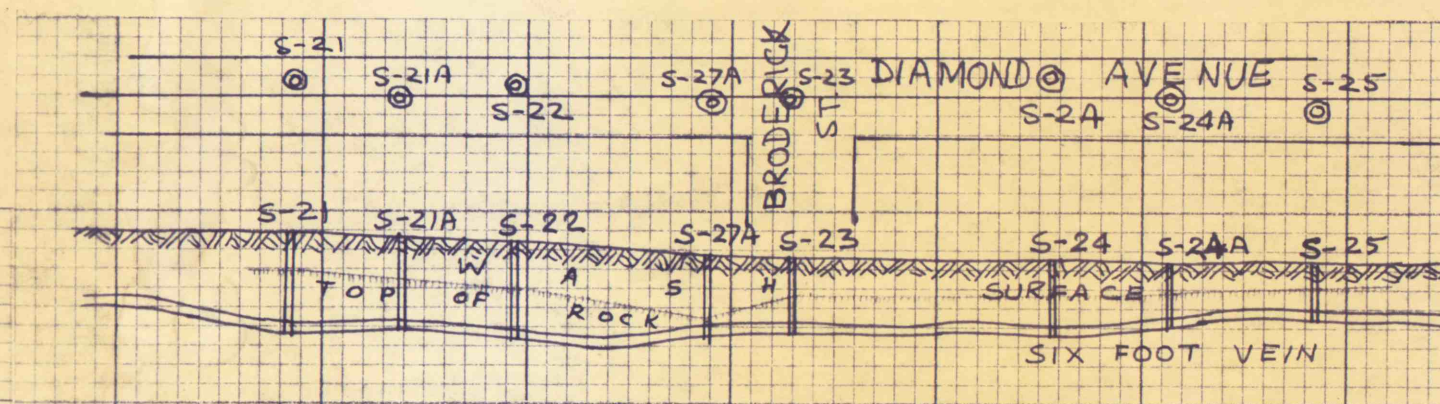


SECTION 4 SWOYERSVILLE FLUSHING PROJECT
Mine Water Pool 526.67 on 8/6/74
SCALE - Horiz: 1" = 100'
Vert: 1" = 100'

SWOYERSVILLE FLUSHING
A.S.P. - 15

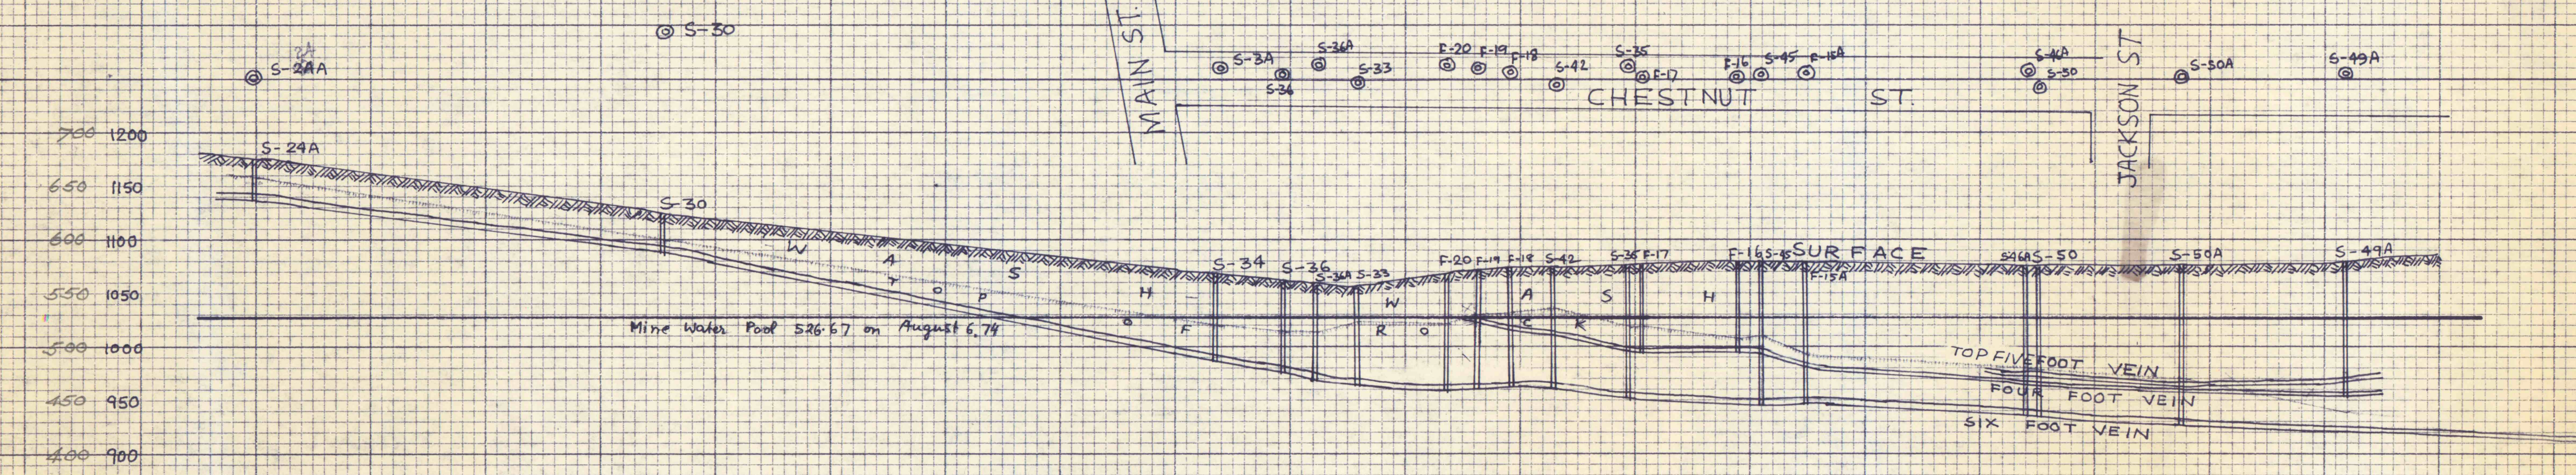

CROSS SECTION 5 SWOYERSVILLE FLUSHING PROJECT

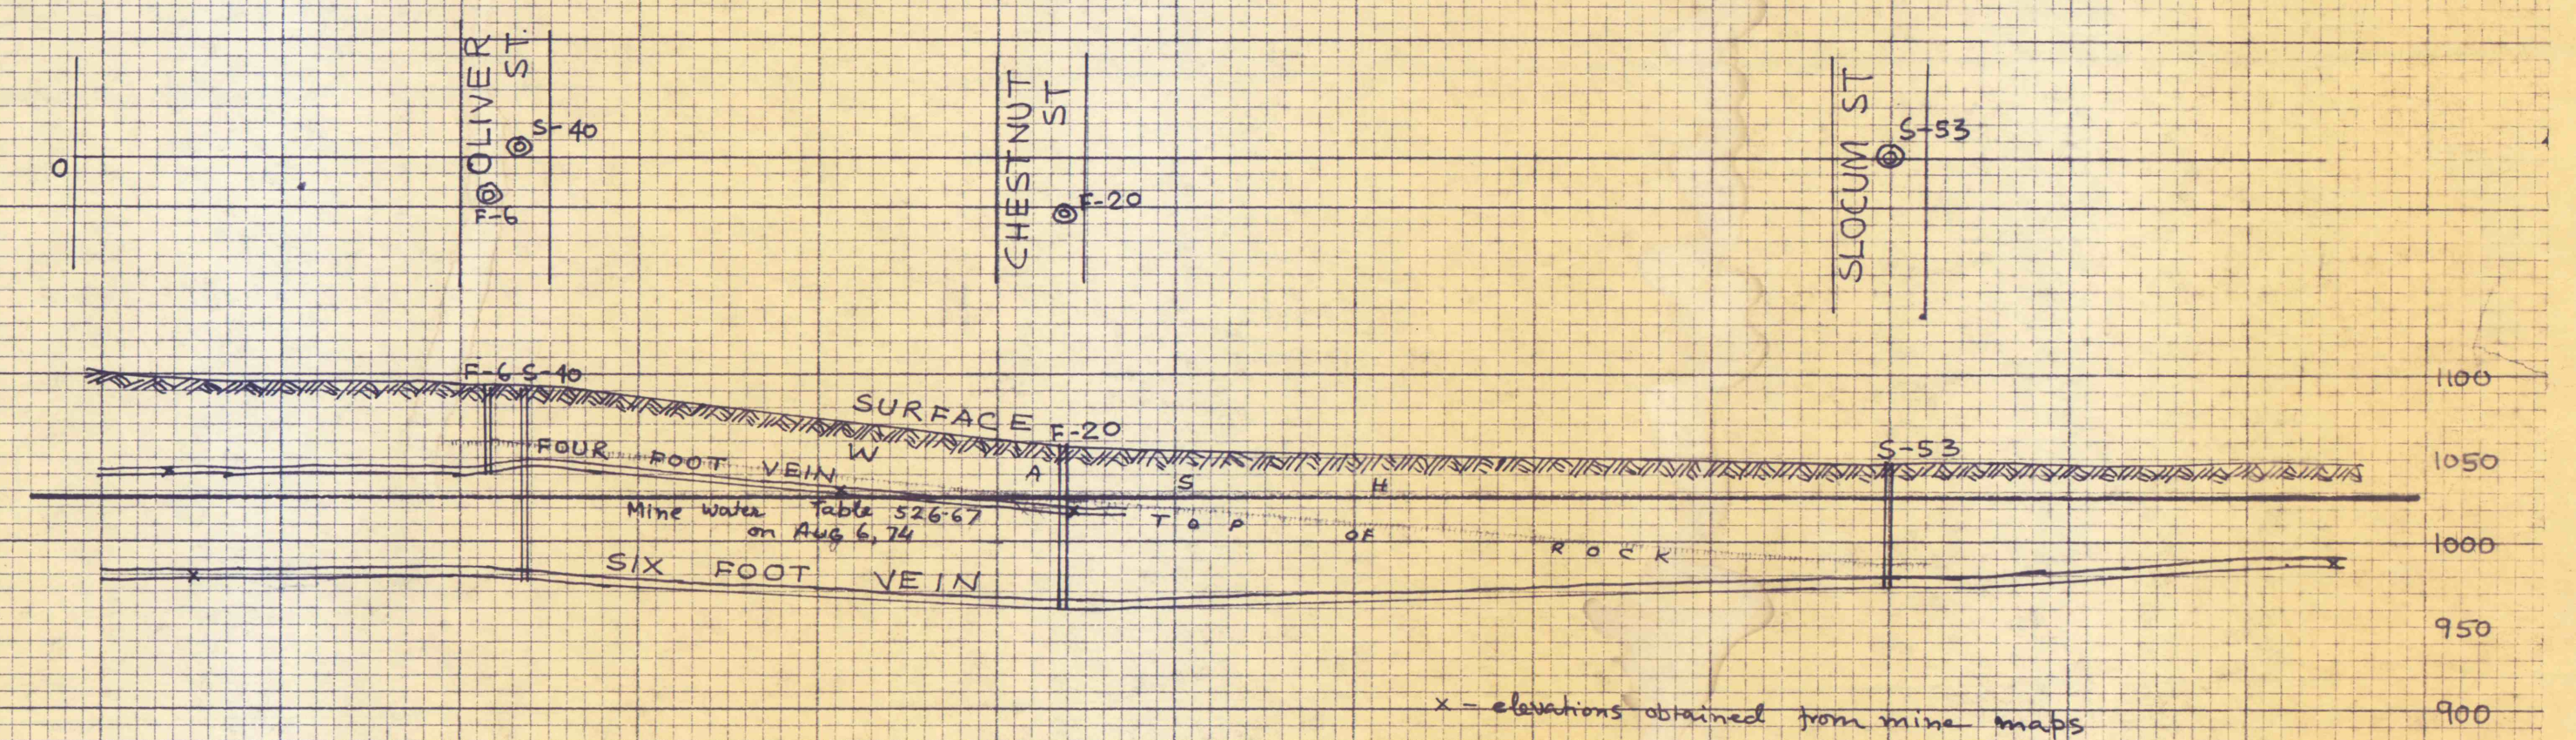

CROSS SECTION 3 SWOYERSVILLE FLUSHING PROJECT

x - elevations obtained from mine maps