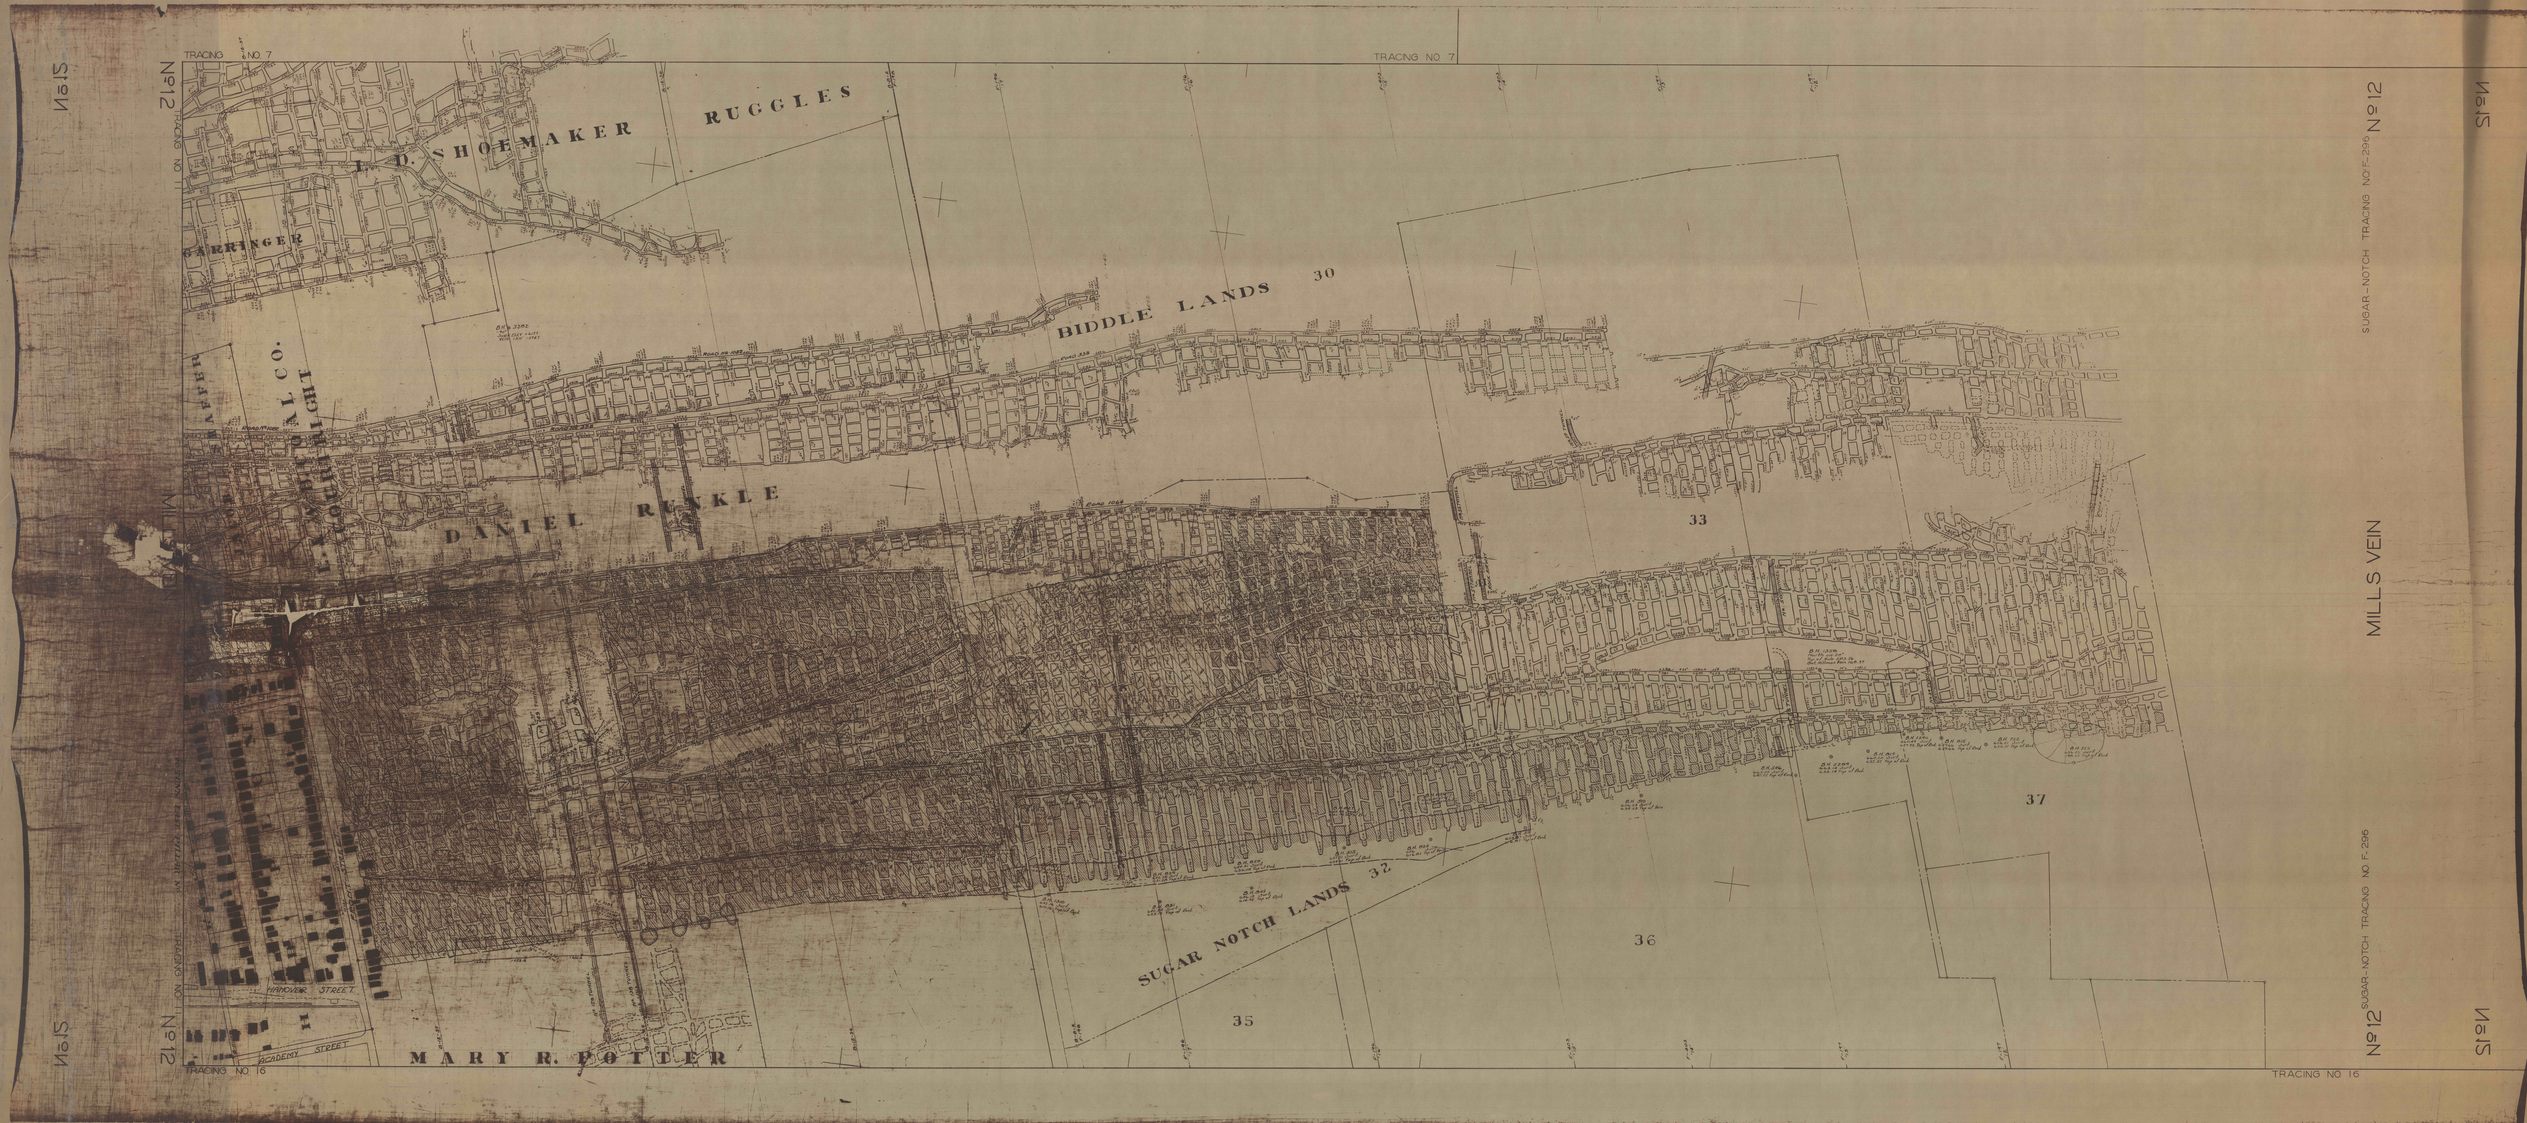
TRACING NO 7
TRACING NO 7
L. D. SHOEMAKER
RUGGLES
GARRINGER
BIDDLE LANDS
30
DANIEL RUNKLE
33
37
36
35
SUGAR NOTCH LANDS
32
MARY R. POTTER
HANOVER STREET
ACADEMY STREET
TRACING NO 16
TRACING NO 16
SUGAR-NOTCH TRACING NO F-296
MILLS VEIN
SUGAR-NOTCH TRACING NO F-296
No 12
No 12
No 12
No 12
No 12
No 12