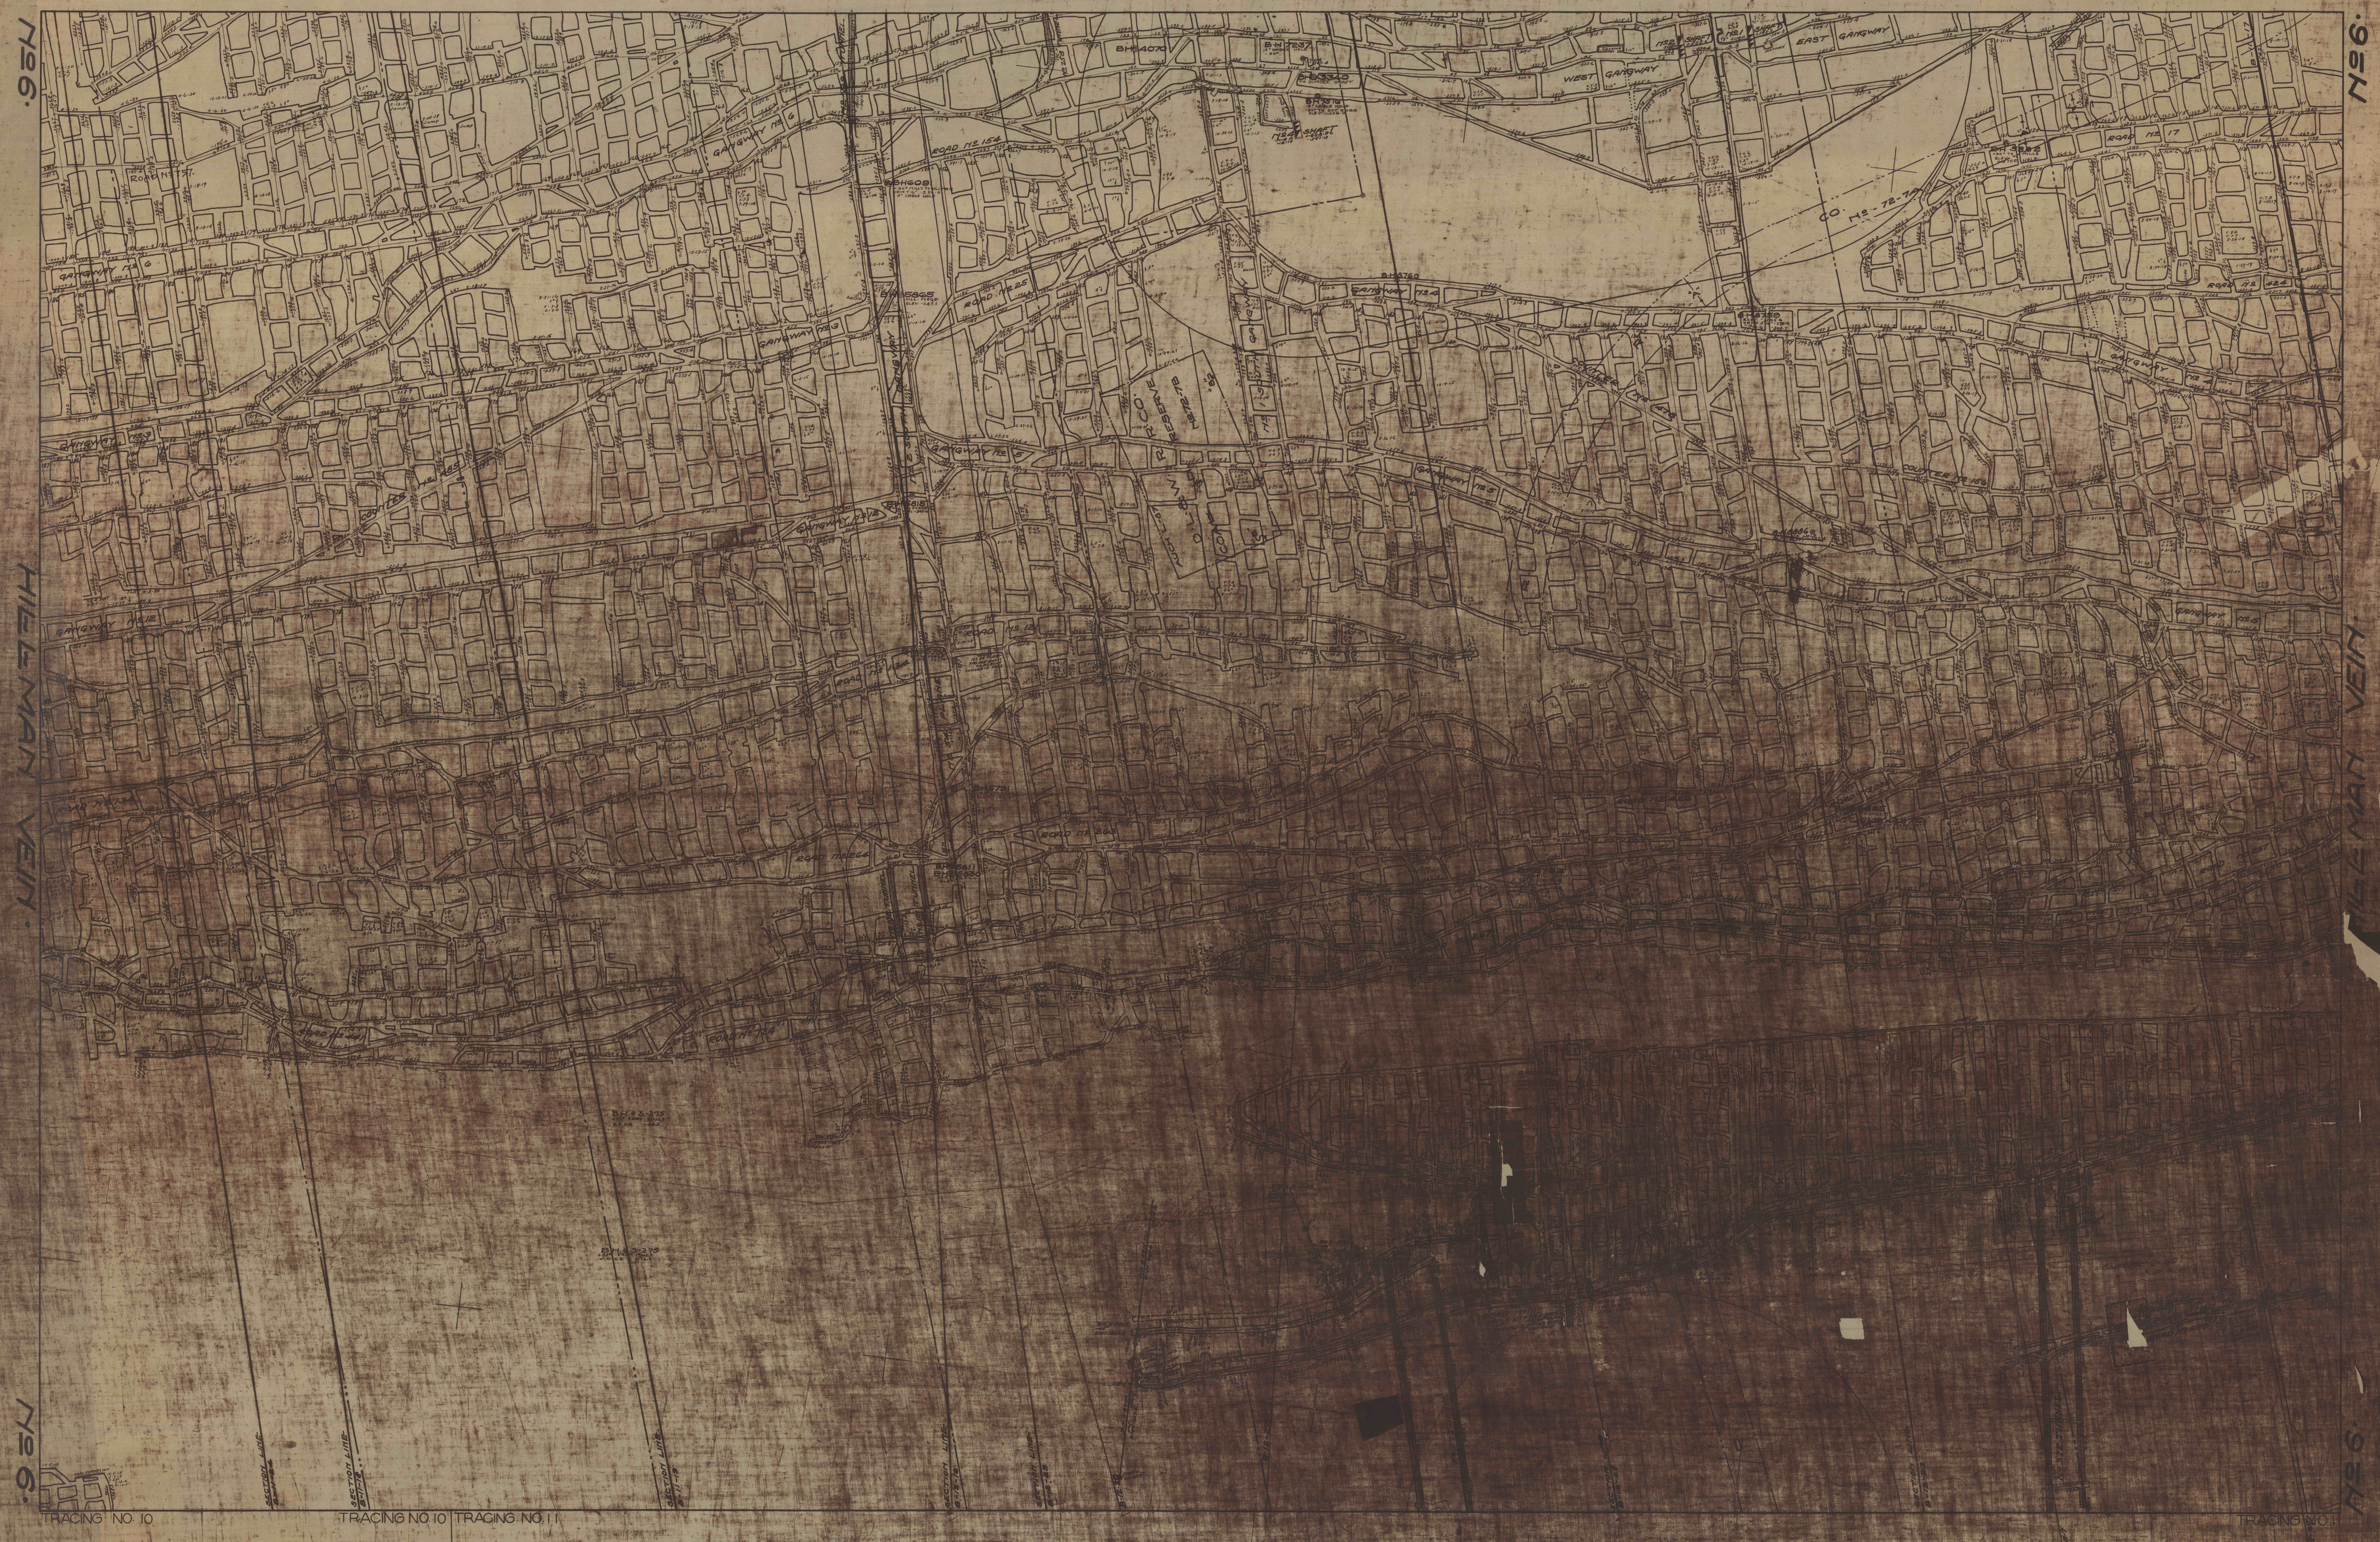No 6.
HILLMAN VEIN
No 6.
HILLMAN VEIN
No 6.
No 6.
No 6.
BH 4070
B.H. 7237
4" CABLE HOLE
B.H. 3340
TO DUNDEE SHAFT
B.H. 7516
4" CABLE HOLE
No 4 SHAFT
No 2 SHAFT
No 1 SHAFT
EAST GANGWAY
WEST GANGWAY
GANGWAY No 4
B.H. 8760
B.H. 8759
CO. No - 72 - 78
COUNTER No 478
R. CO. RESERVE
No 72-78
No 258 TUNNEL
ROAD No 154
ROAD No 25
ROAD No 57
ROAD No 17
GANGWAY No 6
GANGWAY No 3
GANGWAY No 5
GANGWAY No 12
GANGWAY No 2
COUNTER No 485
BH 609
BH 5865
HILL FORGE
BH 5815
No 372 TUNNEL
SECTION LINE
B-11-12
SECTION LINE
B-11-13
SECTION LINE
B-12-16
SECTION LINE
B-12-23
B-12-20
B-8-7
B-12-37
TRACING NO. 10
TRACING NO.10
TRACING NO.11
TRACING NO.1