


50-51
FOUR VEIN
50-51

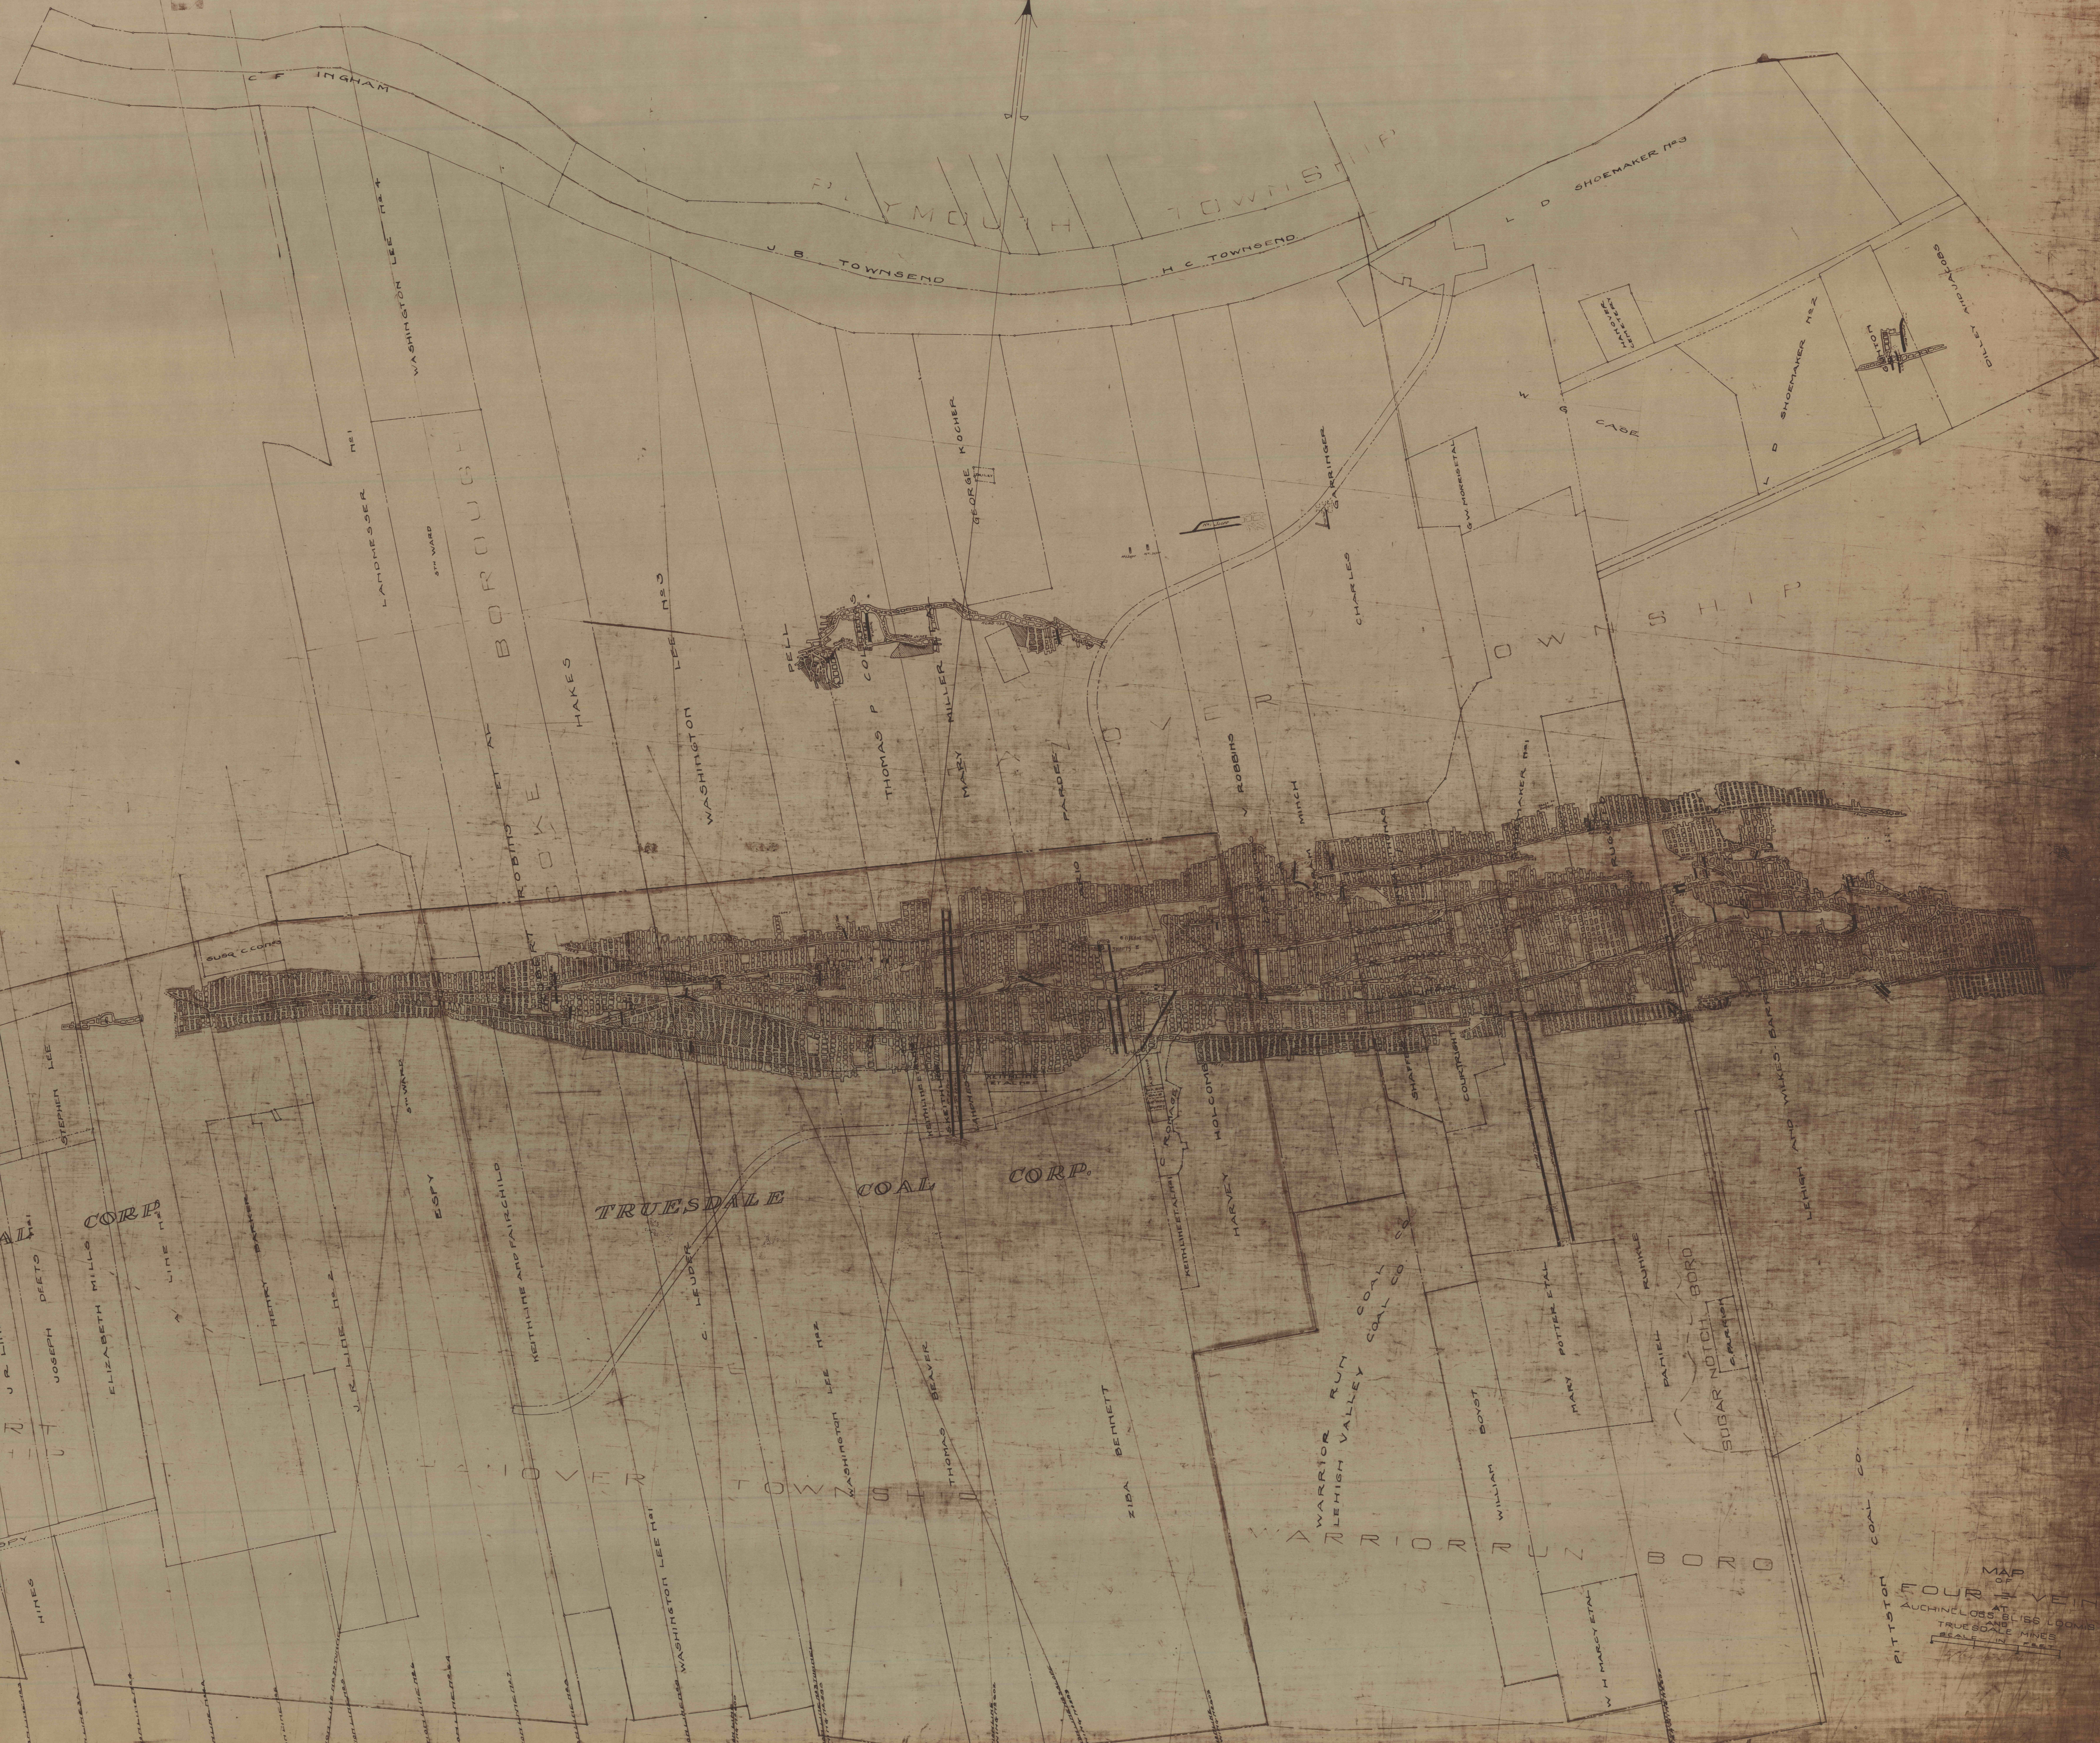

MAP OF
FOUR VEIN
SCALE IN FEET
1884

50-51