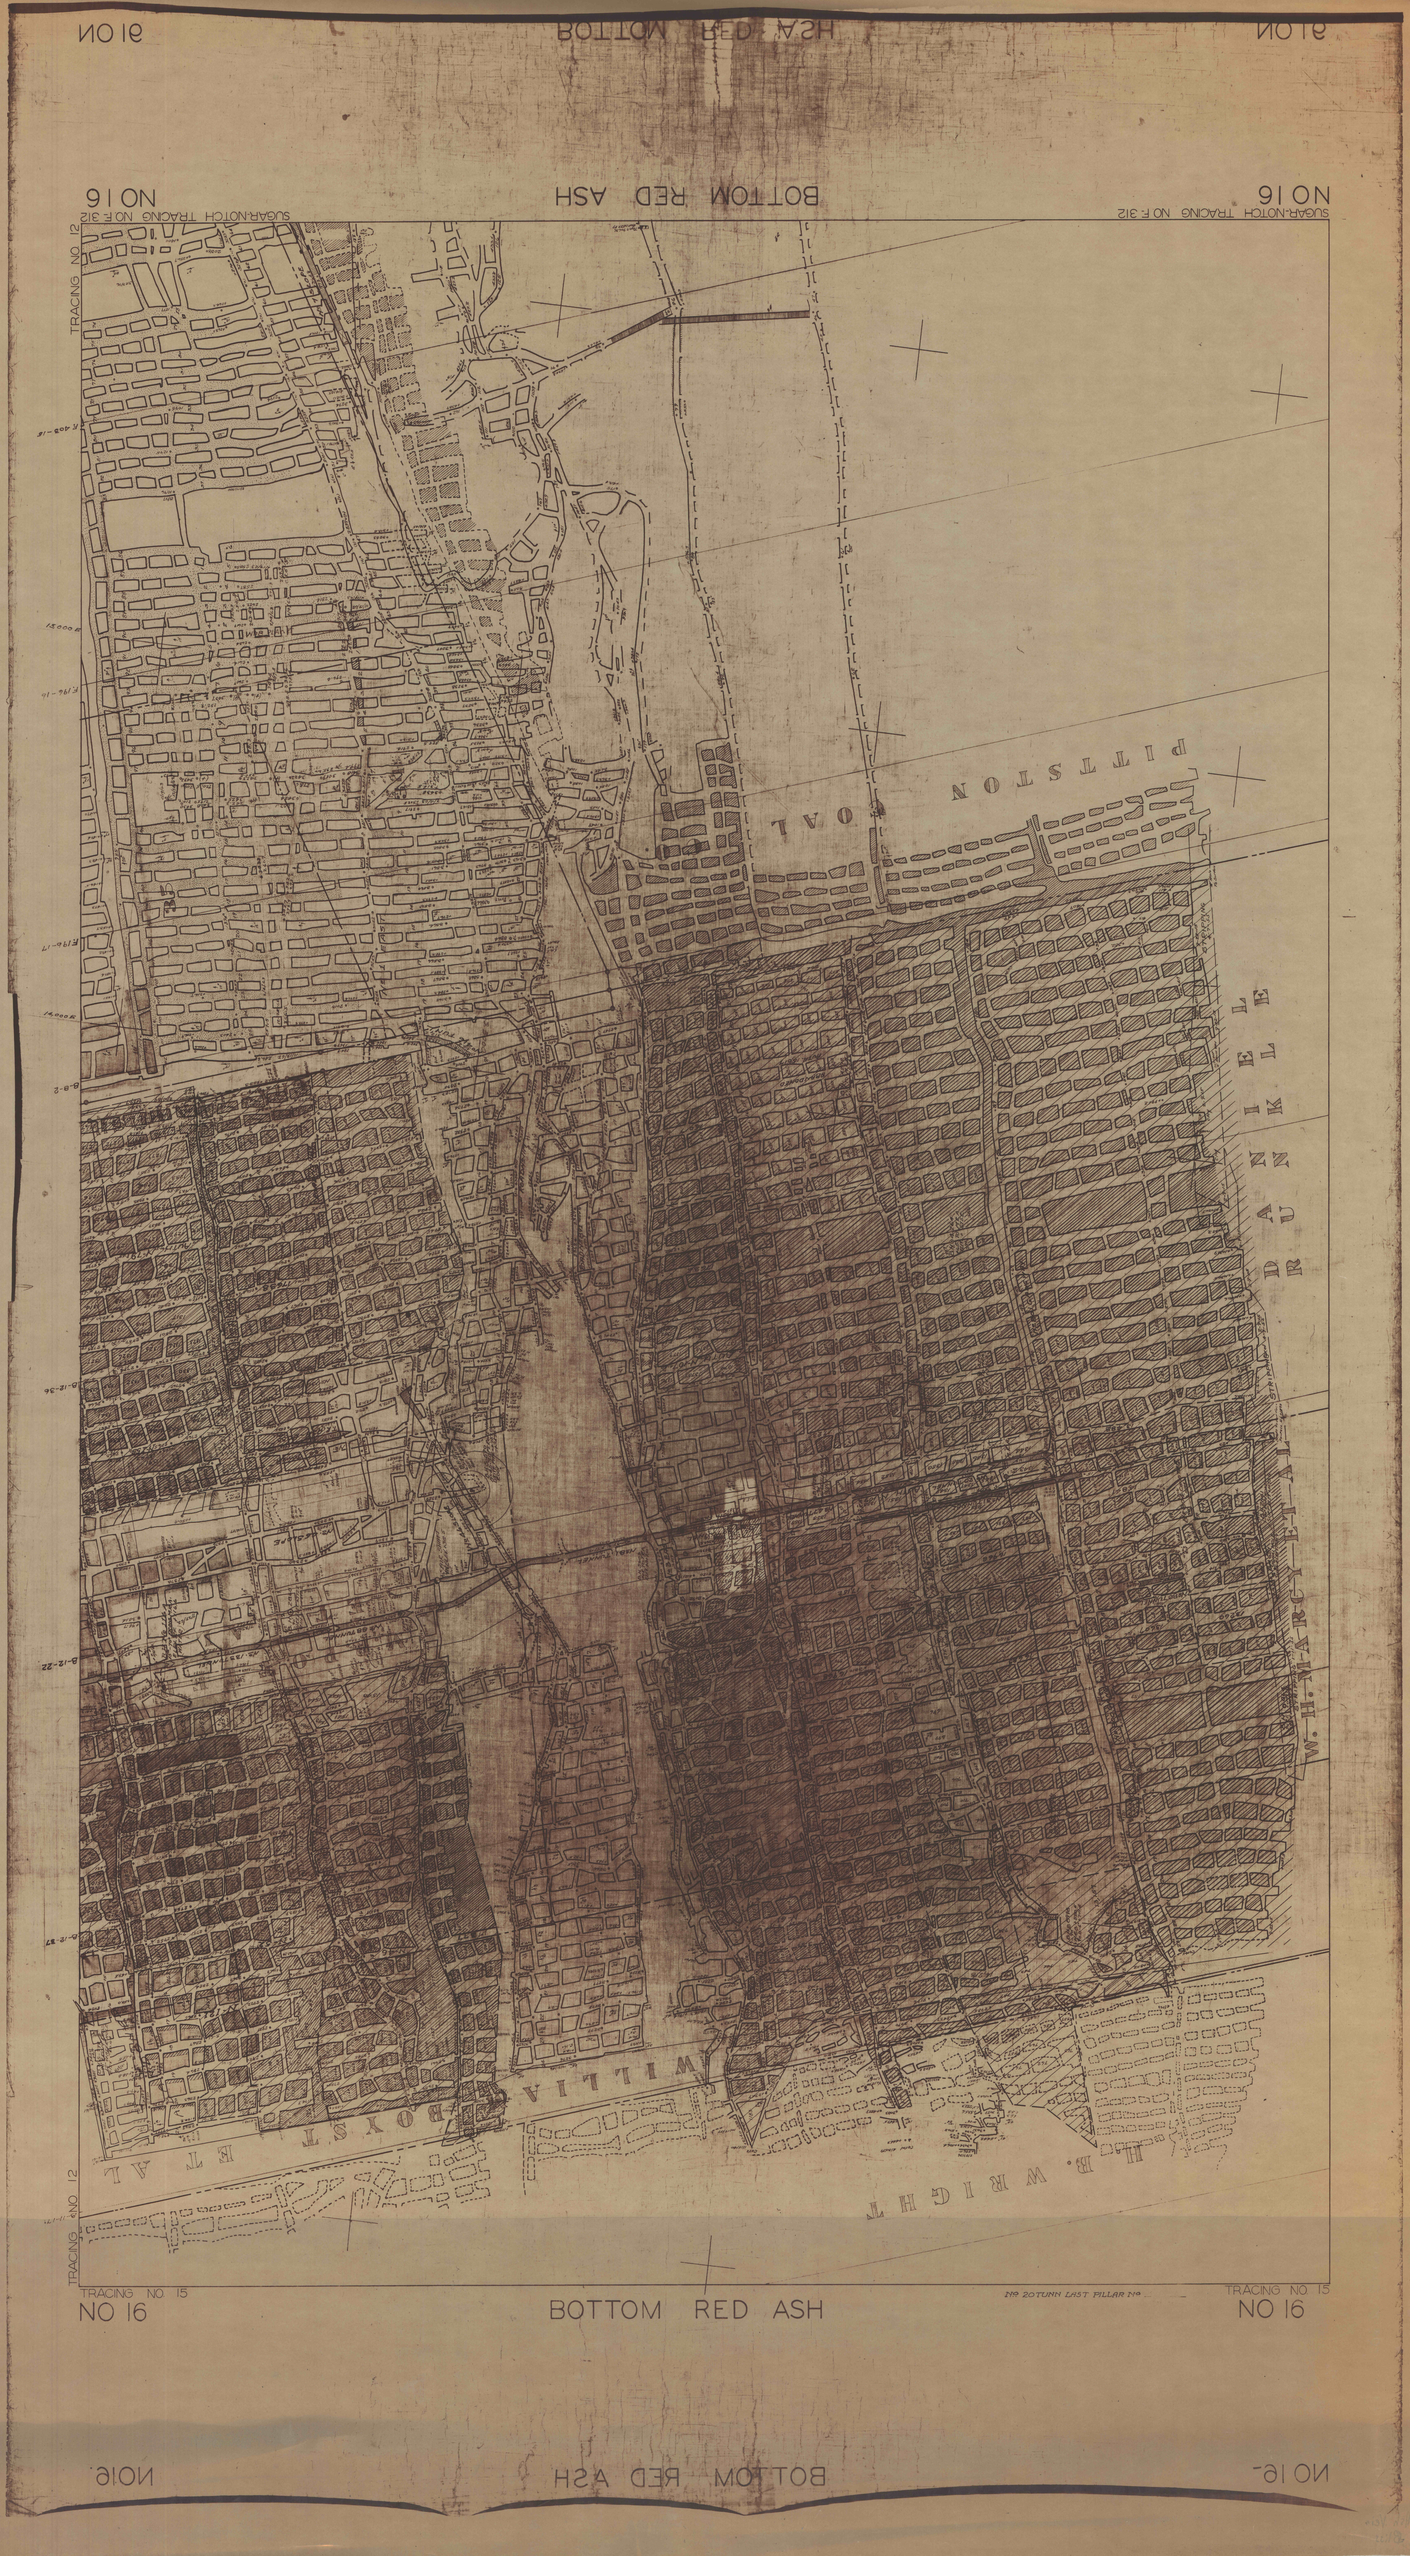

NO 16
BOTTOM RED ASH
SUGAR-NOTCH TRACING NO F 312
TRACING NO 12
PITTSTON COAL
DANIEL RUNKLE
W. H. MARCY ETAL
H. B. WRIGHT
WILLIAM BOYST ETAL
TRACING NO 15
NO 16
BOTTOM RED ASH
No 20 TUNN LAST PILLAR No
TRACING NO 15
NO 16