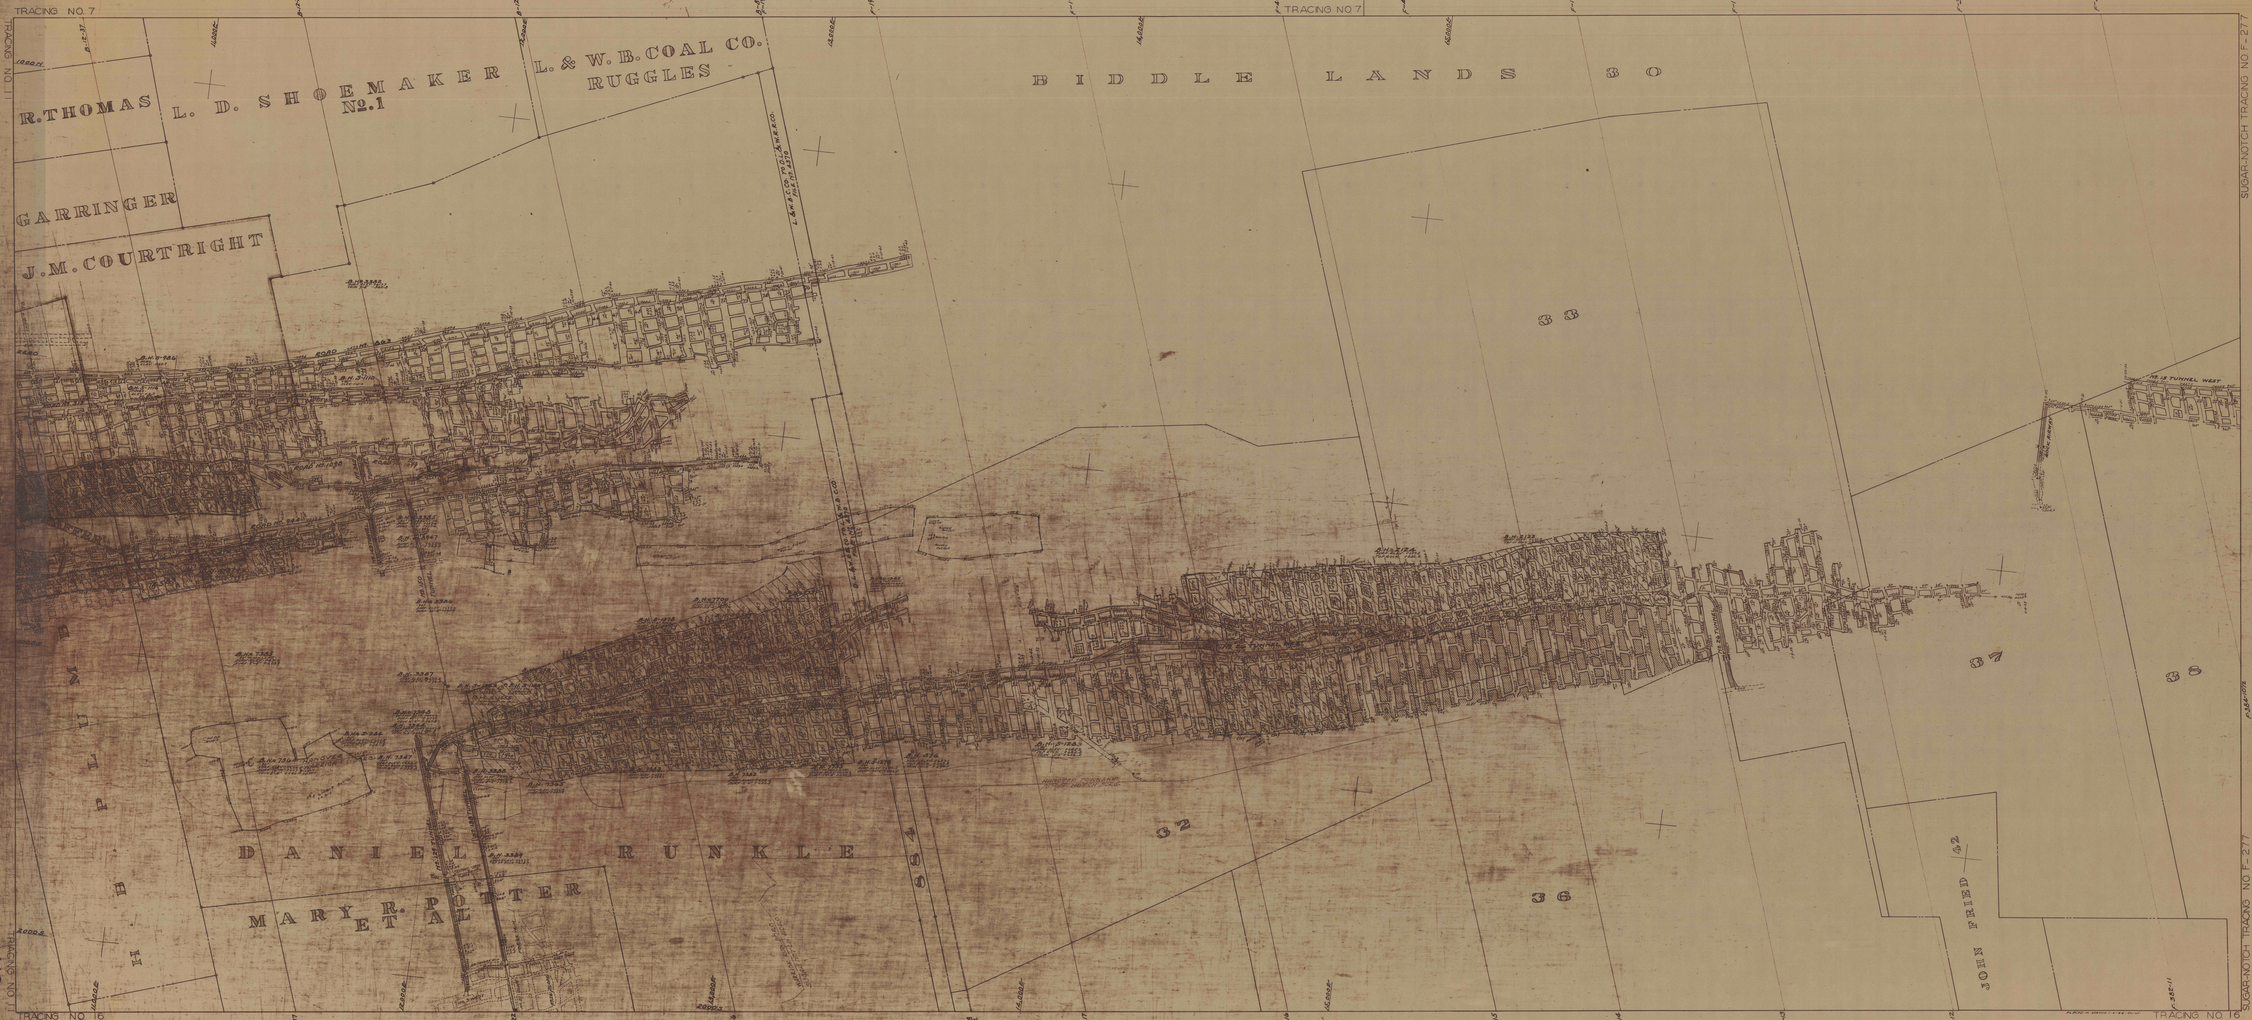
TRACING NO. 7
TRACING NO. 16
R. THOMAS
L. D. SHOEMAKER
No. 1
L. & W. B. COAL CO.
RUGGLES
BIDDLE LANDS 30
GARRINGER
J. M. COURTRIGHT
33
37
38
32
36
DANIEL RUNKLE
MARY R. POTTER
ET AL
JOHN FRIED
42
ABBOTT VEIN
NO. 12
NO. 15