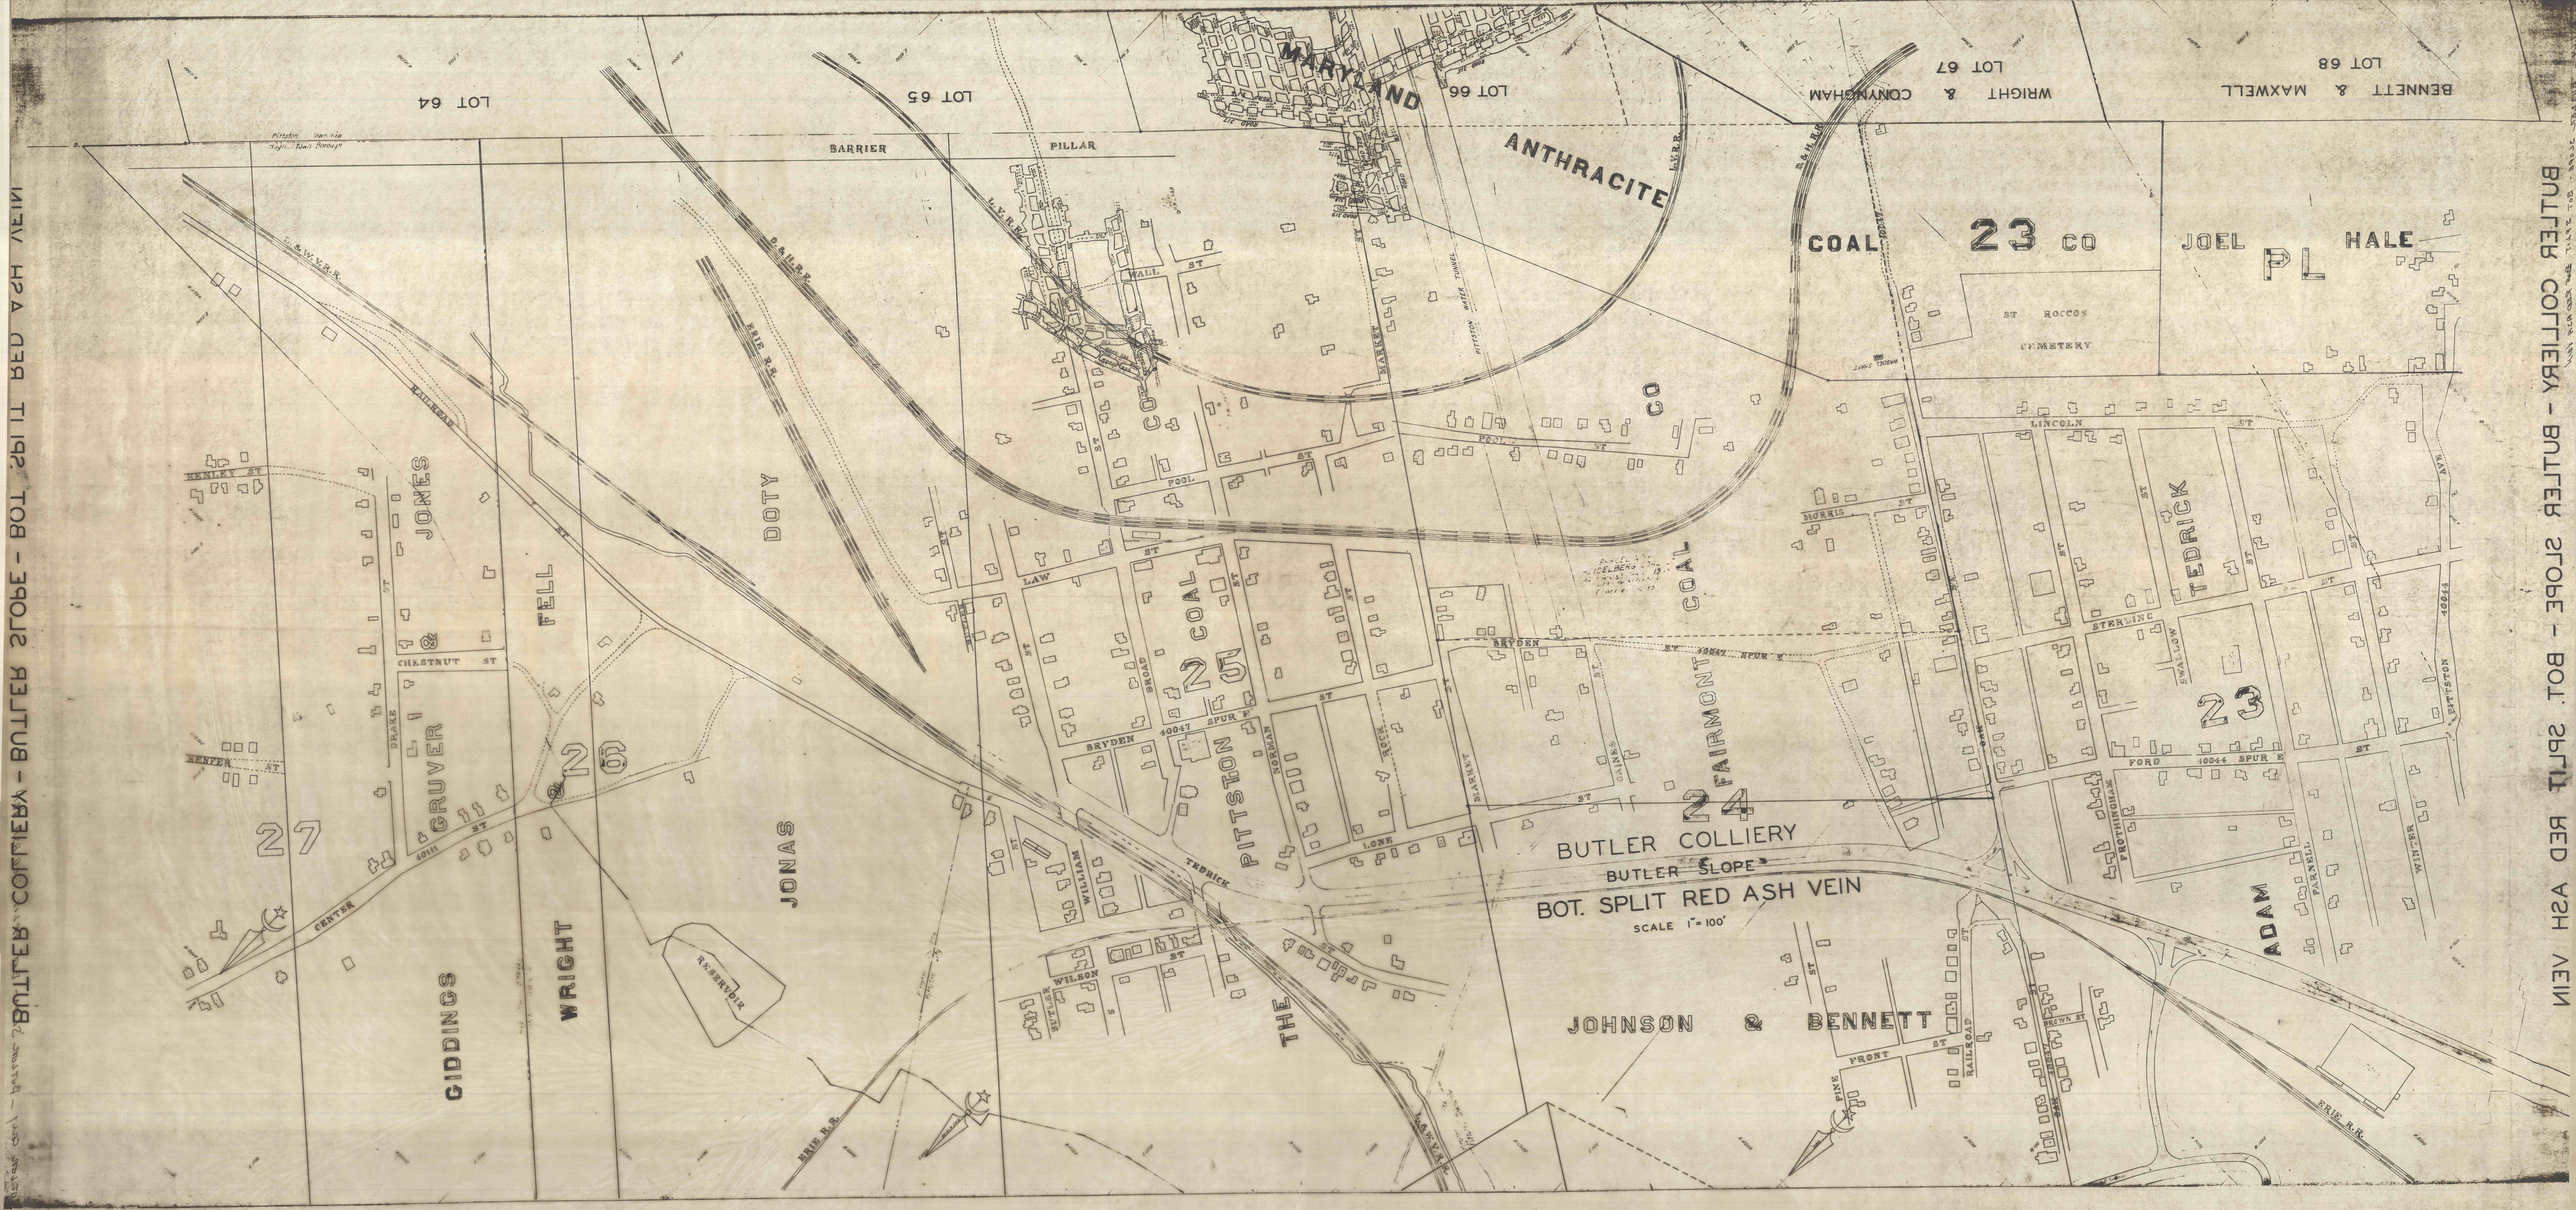
BUTLER COLLIERY - BUTLER SLOPE - BOT. SPLIT RED ASH VEIN
BUTLER COLLIERY - BUTLER SLOPE - BOT. SPLIT RED ASH VEIN
LOT 64
LOT 65
LOT 66
LOT 67
LOT 68
WRIGHT & CONYNGHAM
BENNETT & MAXWELL
BARRIER PILLAR
MARYLAND ANTHRACITE
COAL 23 CO
JOEL HALE
PL
ST ROCCOS CEMETERY
CO
CO
COAL
25
PITTSTON
FAIRMONT
COAL
24
BUTLER COLLIERY
BUTLER SLOPE
BOT. SPLIT RED ASH VEIN
SCALE 1" = 100'
JOHNSON & BENNETT
TEDRICK
23
ADAM
DOTY
JONES
FELL
GRUVER
26
27
JONAS
WRIGHT
GIDDINGS
RESERVOIR
THE
ERIE R.R.
L.V.R.R.
D.&H.R.R.
L.&W.V.R.R.
RAILROAD
CHESTNUT ST
BRYDEN
LAW
POOL
WALL
MARKET
LINCOLN
MORRIS
STERLING
FORD
FROTHINGHAM
PARNELL
WINTER
PITTSTON
WILLIAM
WILSON
TEDRICK
LONE
NORMAN
ROCK
BROAD
DRAKE
CENTER
BENLEY ST
BENFER ST
FRONT ST
PINE
BROWN ST
SWALLOW
40047 SPUR
40044 SPUR