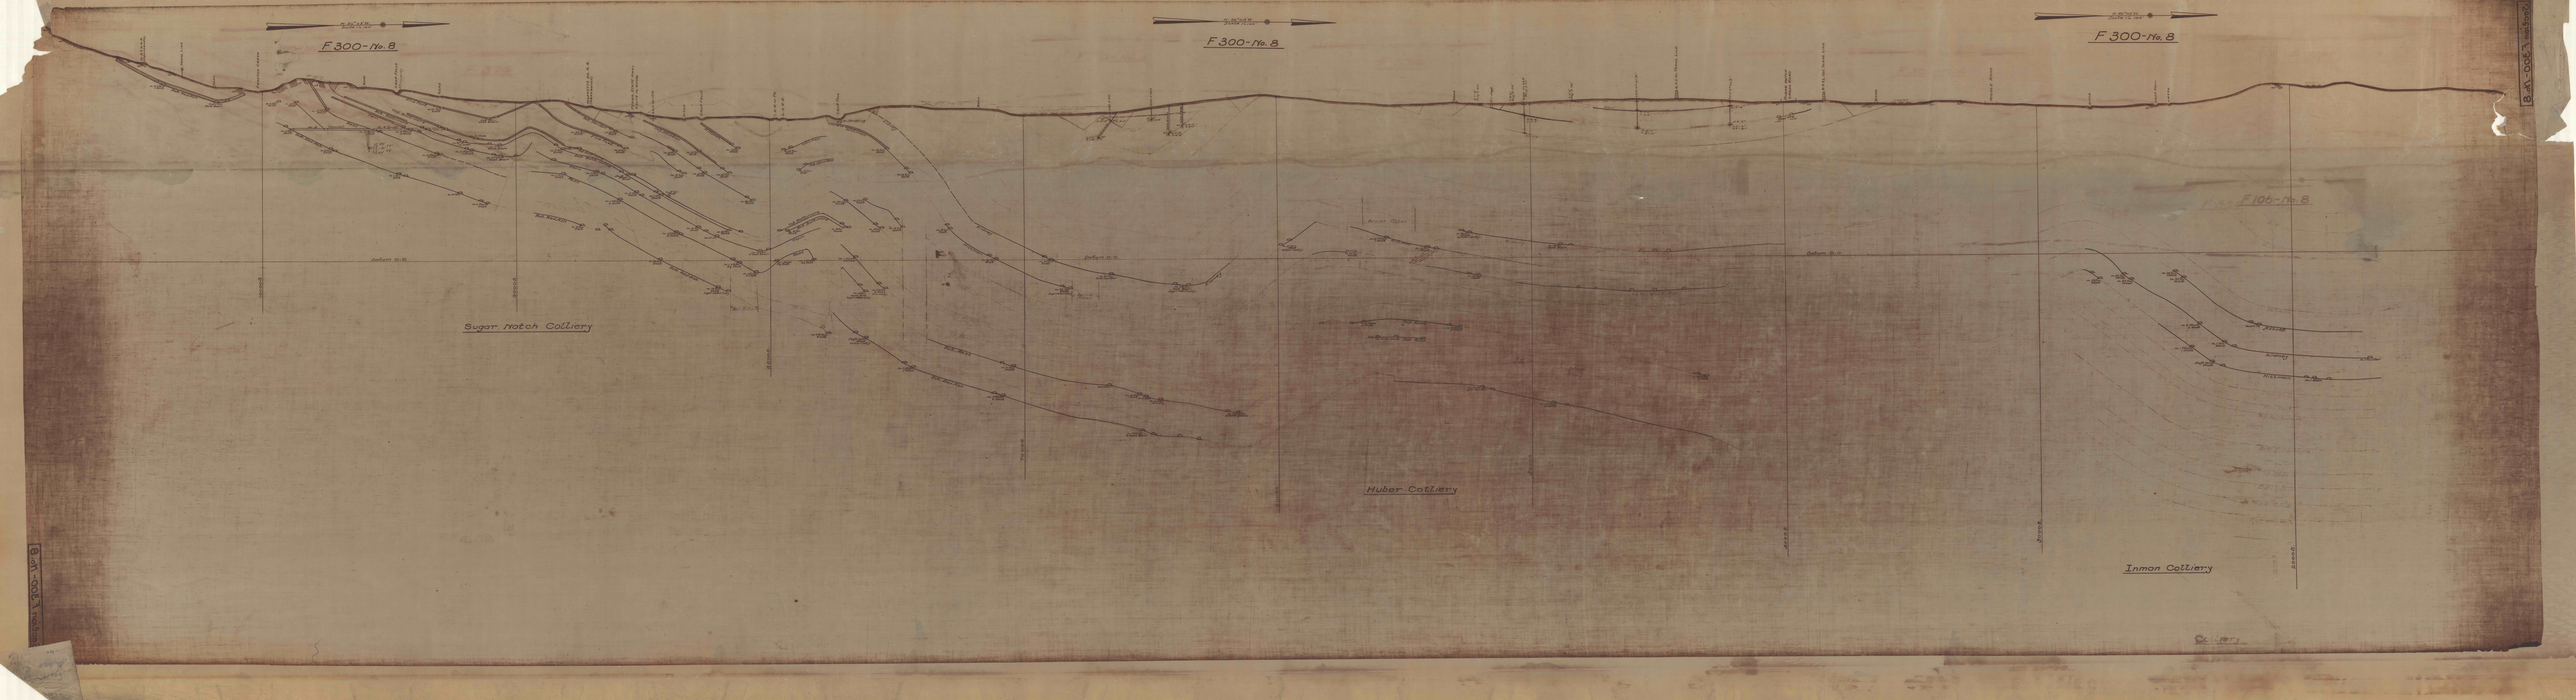
F 300-No. 8
F 300-No. 8
F 300-No. 8
F 100-No. 8
Sugar Notch Colliery
Huber Colliery
Inman Colliery