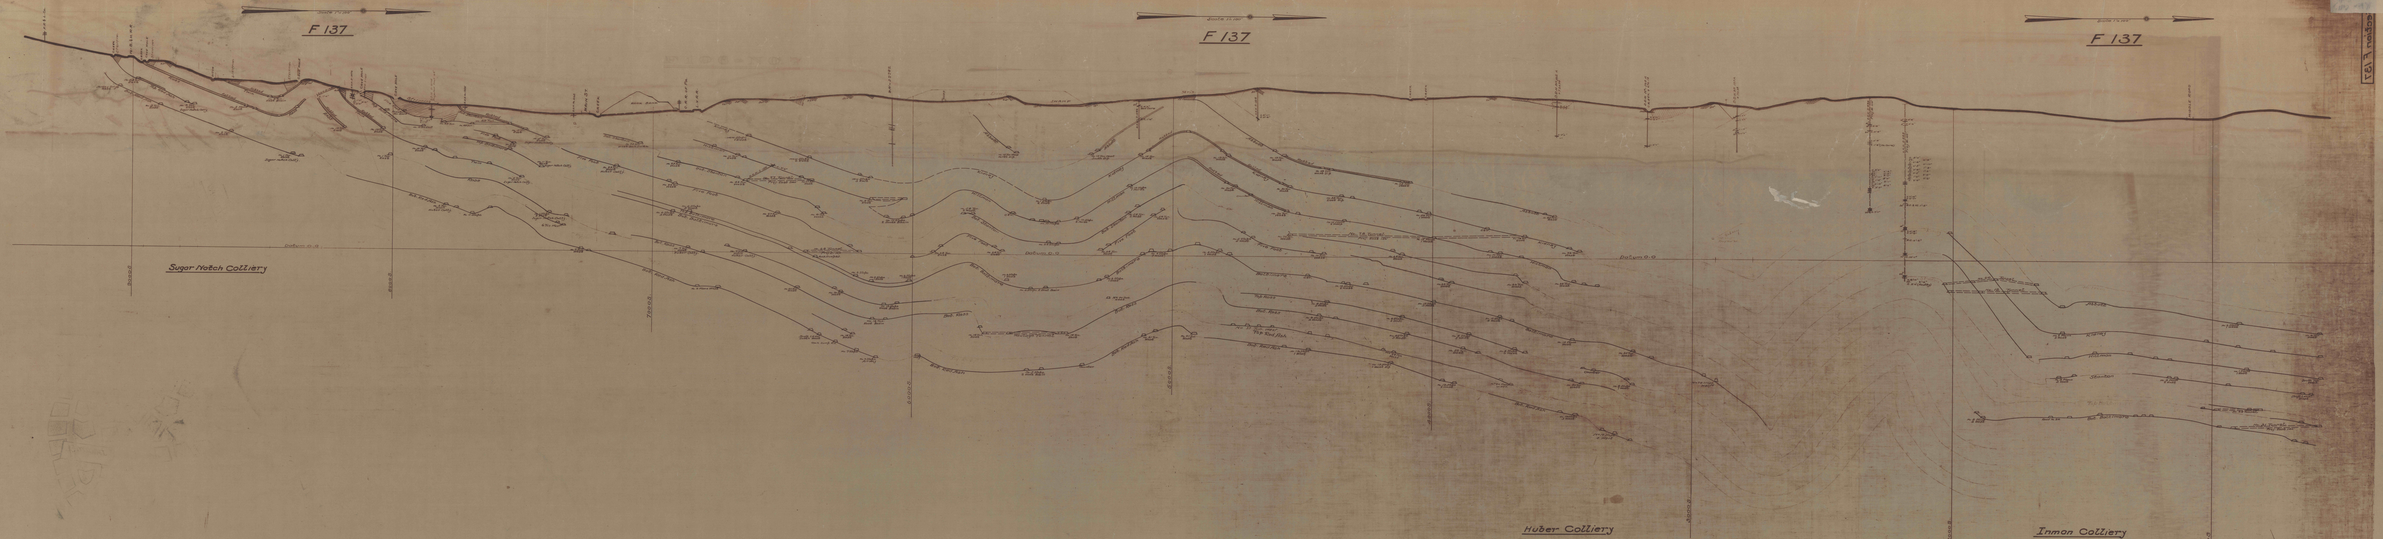
F 137
F 137
F 137
Sugar Notch Colliery
Huber Colliery
Inman Colliery
Section F 137
Section F 137