


LOOKING S.W. THRU PROPERTY
 IN VICINITY OF VAUGHAN STREET
 SCALE 1"=100'
 JAN 27 1930

 


3"

OLYPHANT DIVISION
 CROSS SECTION

THRU COAL MEASURES LOOKING S.W.
 VICINITY OF THE FERRIS LOT
 SCALE 1"=100'

DATE BY
 Feb 26 1930
 Mar 20 1930
 Nov 21 1930
 June 21 1932
 June 25 1932
 July 25 1932
 Sept 25 1932
 Oct 25 1932
 Nov 25 1932
 Dec 25 1932

3
 DEC 22 1930

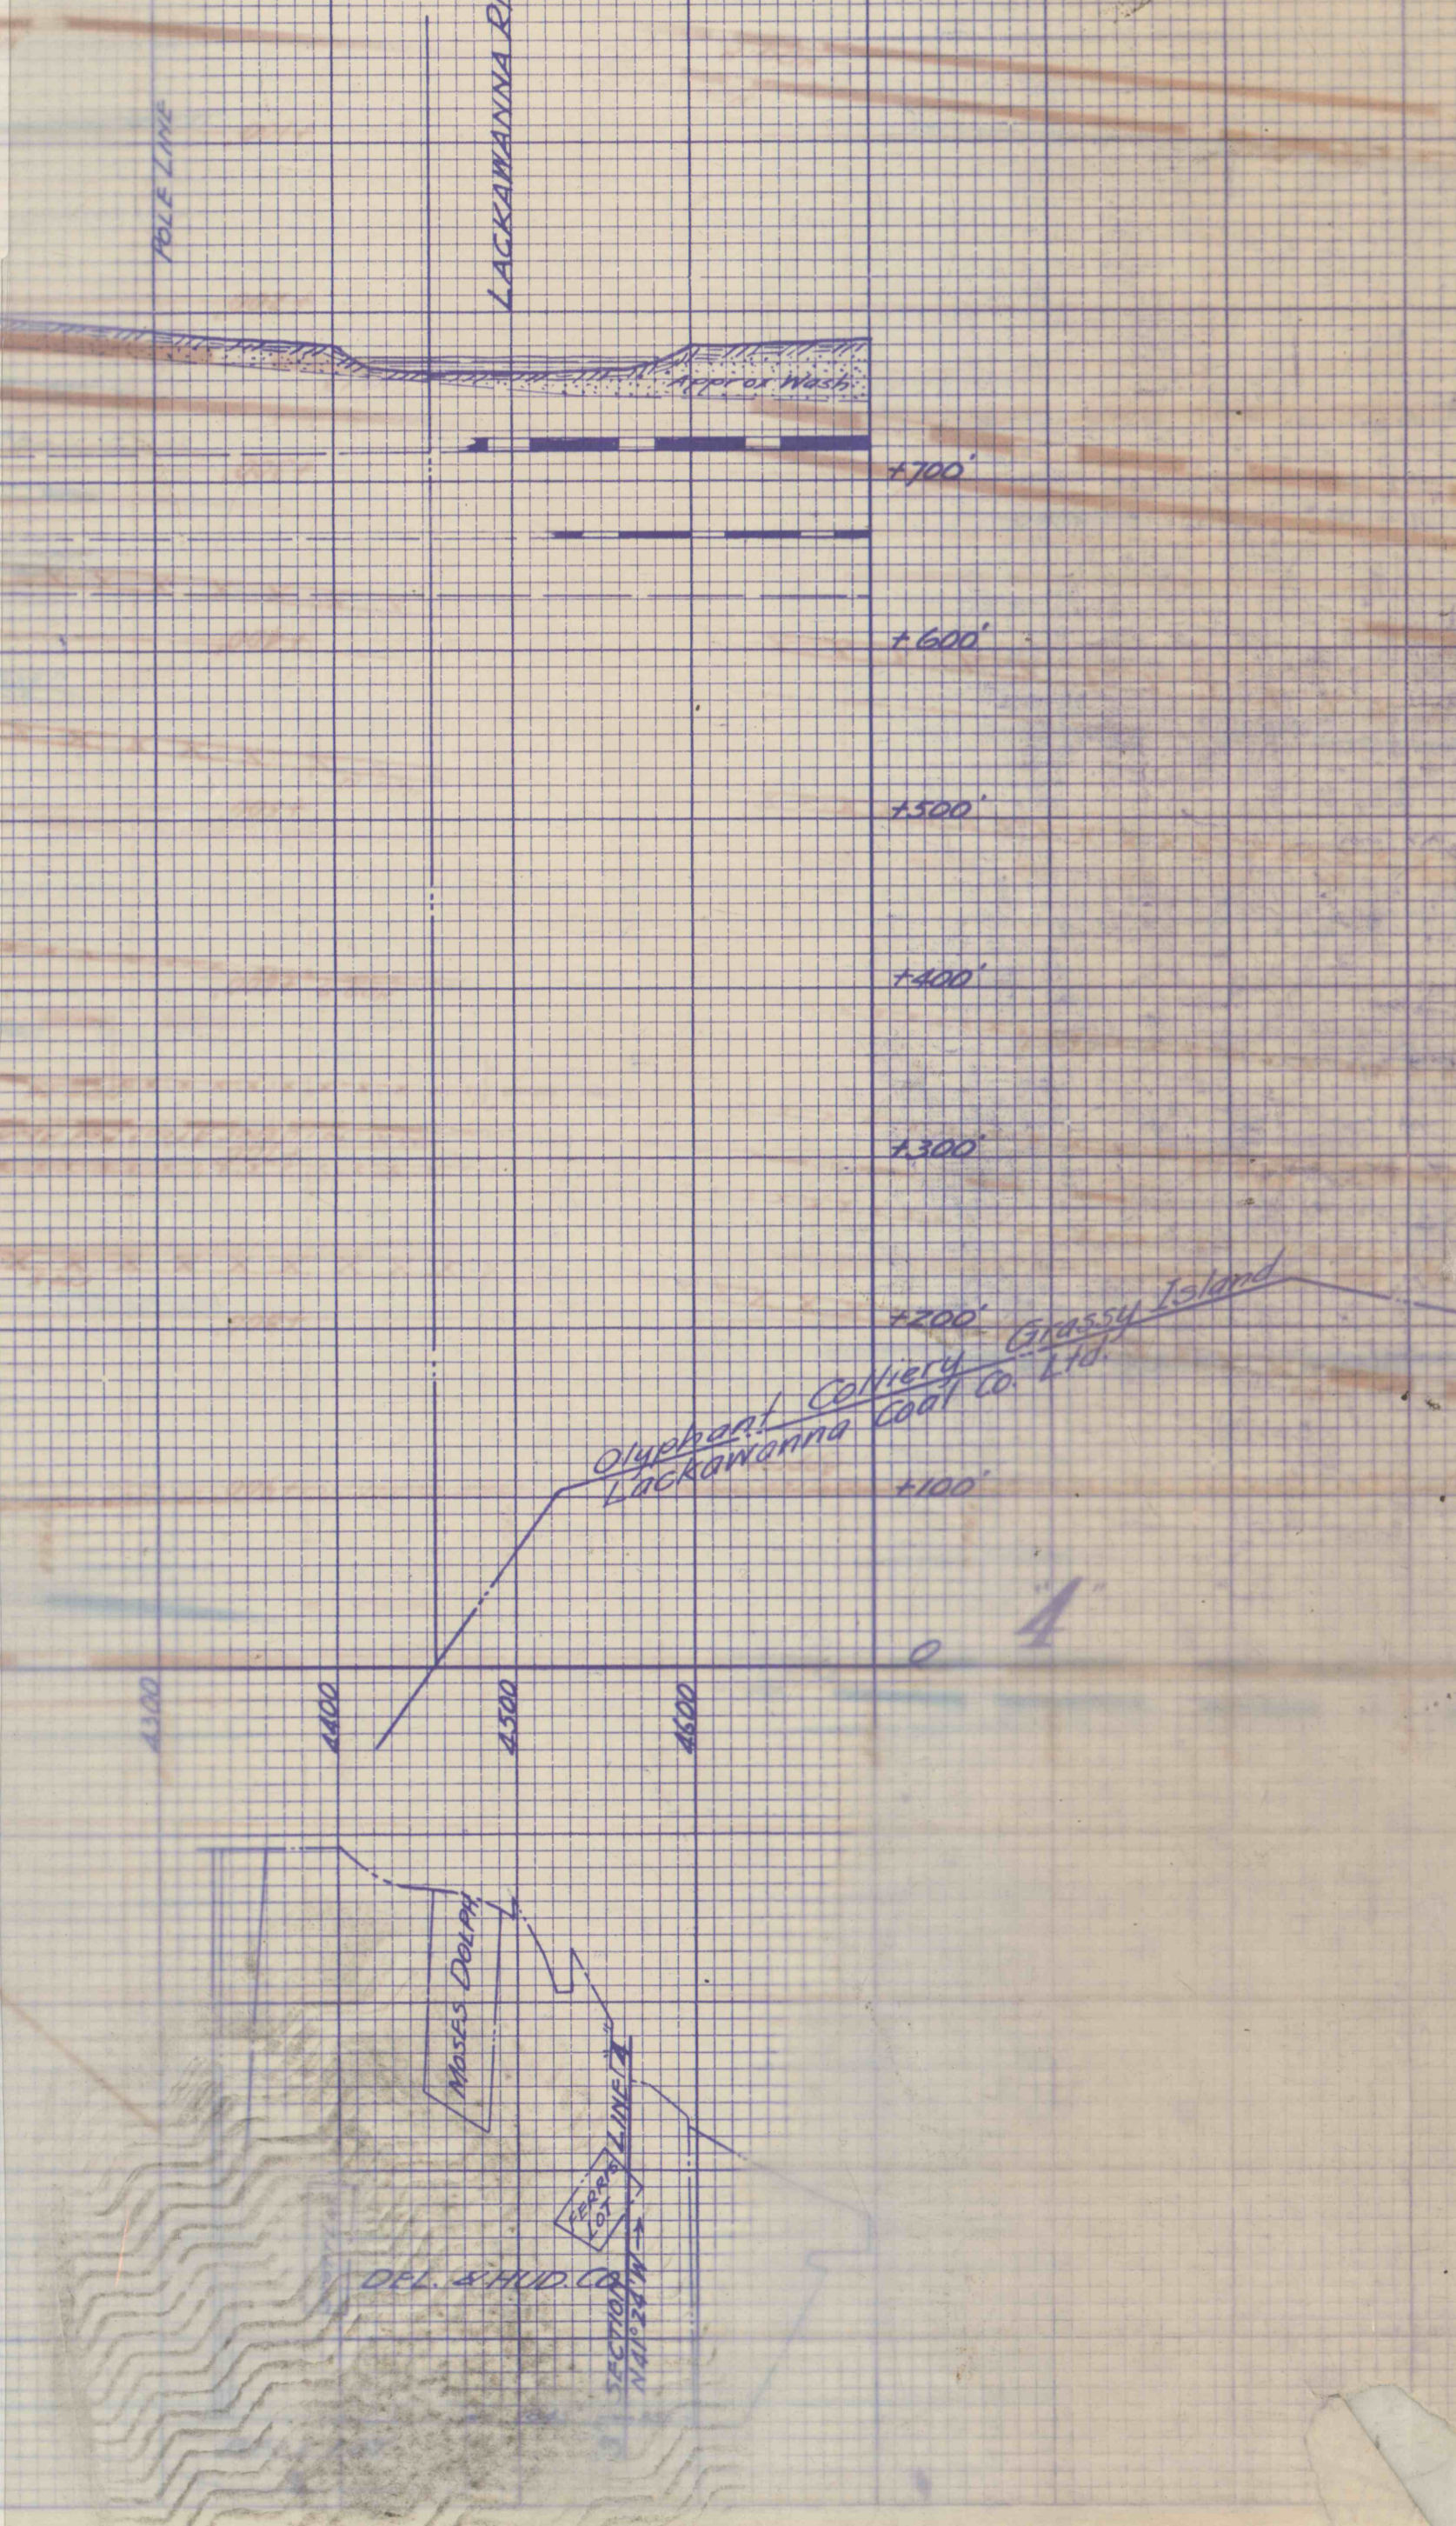

OLYPHANT DIVISION CROSS SECTION NO. 3-4