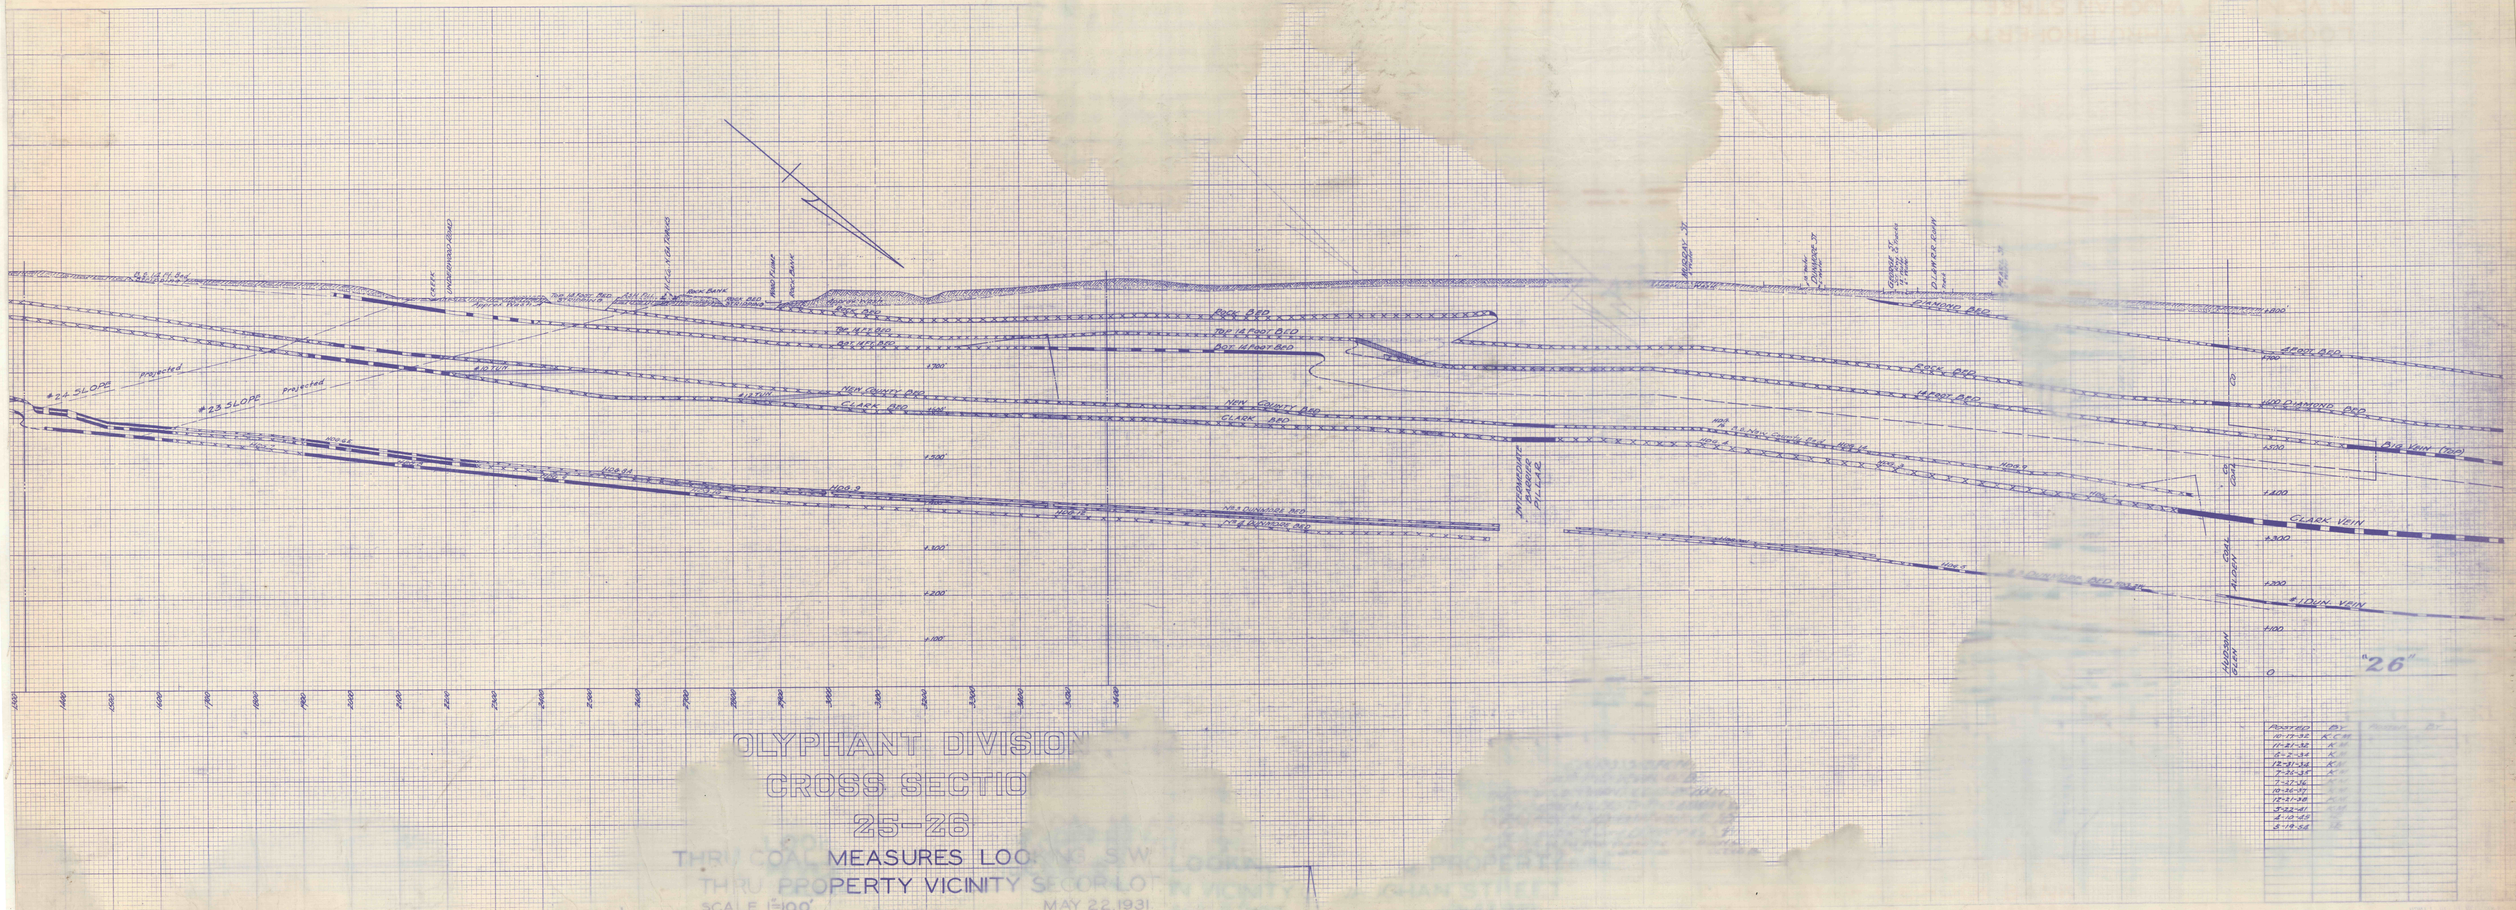

OLYPHANT DIVISION

CROSS SECTIO

25-26

MEASURES LOC

PERTY VICINITY SECOR LOT

THRU COAL

THRU PROPERTY

SCALE 1"=100'

MAY 22, 1931

"26"

REVISED	BY
10-27-32	K.C.F.
11-21-32	A.
10-2-34	A.
12-21-34	A.
7-25-35	A.
7-27-36	
10-26-37	
12-21-38	
5-22-41	
4-10-42	
8-19-42	