


OLYPHANT DIVISION  
CROSS SECTION  
23-24

LOOKING S.W. THRU PROPERTY  
IN VICINITY OF STEINECKE ST.  
SCALE 1"=100'  
SEPT. 1931.

LOOKING SW THRU PROPERTY  
IN VICINITY OF E C CROCK BANK  
SCALE 1"=100'  
JAN 28 1931

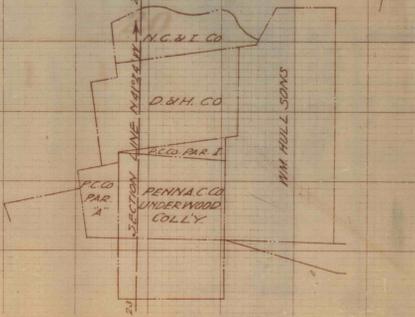

POSTED	BY	POSTED	BY
11-21-32	K.M.		
6-5-34	K.M.		
1-3-35	K.M.		
7-26-35	K.M.		
7-27-36	K.M.		
10-26-37	K.M.		
3-22-41	K.M.		
3-27-45	H.R.		
8-18-51	T.R.		