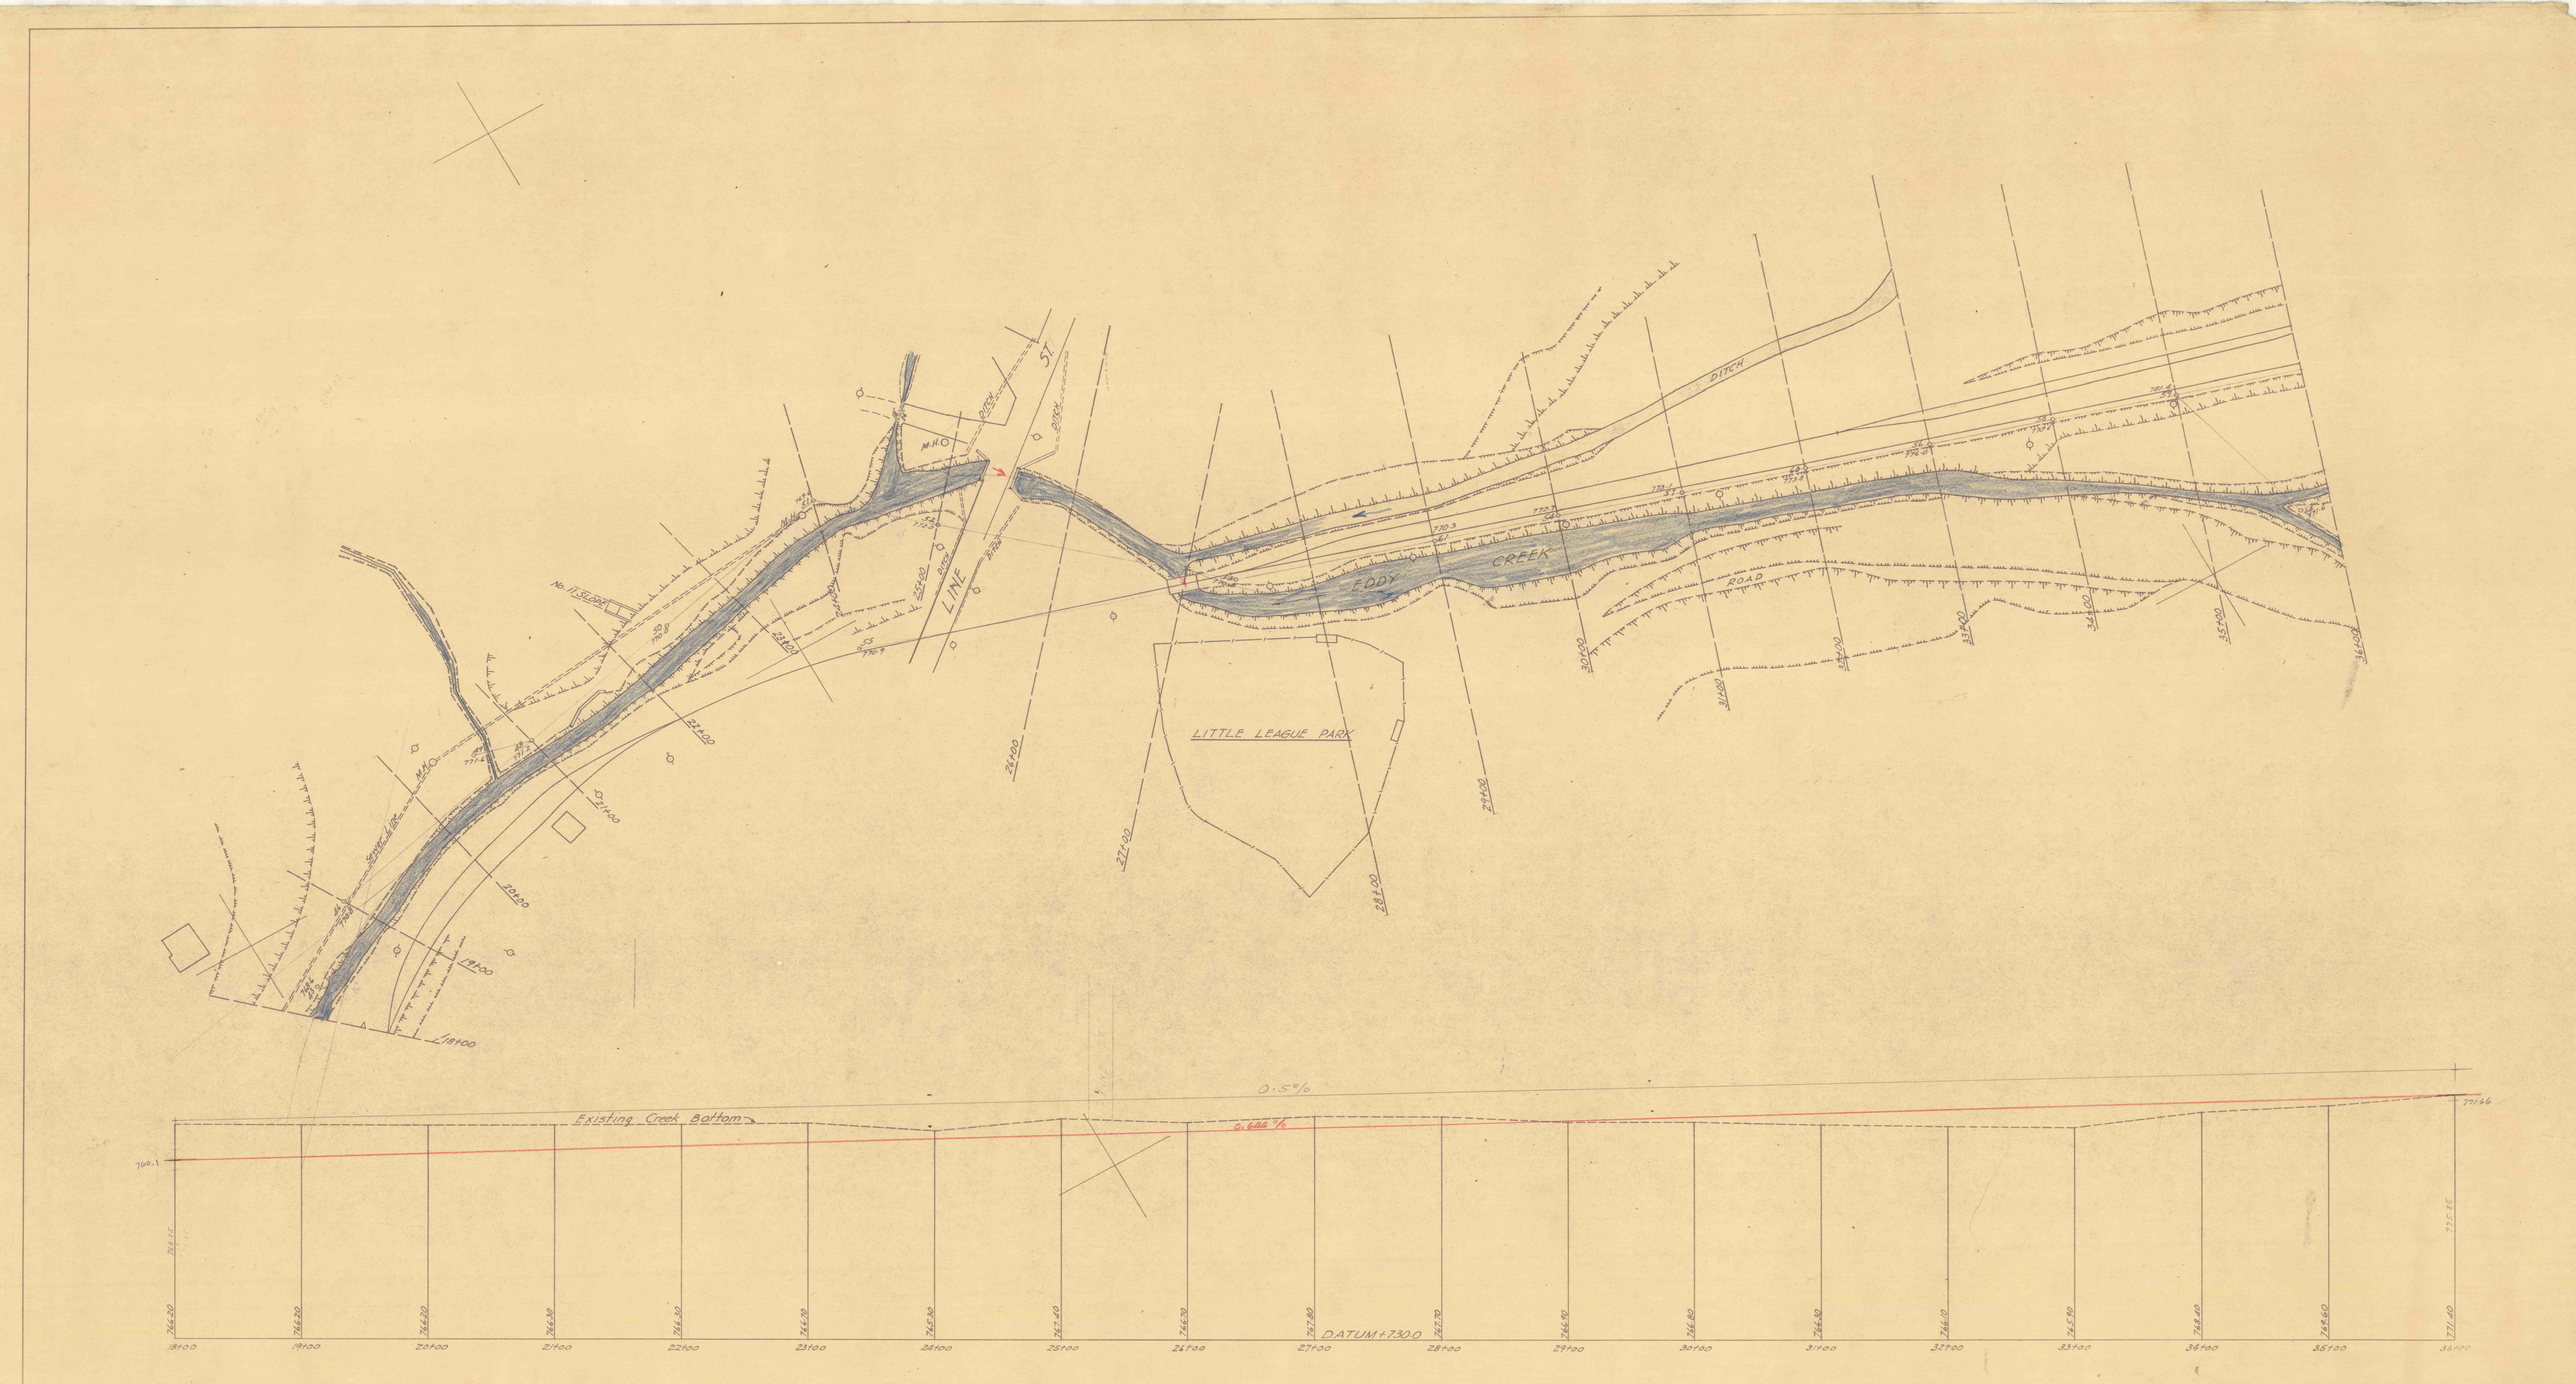

EDDY CREEK
DITCH
ROAD
LINE
ST.
LITTLE LEAGUE PARK
No. 11 SLOPE
Existing Creek Bottom
0.5%
0.644%
DATUM +730.0
18+00
19+00
20+00
21+00
22+00
23+00
24+00
25+00
26+00
27+00
28+00
29+00
30+00
31+00
32+00
33+00
34+00
35+00
36+00