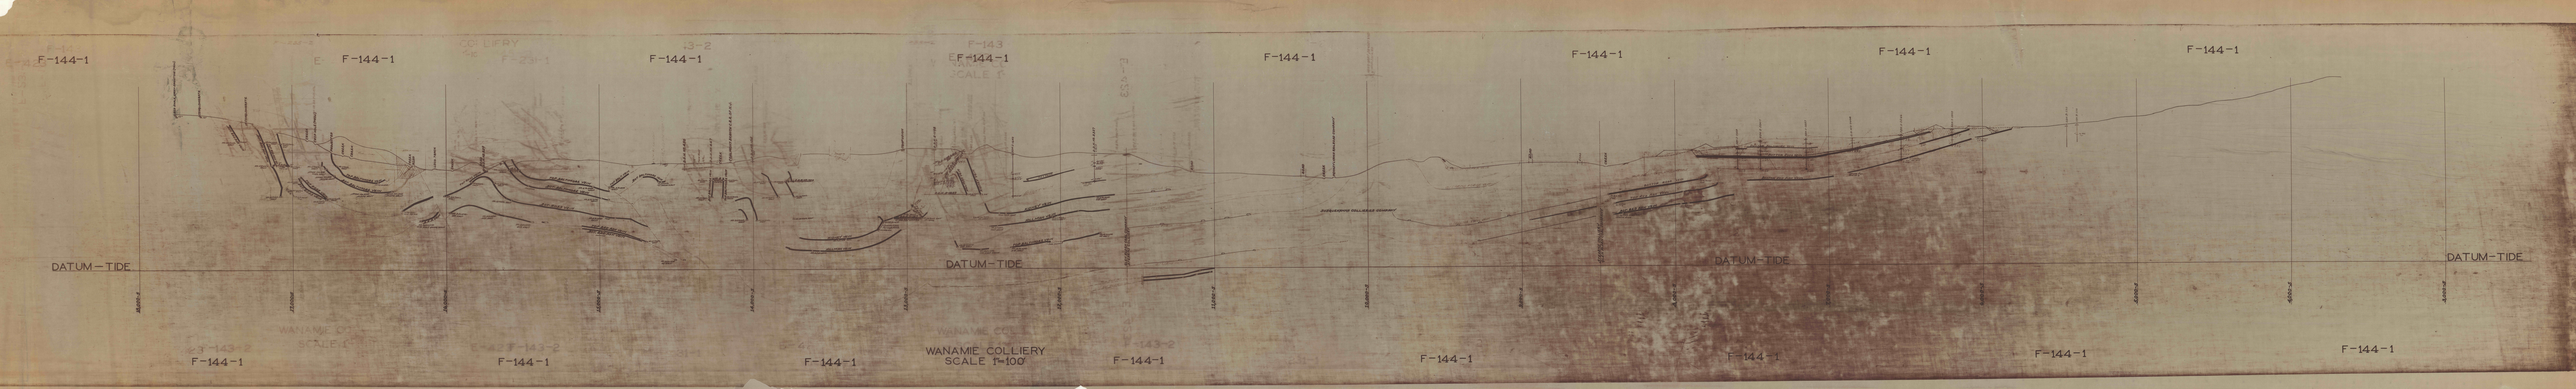
F-144-1
DATUM-TIDE
WANAMIE COLLIERY
SCALE 1"=100'