


GEORGE PECK

EDWIN McNEIL

ERNEST PESTEBONE

PESTEBONE

BLACK DIAMOND COLLIERY

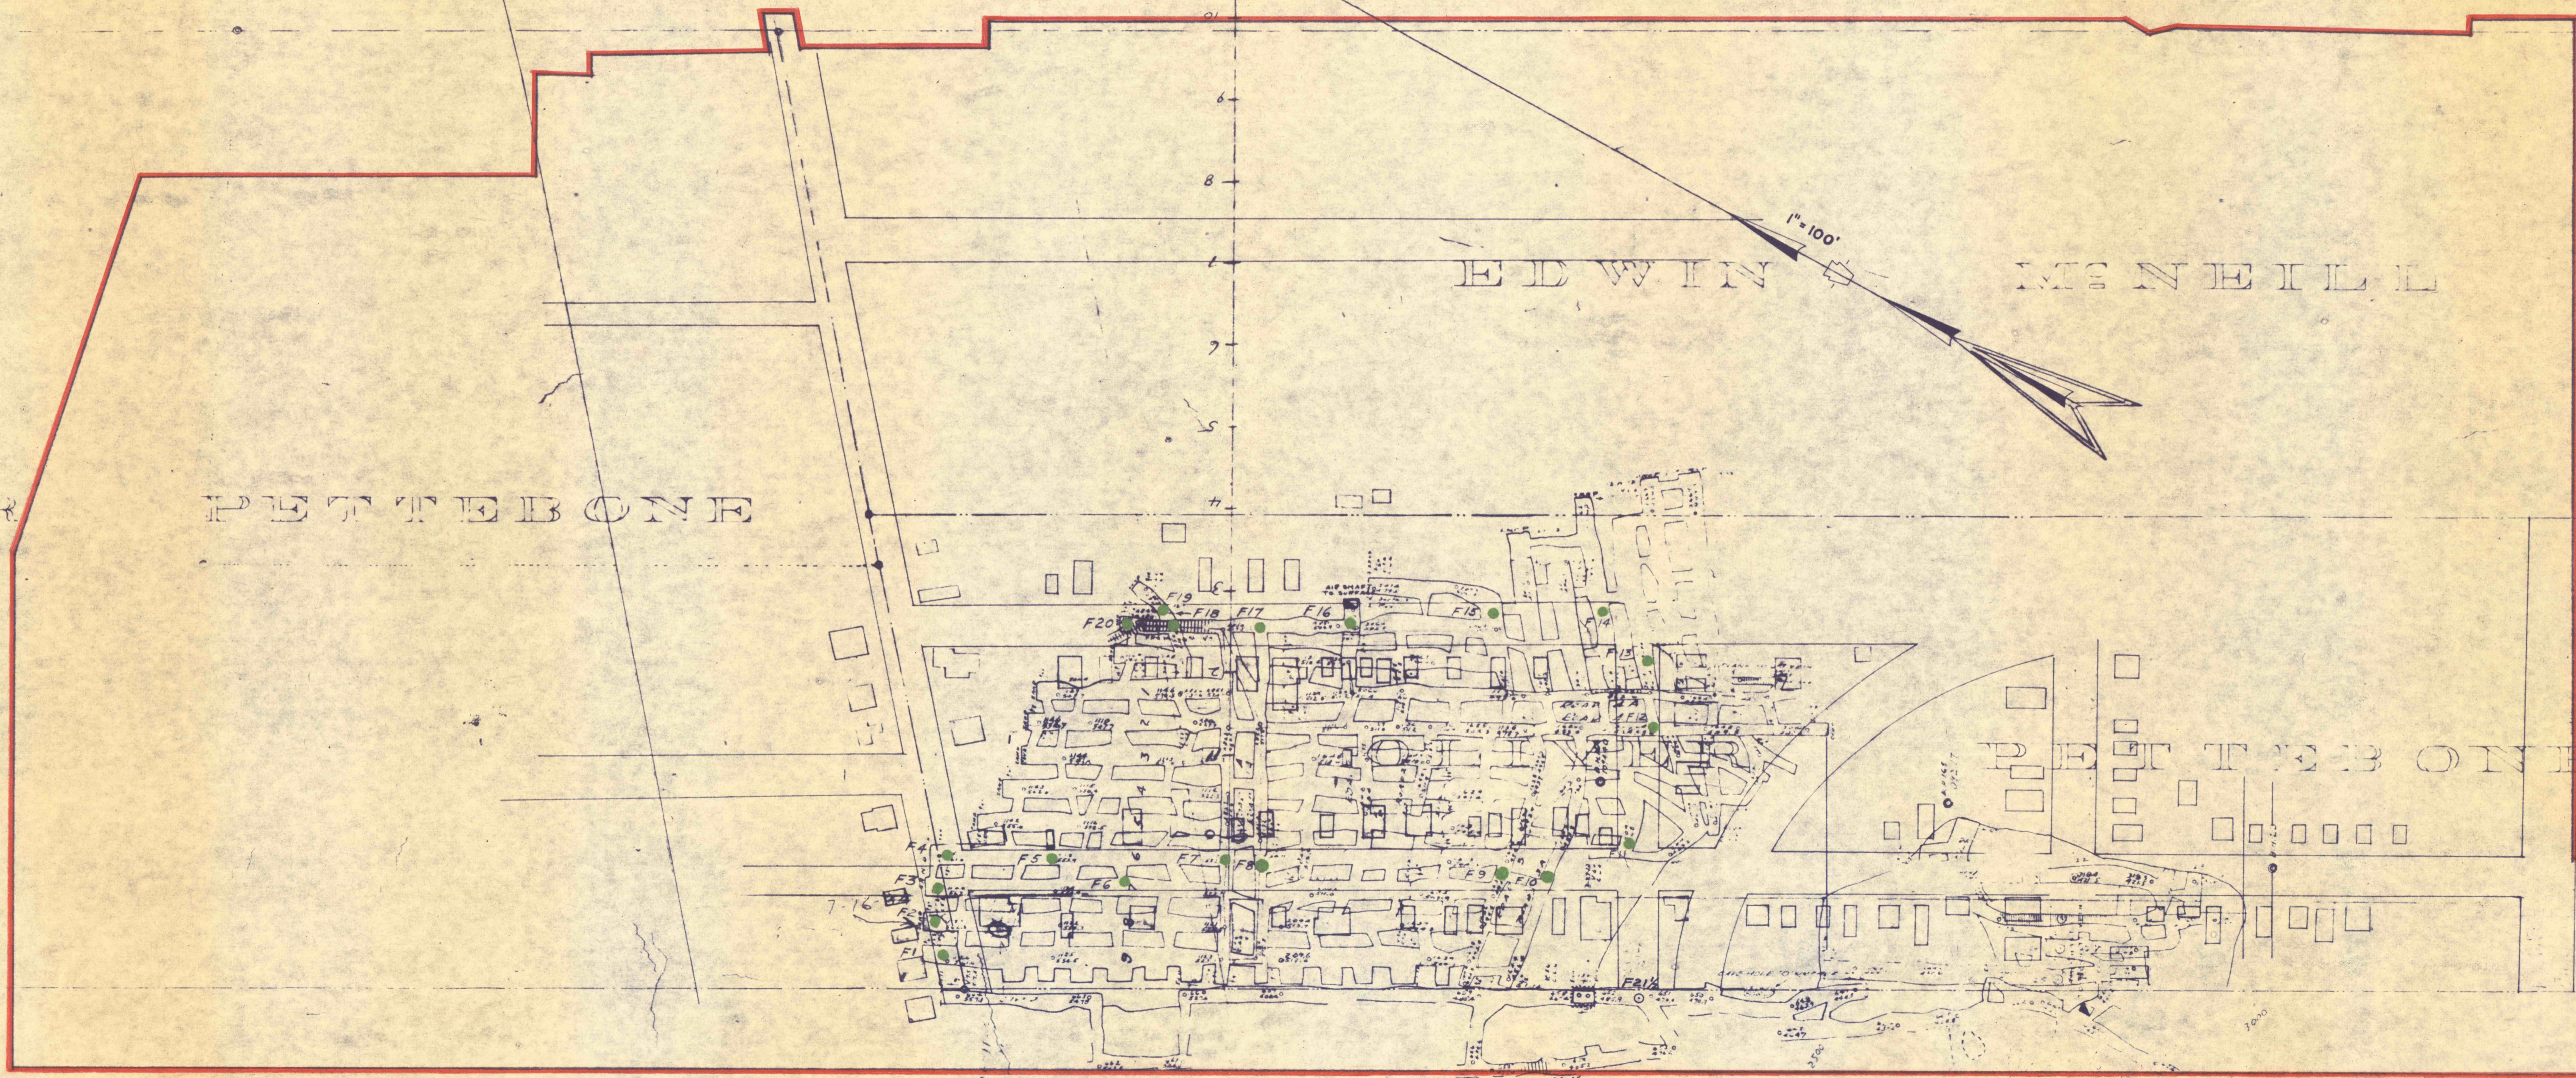

LEGEND

BORING HOLES THIS CONTRACT NO.FE40:7

COMMONWEALTH OF PENNSYLVANIA
 DEPARTMENT OF ENVIRONMENTAL RESOURCES
 OFFICE OF RESOURCES MANAGEMENT

**DRILLING & CASING EXPLORATORY
 BOREHOLES**

**ABANDONED HARRY E. COLL'Y
 FOUR FOOT VEIN**

BORO. OF SWOYERSVILLE, LUZERNE COUNTY
 WITHIN THE AREAS OF DIAMOND, SLOCUM, CHURCH, OLIVER, STREETS. PENNSYLVANIA

DESIGNED: _____ DATE: _____
 DRAWN: _____ SUBM: _____ DISTRICT ENGINEER: _____
 RECOM: _____ DIRECTOR: _____
 GROUP LEADER: _____ APPR: _____ DEPUTY SECRETARY OF RESOURCES MANAGE.

DWG. NO.FE40:7-1-2