


P E N N S Y L V A N I A

G E O R G E P E C K

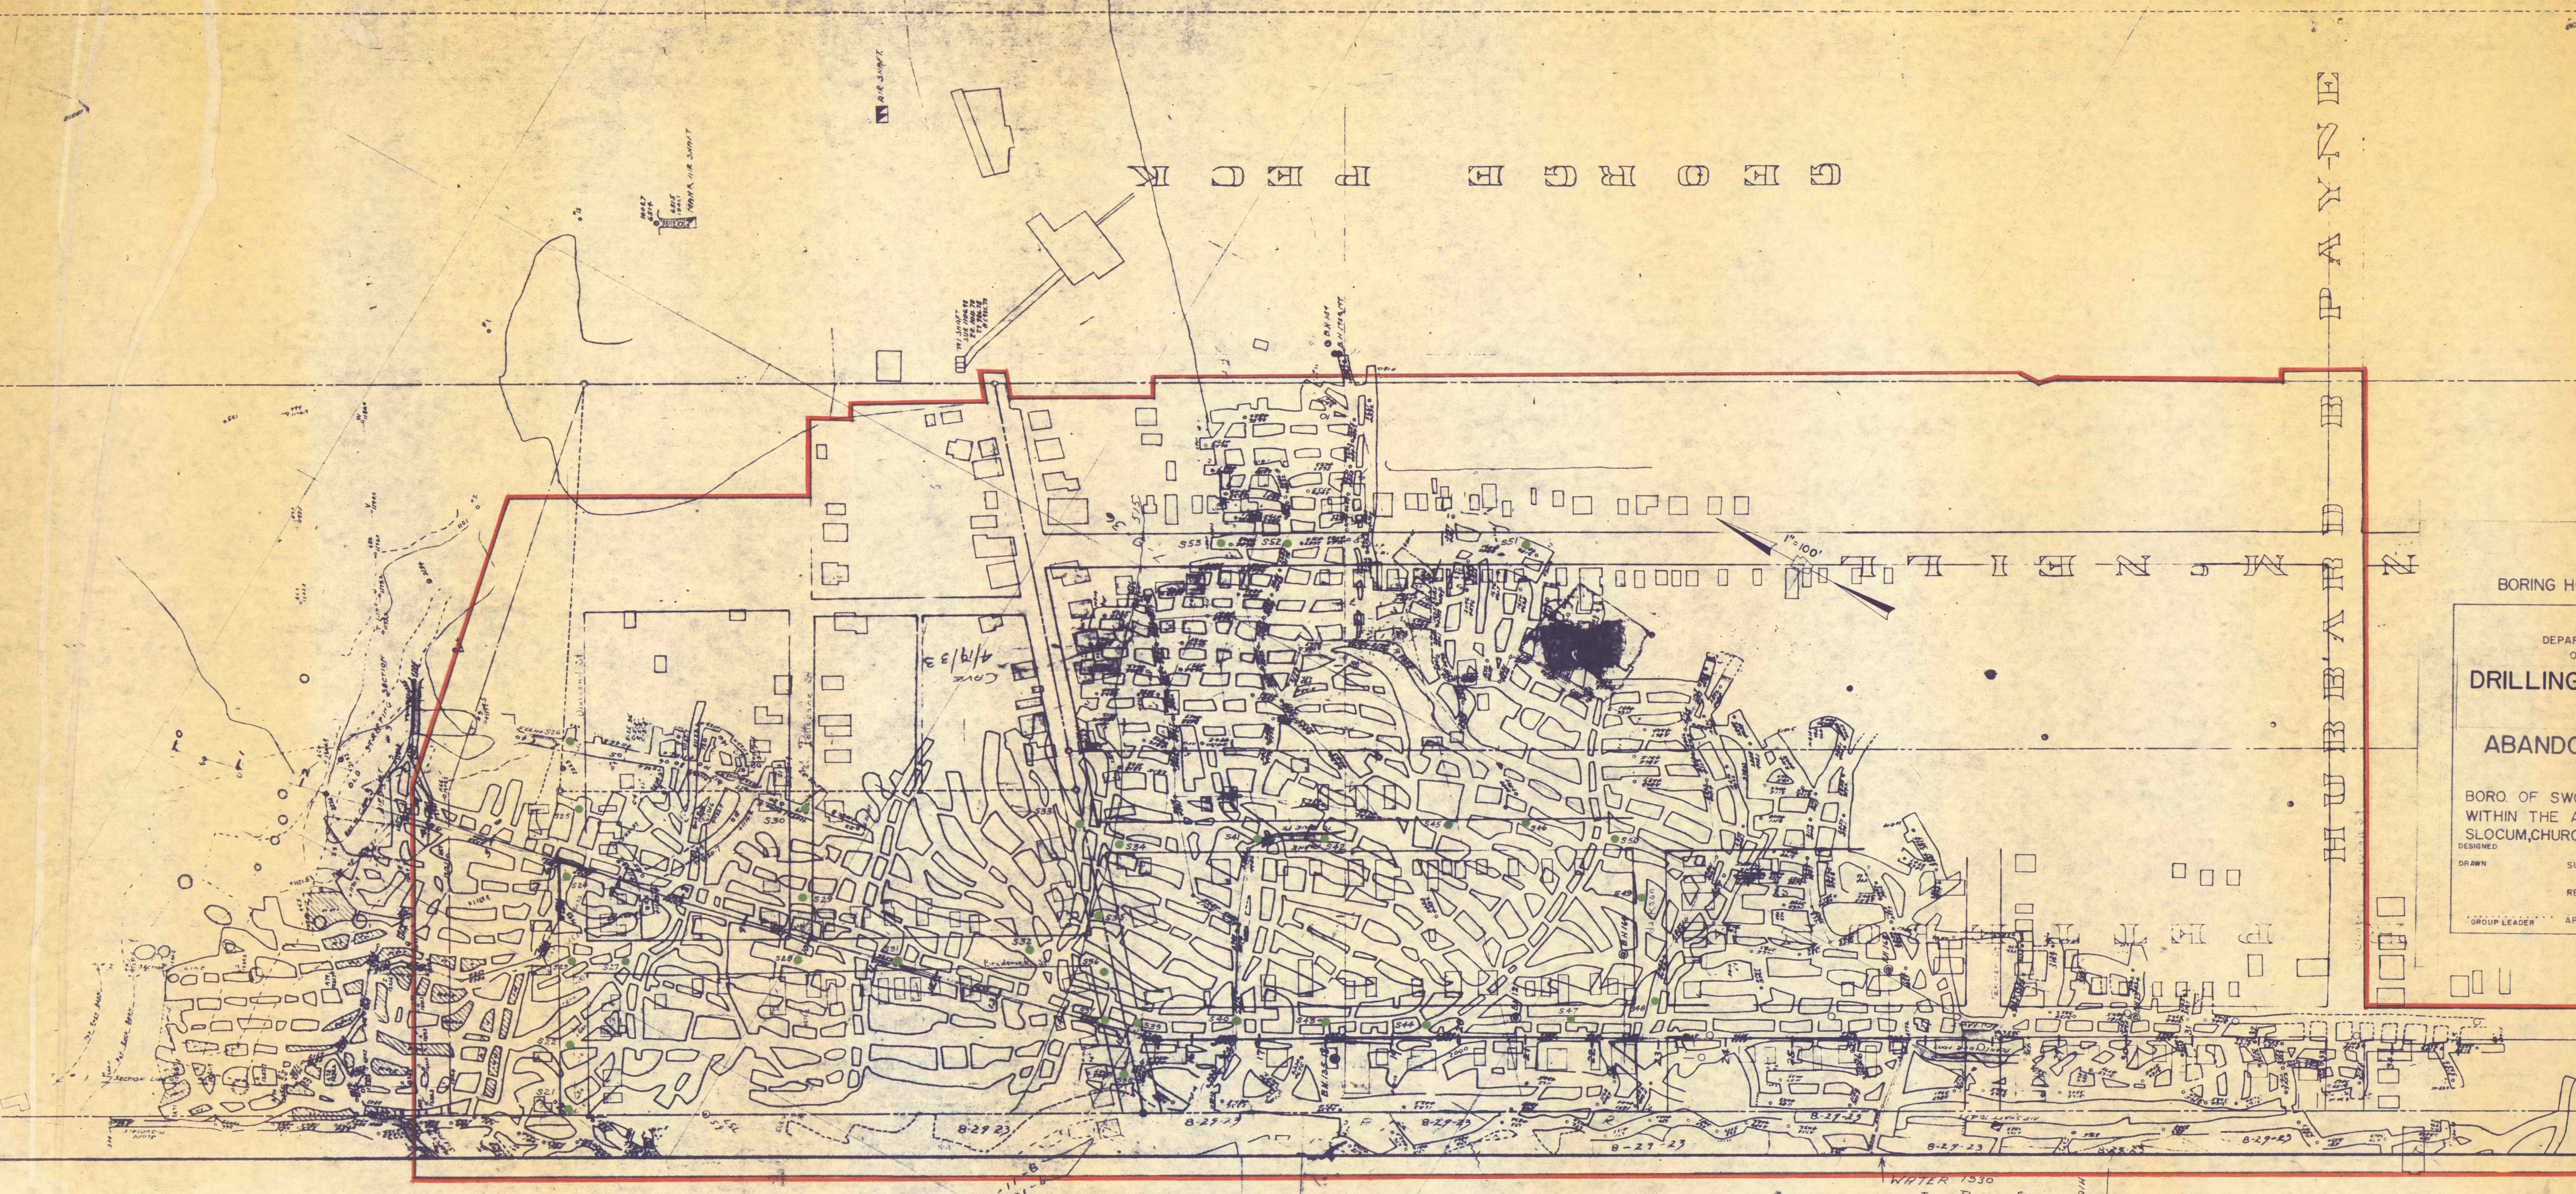

LEGEND

BORING HOLES THIS CONTRACT NO.FE40:7

COMMONWEALTH OF PENNSYLVANIA
 DEPARTMENT OF ENVIRONMENTAL RESOURCES
 OFFICE OF RESOURCES MANAGEMENT

**DRILLING & CASING EXPLORATORY
 BOREHOLES**

**ABANDONED HARRY E. COLL'Y
 SIX FOOT VEIN**

BORO. OF SWOYERSVILLE
 WITHIN THE AREAS OF DIAMOND,
 SLOCUM, CHURCH, OLIVER, STREETS.

LUZERNE COUNTY
 PENNSYLVANIA

DESIGNED	SUBM.	DISTRICT ENGINEER
RECOM.	APPR.	DIRECTOR BUREAU OF CONST.
GROUP LEADER		DEPUTY SECRETARY OF RESOURCES MANAGE.
		DATE

DWG. NO.FE40:7-1-3

 300 JOHN DALEY ST
 1023/31

8-29-23
 8-29-23
 8-29-23
 8-29-23